SURVEY OF
DESCRIBED PROPERTY
SITUATE AT
WATER MILL
TOWN OF SOUTHAMPTON
SUFFOLK COUNTY, NEW YORK
S.C.T.M. DIST. 0900 SEC. 81 BLK. 01 LOT 7

30 15 0 30 60 90 120 150 180 210 240 270

SCALE: 1" = 60'

DATE: APRIL 5, 2011

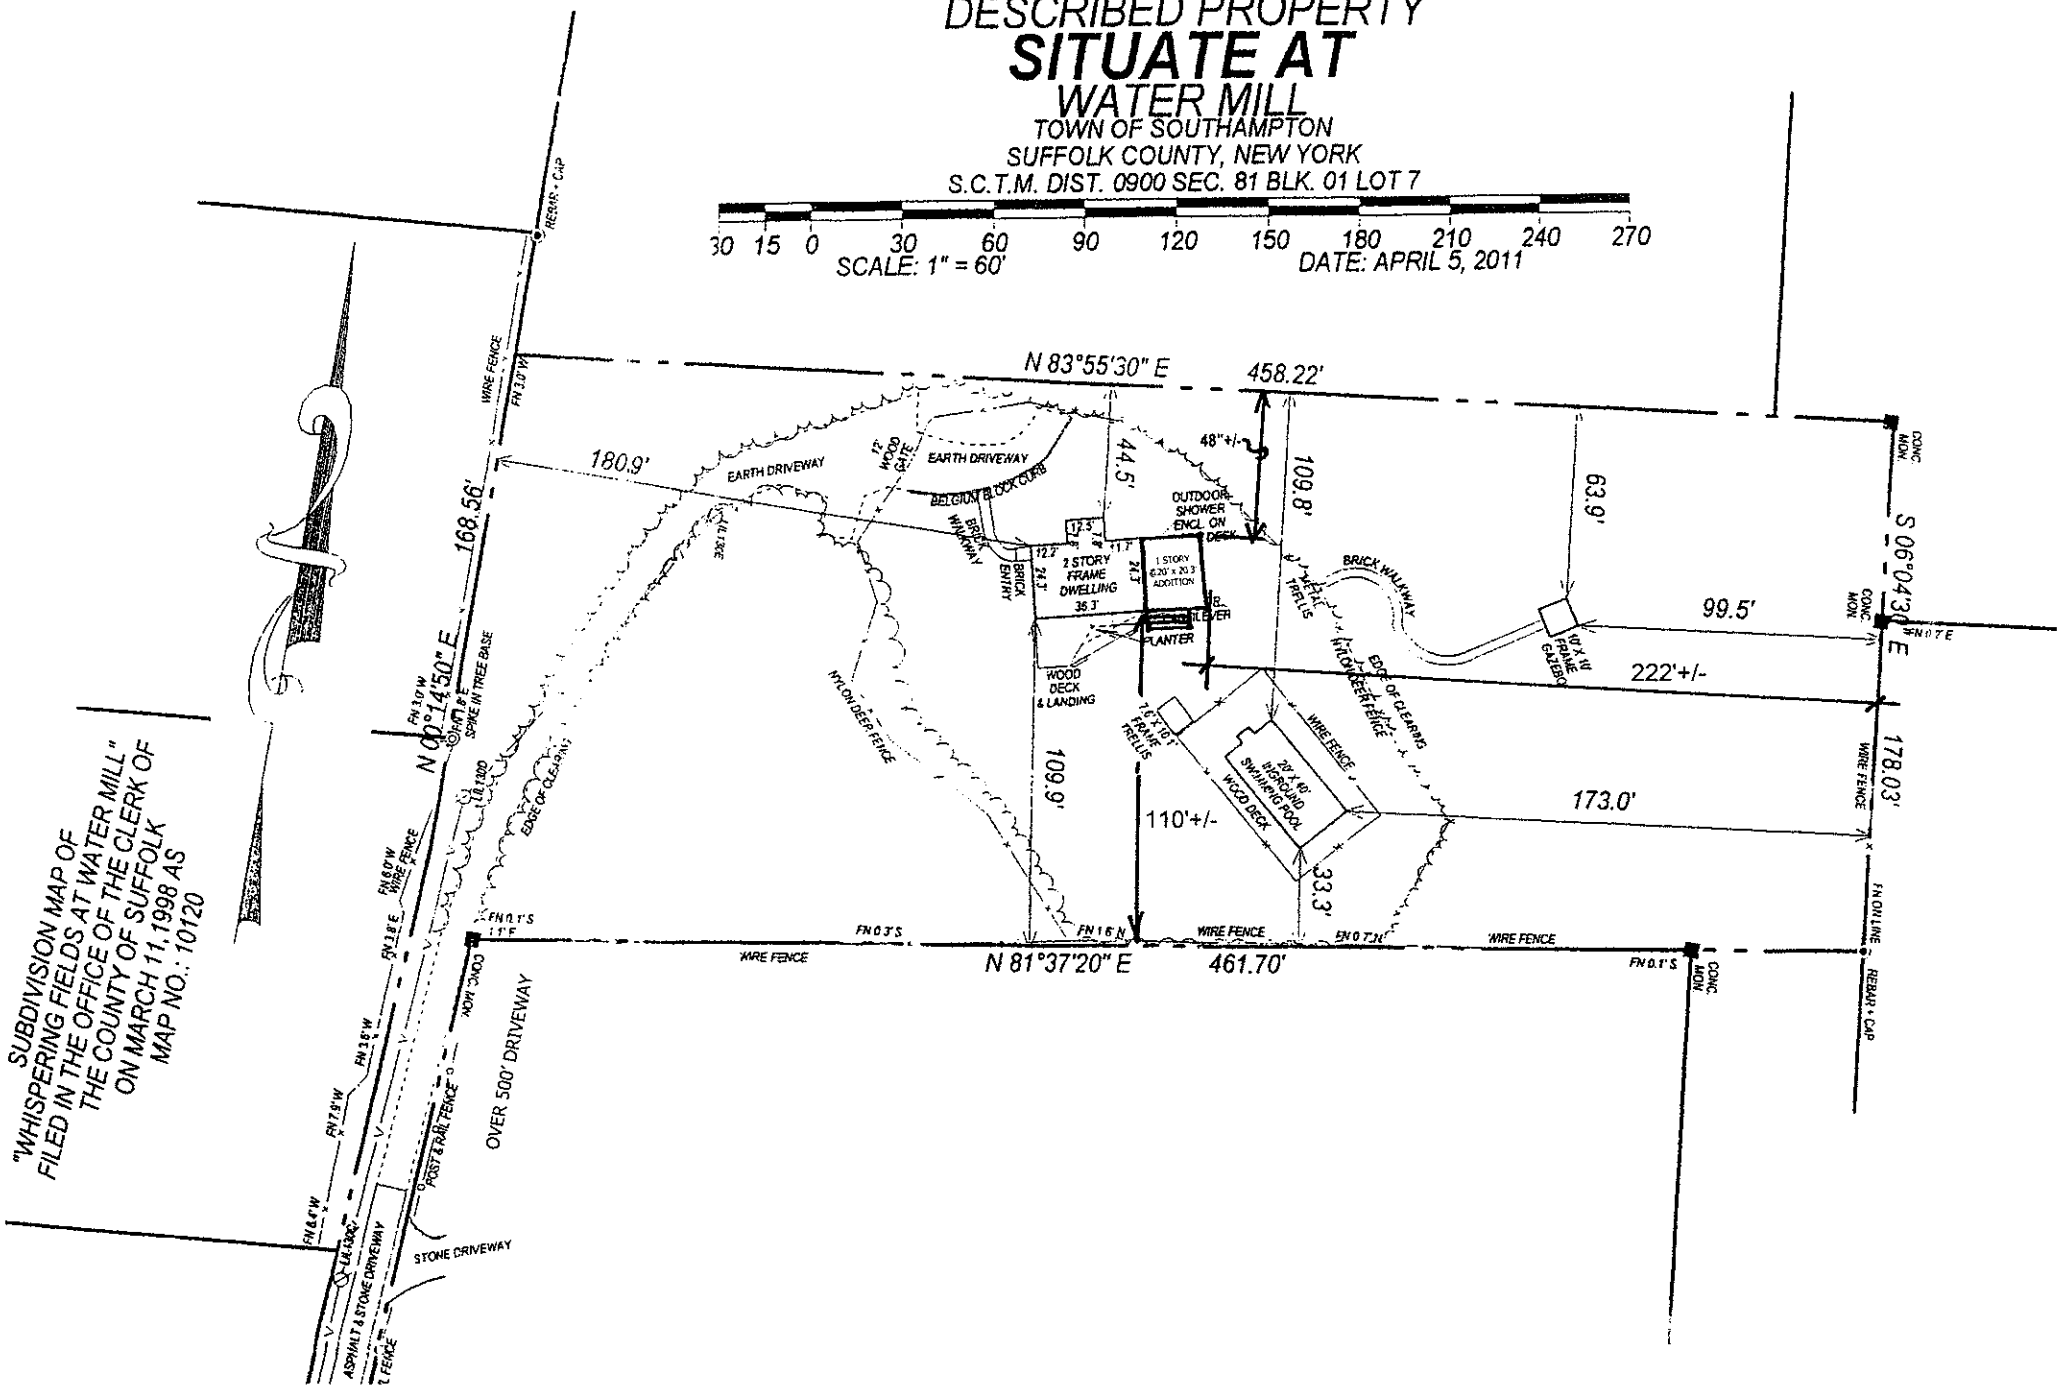

SUBDIVISION MAP OF
"WHISPERING FIELDS AT WATER MILL"
FILED IN THE OFFICE OF THE CLERK OF
THE COUNTY OF SUFFOLK
ON MARCH 11, 1998 AS
MAP NO.: 10120