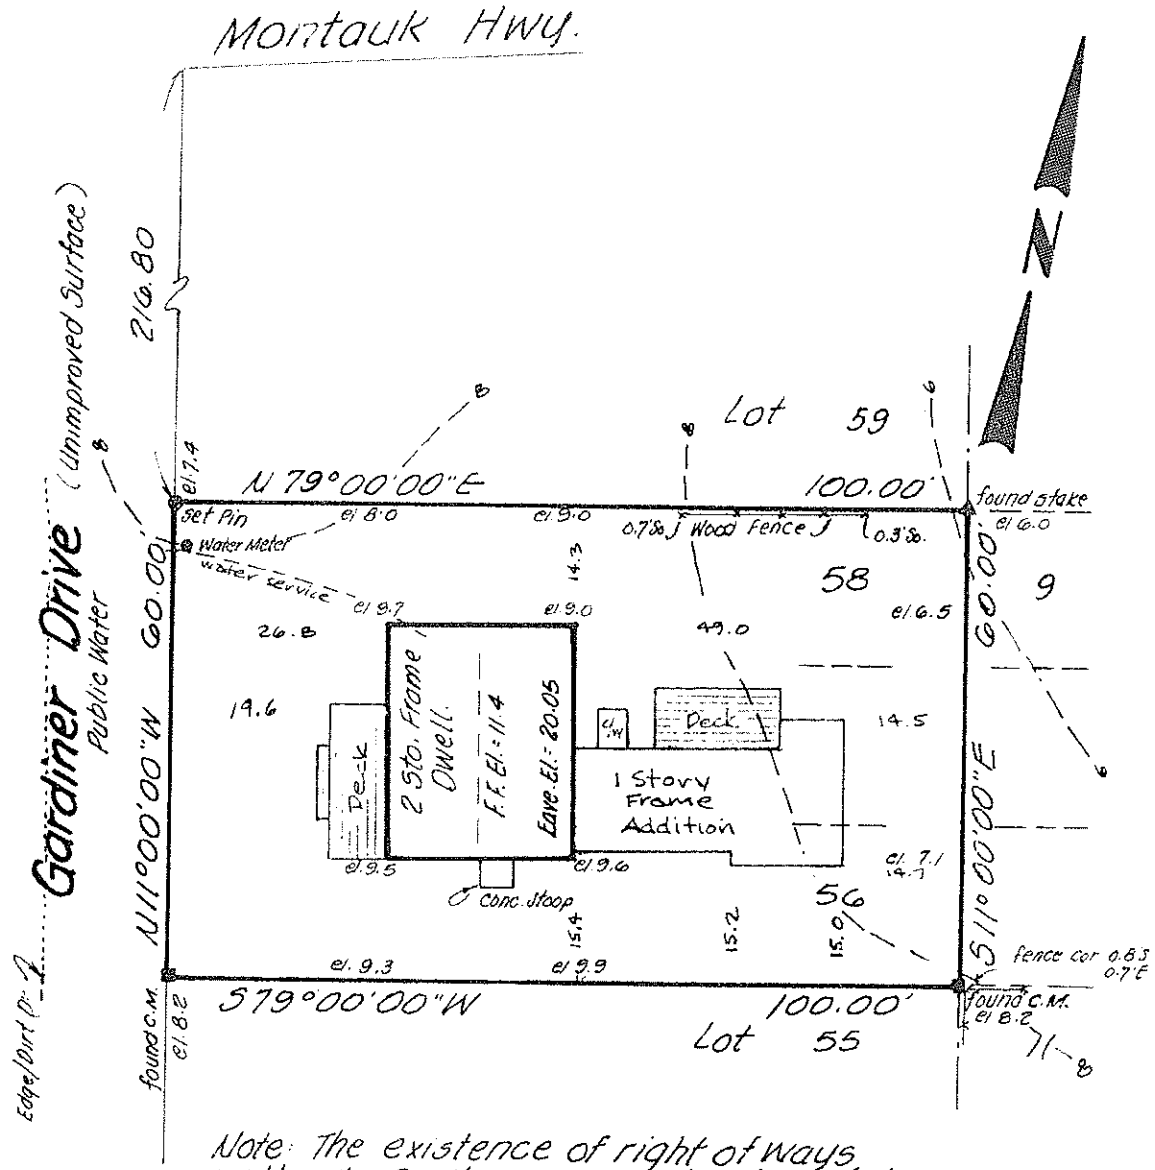

Note: The existence of right of ways, wetlands, and/or easements of record, if any, not shown are not guaranteed.

U.S.G.S. Datum

Lots 56-58 incl. ~ Block 10
Map of
Beach Hampton-Sect. 1
Filed May 13, 1956 - Map 1203
Town of East Hampton - Suffolk Co., N.Y.

Scale: 1" = 20'

State of New York
CHARLES R. KANE
No. 37720
Licensed Land Surveyor

Revised: May 21, 1986 - final - Add.
Surveyed: July 8, 1985

GEORGE H. WALBRIDGE CO.
Land Surveyors & Land Planners
East Hampton - Long Island - N.Y.