


SCTM No. 301-004

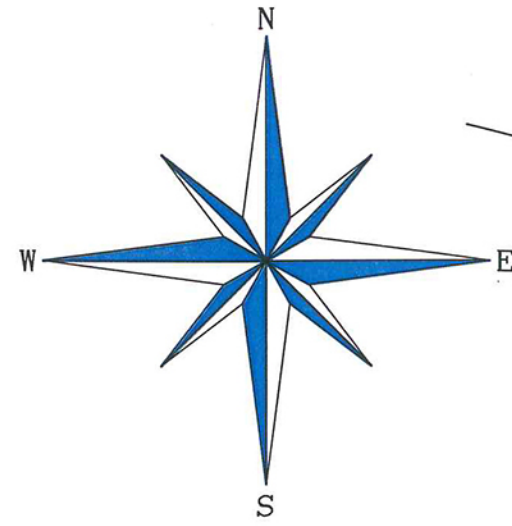

Land Now or Formerly of Shirley M. Collins


Land Now or Formerly of Stuart E. & Anna Marie Nassauer

Toilsome Lane

Land Now or Formerly of Jocelyn C. Palmer

Land Now or Formerly of Mary Grace Mullen

Church Lane

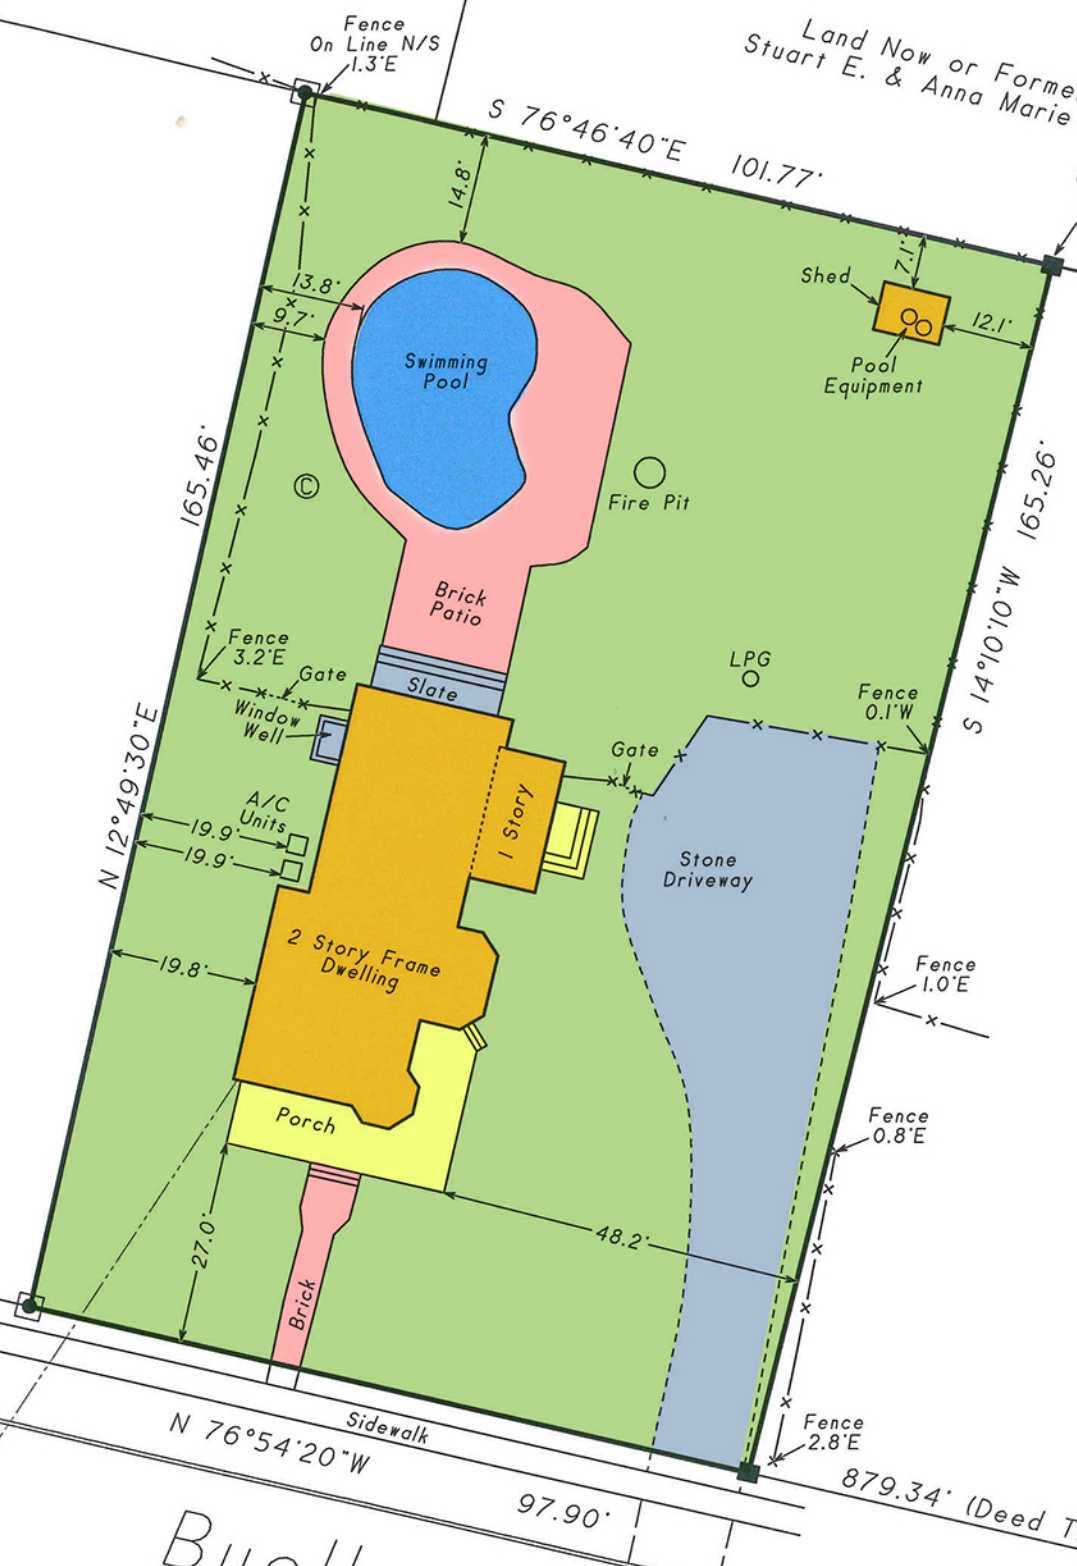

S 76°54'20"E 144.90'

N 12°49'30"E 165.46'

S 76°46'40"E 101.77'

S 14°10'10"W 165.26'

N 76°54'20"W 97.90'

879.34' (Deed Tie)

Buells Lane (SR 114)

Curb

Sidewalk

Brick

Porch

2 Story Frame Dwelling

1 Story

Slate

Brick Patio

Swimming Pool

Pool Equipment

Shed

Fire Pit

LPG

Stone Driveway

Gate

Gate

Fence 3.2'E

Fence 0.1'W

Fence 1.0'E

Fence 0.8'E

Fence 2.8'E

Fence On Line N/S 1.3'E

Fence 0.2'N 0.3'W

165.46'

N 12°49'30"E

19.9'

19.9'

19.8'

27.0'

48.2'

97.90'























