


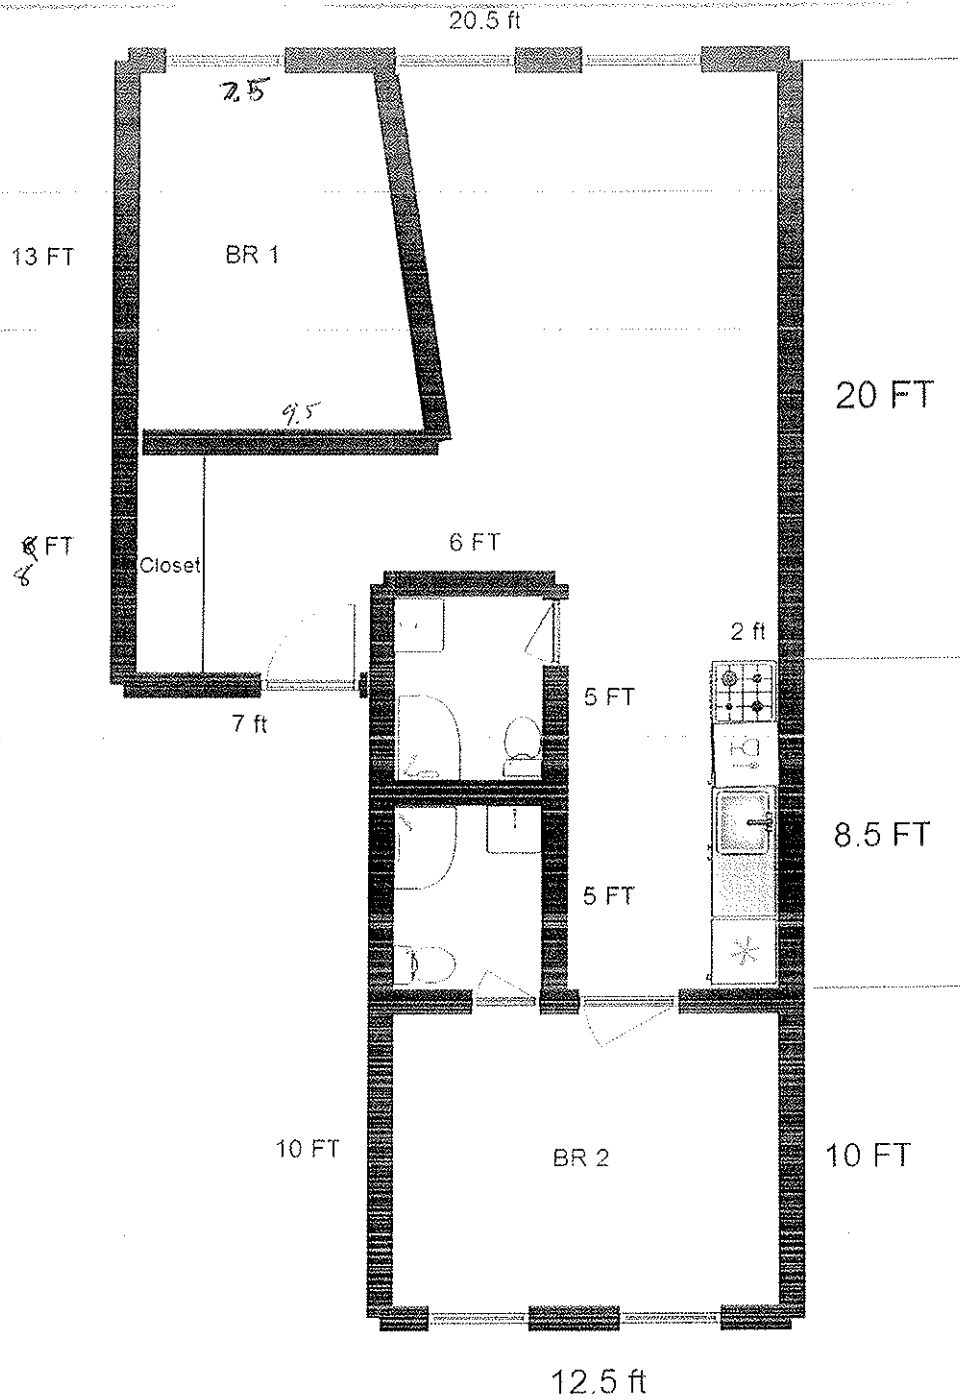

245 Bleecker Street
Apartment # 2
3rd Floor

0ft

12ft

24ft