


SITUATE

Town Of East Hampton, Suffolk Co., N.Y.

Area: 35,012 S.F. or 0.804 Acres
Lot Area: 31,229 S.F. or 0.717 Acres (Excl. R.O.W)

Katherine H. Miller

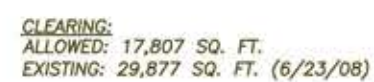

- 1). Unauthorized alteration or addition to a survey map bearing a licensed surveyors seal is a violation of section 7209 of the New York State Education Law.
- 2). Only copies from the original of this survey map bearing an original land surveyor's inked seal or embossed seal shall be considered to be a valid copy.
- 3). Certifications indicated hereon shall run only to the person for whom the survey is prepared, and on his/her behalf to the title company, governmental agency and lending institution listed hereon. Certifications are not transferable to additional institutions or subsequent owners. Certifications indicated hereon signify that this survey was prepared in accordance with the existing code of practice for land surveyors adopted by the New York State Association of Professional Land Surveyors.
- 4). The existence of subsurface improvements or encroachments, or wetlands, or easements, covenants, or restrictions of record, if any, not shown are not certified.

Revised: August 7, 2015 - Adjoining Property Lines
 Revised: June 23, 2015 - Update Fence & Relocate CM(s)
 Revised: June 23, 2008 - Set CM
 Surveyed: April 25, 2008

te: (631) 324-0412 Fax: (631) 324