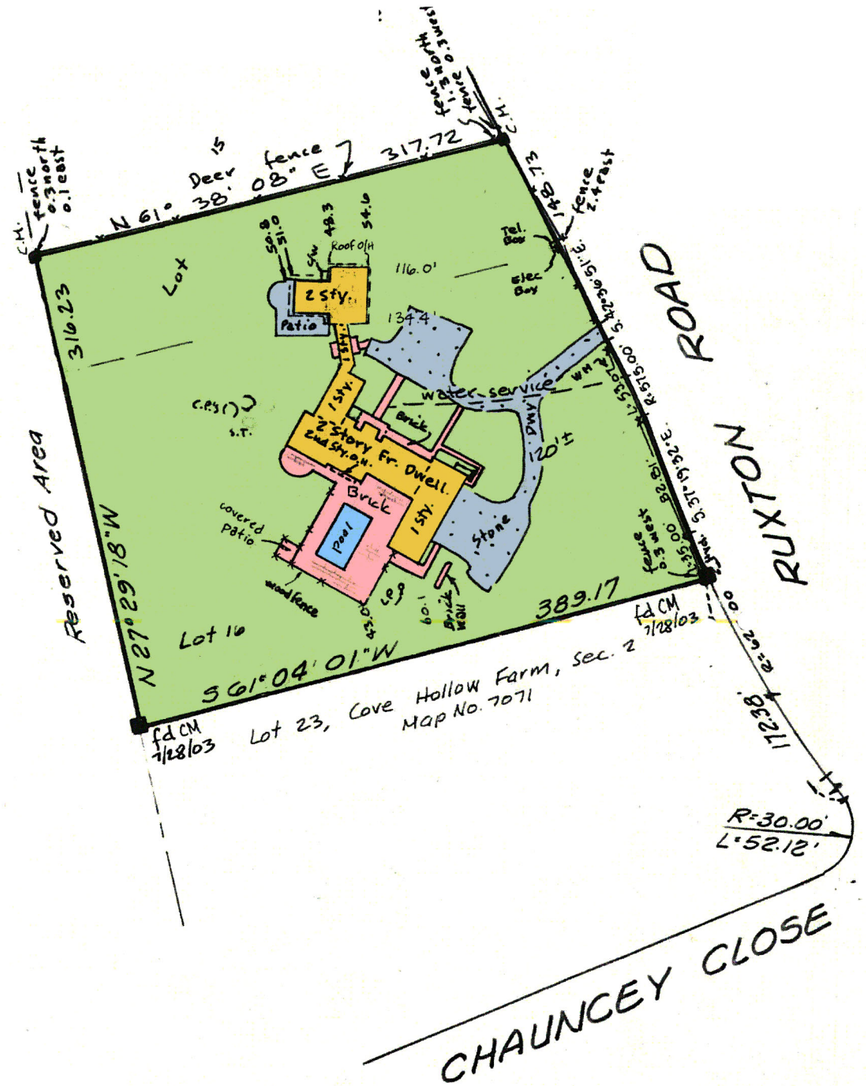

N 61° 38' 08" E
317.72
Deer fence
fence 0.3 north 0.1 east
fence 1.3 north
fence 0.3 west
fence 2.4 east
148.73
Tel. Box
Elec Box
Roof O/H
116.0'
134.4'
2 Sty.
Patio
Lot
316.23
1 Sty.
2 Story Fr. Dwell.
Brick
Pool
covered Patio
wood fence
Stone
Brick Wall
water service
120'±
Dwy
Reserved Area
N 27° 29' 18" W
Lot 16
S 61° 04' 01" W
389.17
fd CM 7/28/03
Lot 23, Cove Hollow Farm, Sec. 2
Map No. 7071
172.38'
R=30.00'
L=52.12'
RUXTON ROAD
CHAUNCEY CLOSE