


EXISTING SINGLE FAMILY RESIDENCE

3200 COX NECK ROAD MATTITUCK, NY

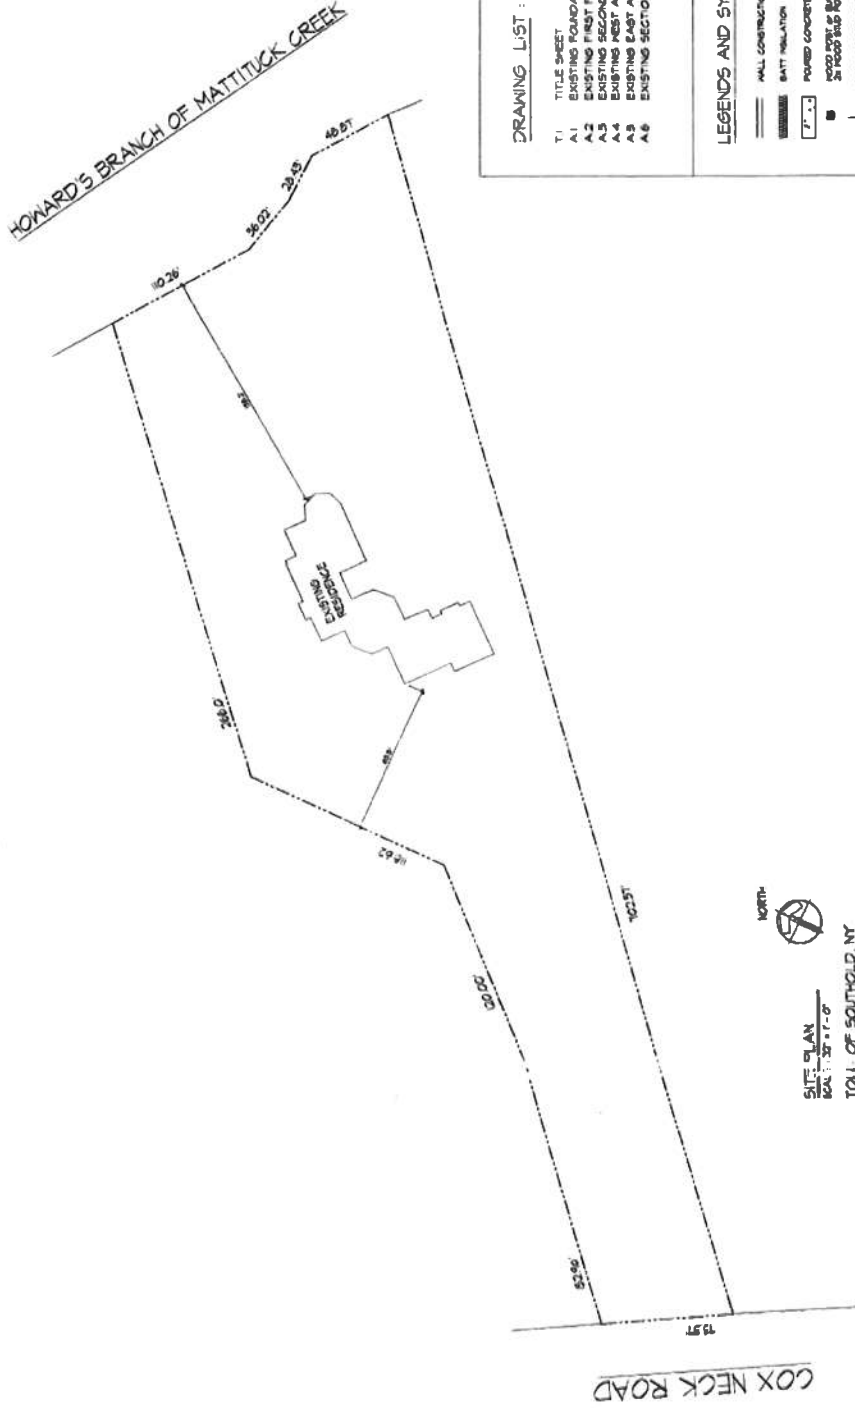

NORTH
 SITE PLAN
 SCALE: 1/8" = 1'-0"
 TOWN OF SOUTHOLD, NY
 TAD MAP NO. 1000-15-08-P-03

BY: J.A.N. INFORMATION FROM
 SA: J.A.N. BY: WILLIAM R. SHIMONE II, L.S.P.C.
 DATE: NOV. 4, 2009

DRAWING LIST:

- T.1 TITLE SHEET
- A.1 EXISTING FOUNDATION PLAN
- A.2 EXISTING FIRST FLOOR PLAN
- A.3 EXISTING SECOND FLOOR PLAN
- A.4 EXISTING WEST AND SOUTH ELEVATIONS
- A.5 EXISTING EAST AND NORTH ELEVATIONS
- A.6 EXISTING SECTIONS


LEGENDS AND SYMBOLS:

- WALL CONSTRUCTION
- ▨ BATT INSULATION
- POURED CONCRETE
- FLOOR SLAB ON GRADE
- FLOOR SLAB ON GRADE
- DRAWING SECTION SYMBOL
- SECTION REFERENCE NUMBER
- DRAWING DETAIL SYMBOL
- DETAIL REFERENCE NUMBER
- DOOR SYMBOL
- DOOR SIZE (1'-2" x 6'-0")
- NEW DUPLEX BLOC OUTLET
- NEW GROUND FAULT CIRCUIT INTERRUPTER OUTLET
- NEW DECK HOISTED OUTLET
- SWITCH
- SWITCH WITH DIMMER
- FAN CONTROL SWITCH
- 3 WAY SWITCH
- 4 WAY SWITCH
- CEILING HOISTED
- DOUBLE BLOC OUTLET
- DIMMER
- PERMANENT TYPE LIGHT OR CHANDELIER
- RECESSED LIGHT FIXTURE

NOTE:
 THIS PLAN IS A PRELIMINARY DESIGN. ALL FIELD
 CONSTRUCTION SHALL BE IN ACCORDANCE WITH THE
 CITY OF SOUTHOLD, NY ZONING ORDINANCES AND
 THE TOWN OF SOUTHOLD, NY TAD MAP NO. 1000-15-08-P-03.
 THE CONTRACTOR SHALL BE RESPONSIBLE FOR OBTAINING
 ALL NECESSARY PERMITS AND APPROVALS FROM THE
 APPROPRIATE AGENCIES.

NO. REVISIONS NO. DATE	DATE	TITLE SHEET 3200 COX NECK ROAD MATTITUCK, NY EXISTING TWO STORY RESIDENCE	SHEET NO. A.1

DATE: 8-9-07		PROJECT: 08-01-07	
DESIGNED BY: [Redacted]		CHECKED BY: [Redacted]	

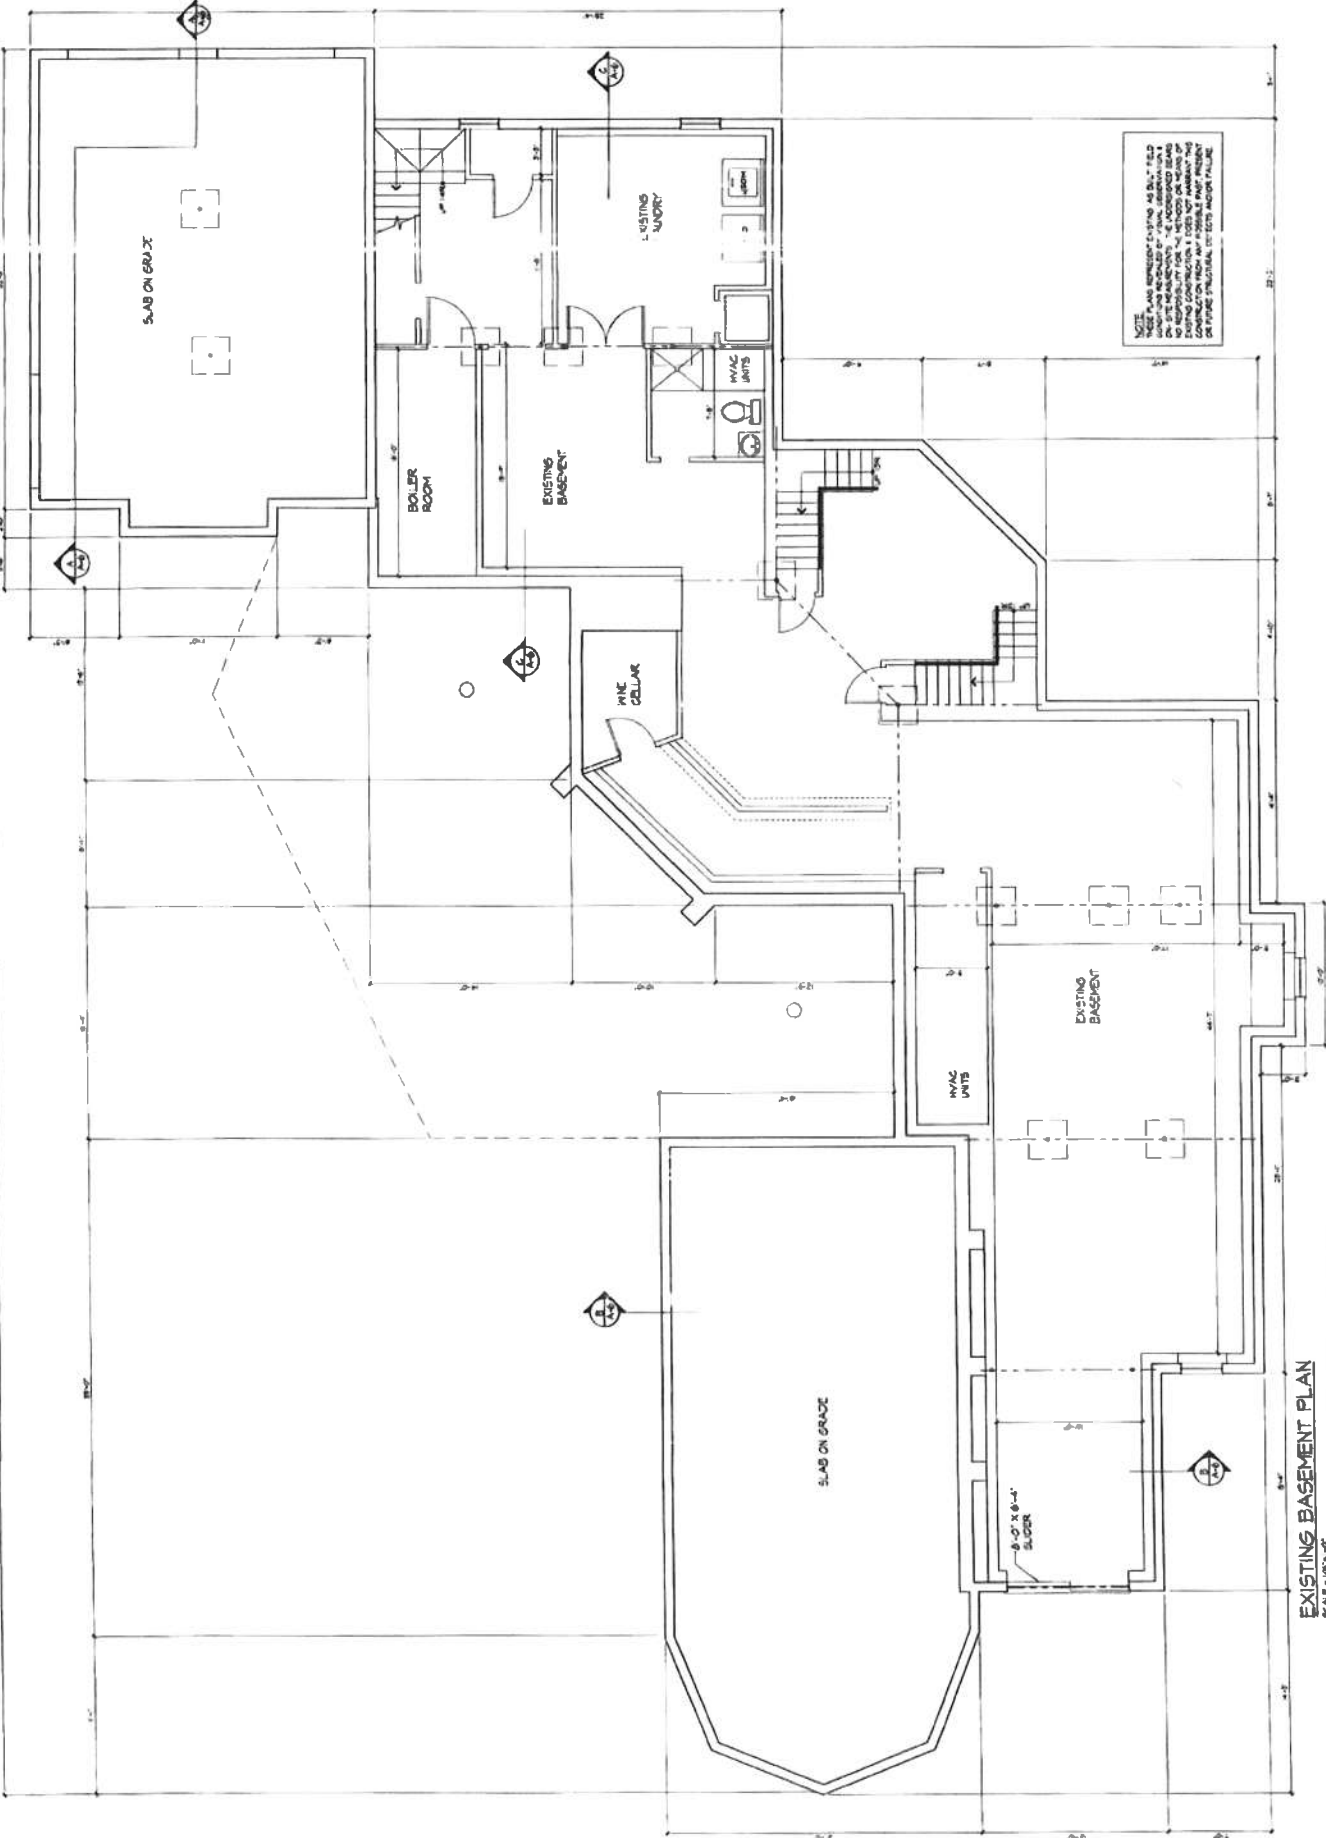


EXISTING BASEMENT PLAN


SCALE: 1/8" = 1'-0"

DANIEL KELLEY, AIA
ARCHITECT

100 NEW YORK AVENUE, HARTFORD, CT 06103
TEL: 860-425-0025 FAX: 860-425-0026


PROJECT: EXISTING TWO STORY RESIDENCE

Sheet No. **A.3**

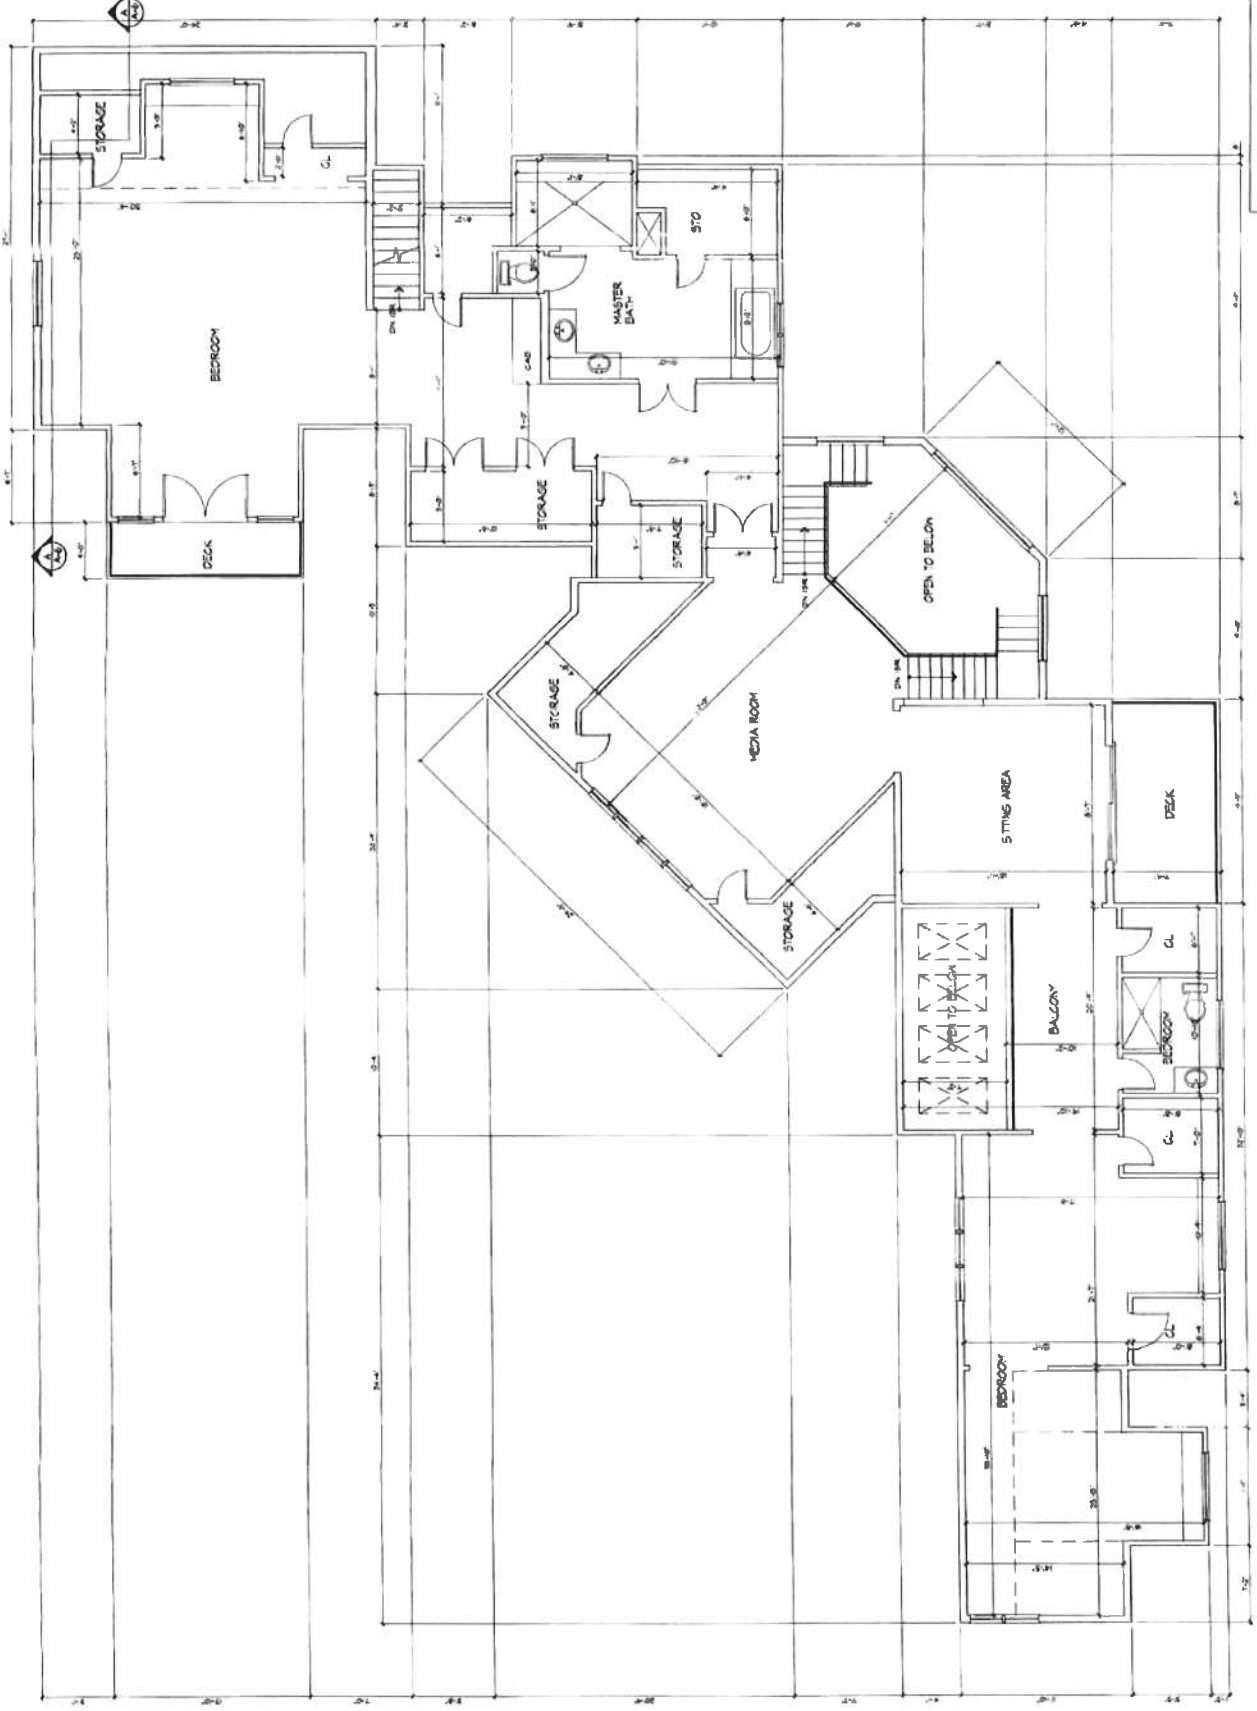


NOTE:


EXISTING SECOND FLOOR PLAN
SCALE: 1/8" = 1'-0"
DATE: 08-11-11

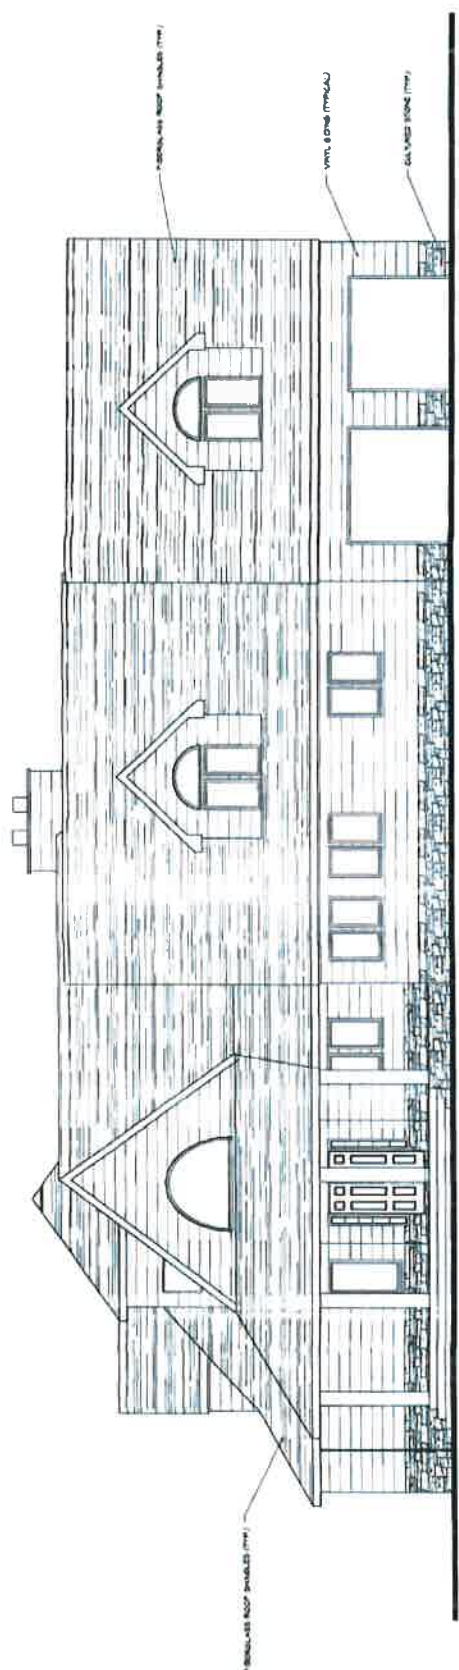


EXISTING WEST ELEVATION
 SCALE - 1/8" = 1'-0"

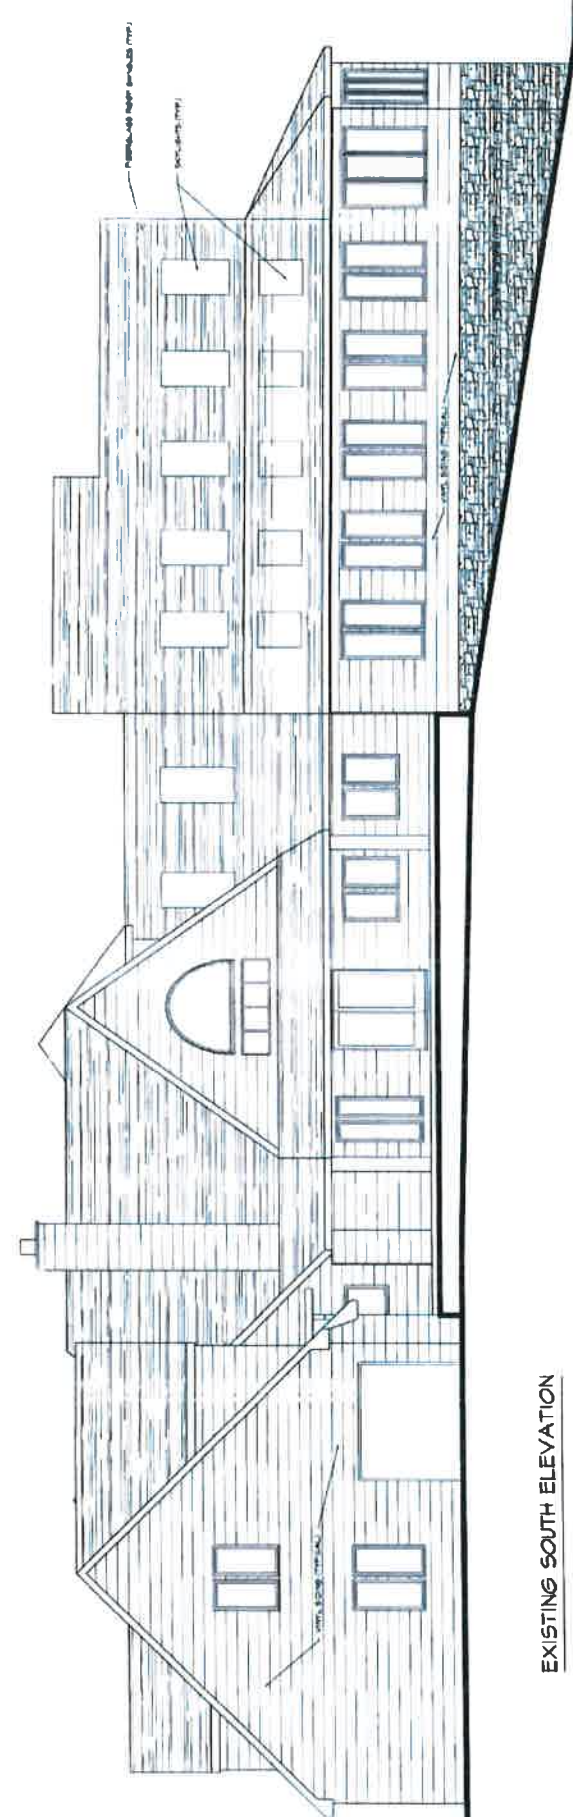


EXISTING SOUTH ELEVATION
 SCALE - 1/8" = 1'-0"

NOTE

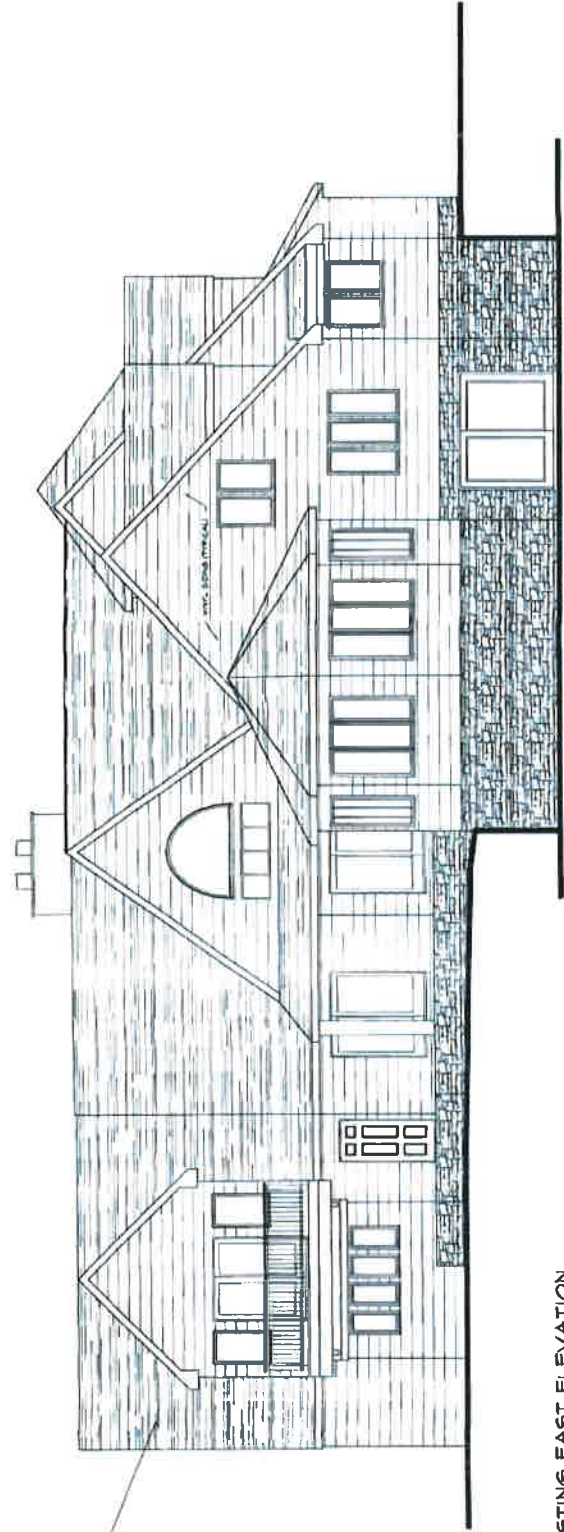

EXISTING EAST ELEVATION
SCALE - 1/4"=1'-0"

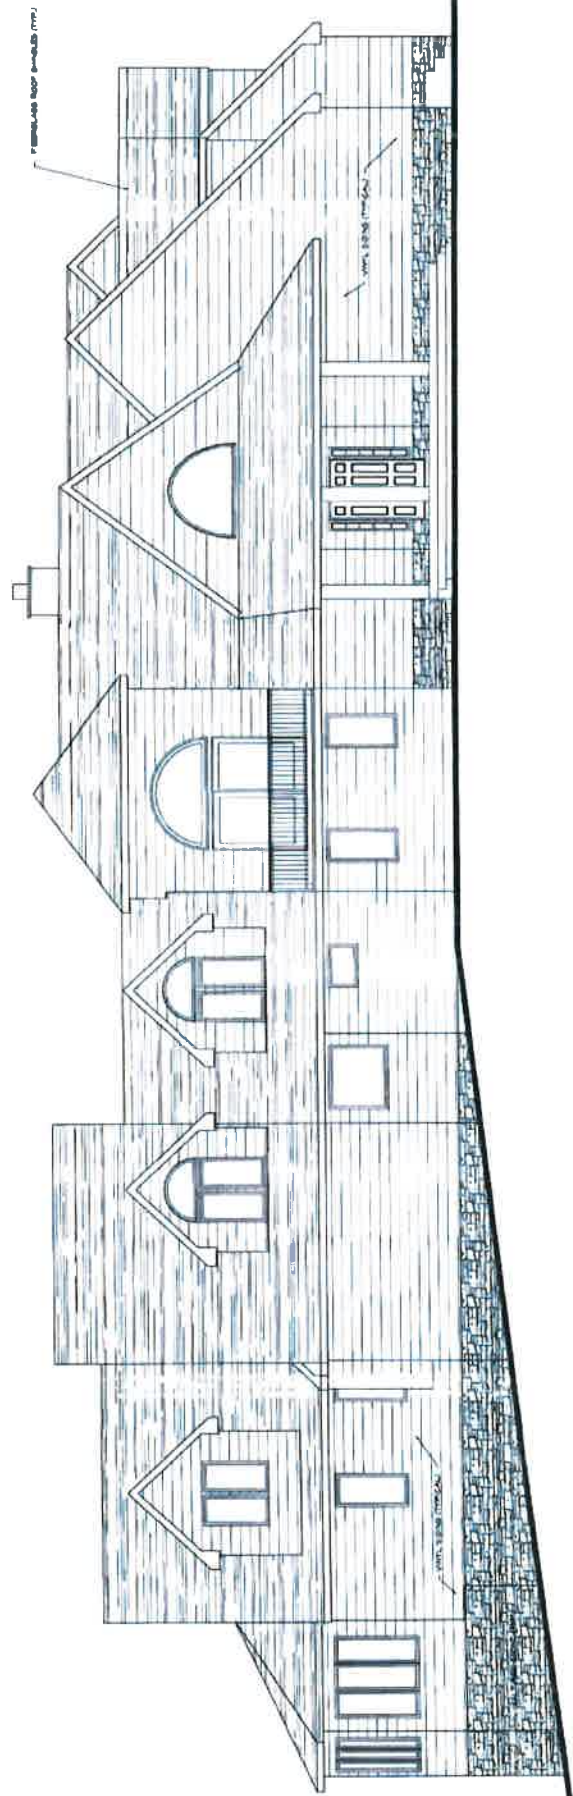

EXISTING NORTH ELEVATION
SCALE - 1/4"=1'-0"



DANIEL KELLEY, AIA
ARCHITECT
171 NEW YORK AVENUE HARTFORD, CT 06103
TEL: 860-232-9288 FAX: 860-429-9288

DATE: 8-11-11
SCALE: AS NOTED
PROJECT: 08-0-5







EXISTING TWO STORY RESIDENCE
2300 COX HECK ROAD
MANTIC, NY

Sheet No. **A.6**



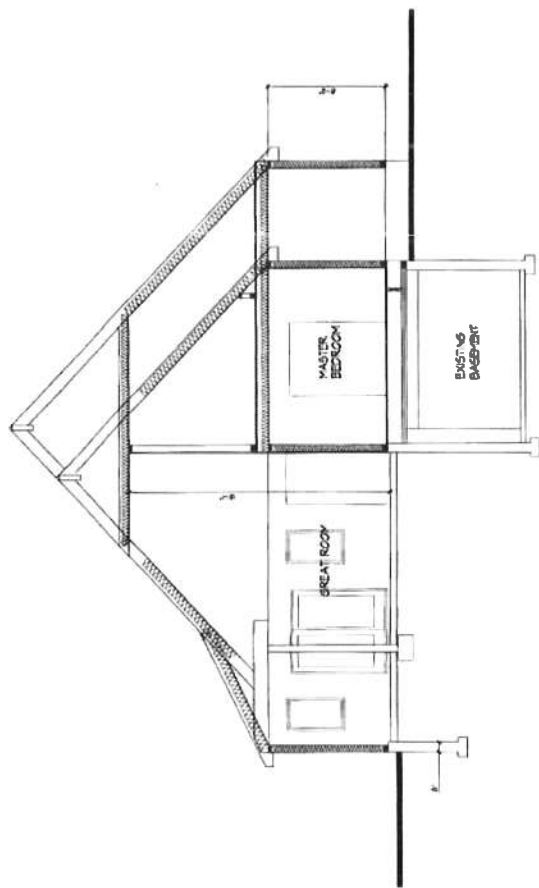

EXISTING SECTION
SCALE - 1/8" = 1'-0"

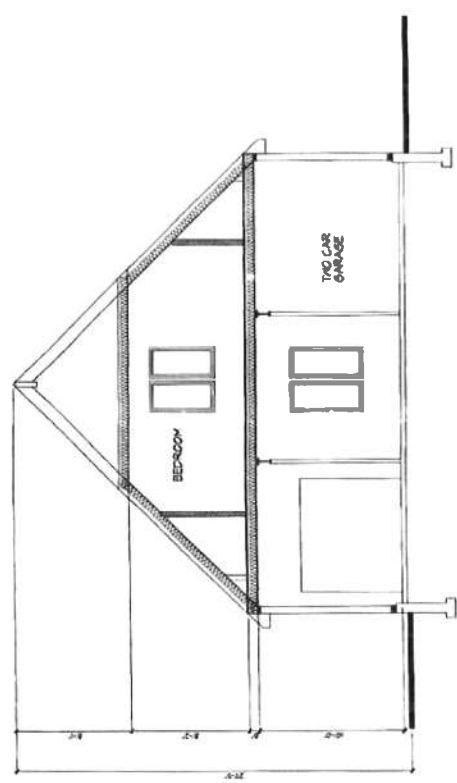

EXISTING SECTION
SCALE - 1/8" = 1'-0"

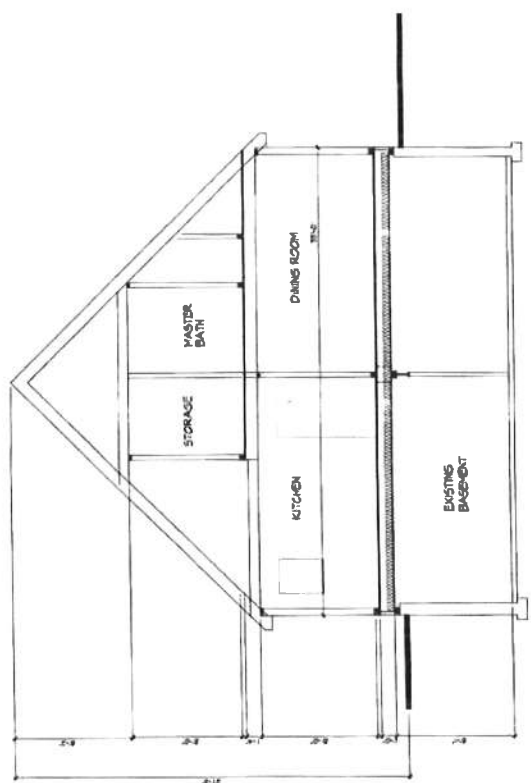

EXISTING SECTION
SCALE - 1/8" = 1'-0"