


LOT AREA: 26,250 SQ.FT. = 0.603 ACRE
ELEVATIONS HEREON REFER TO APPROX NAVD

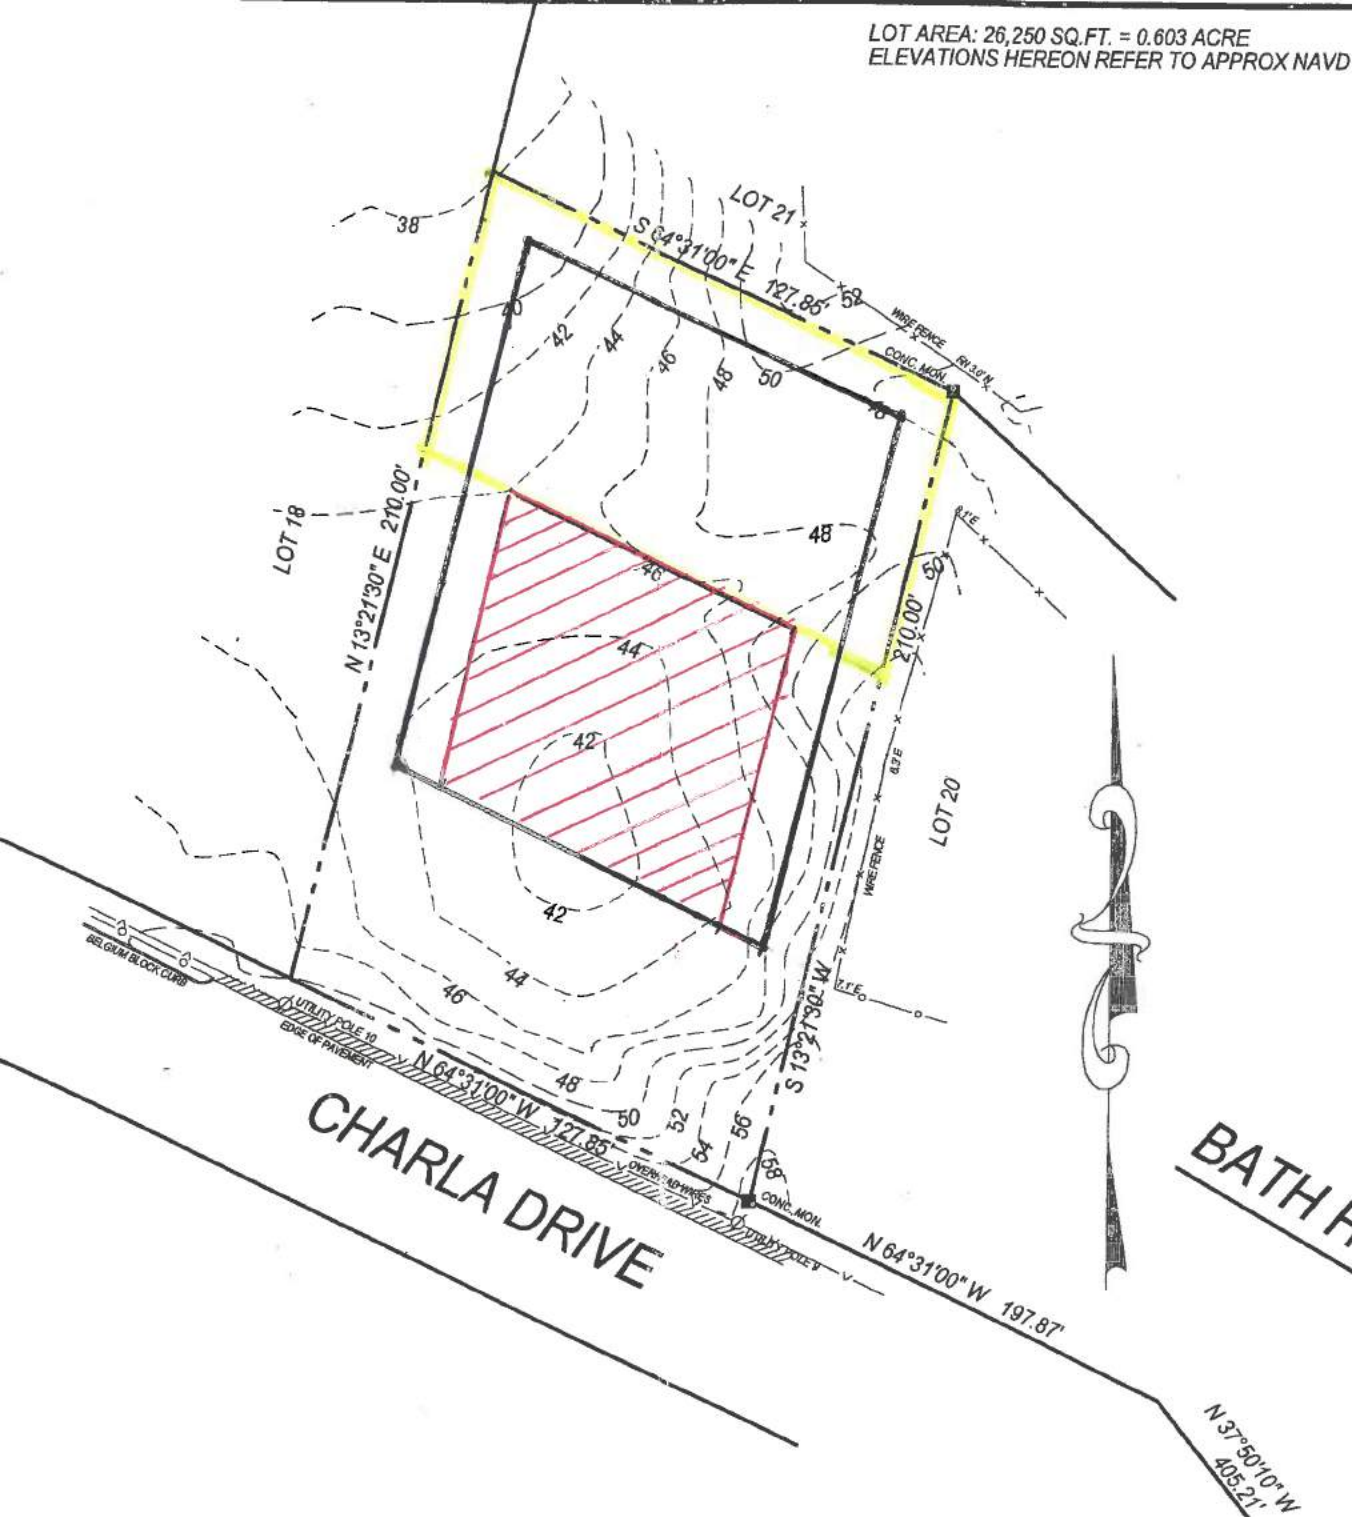

CHARLA DRIVE

BATH H