


Tax Map No. 900-077-03-35  
Area = 23,953 s.f.  
Zone R-60

Refer to Documents Recorded in  
Suffolk County Clerk's Office

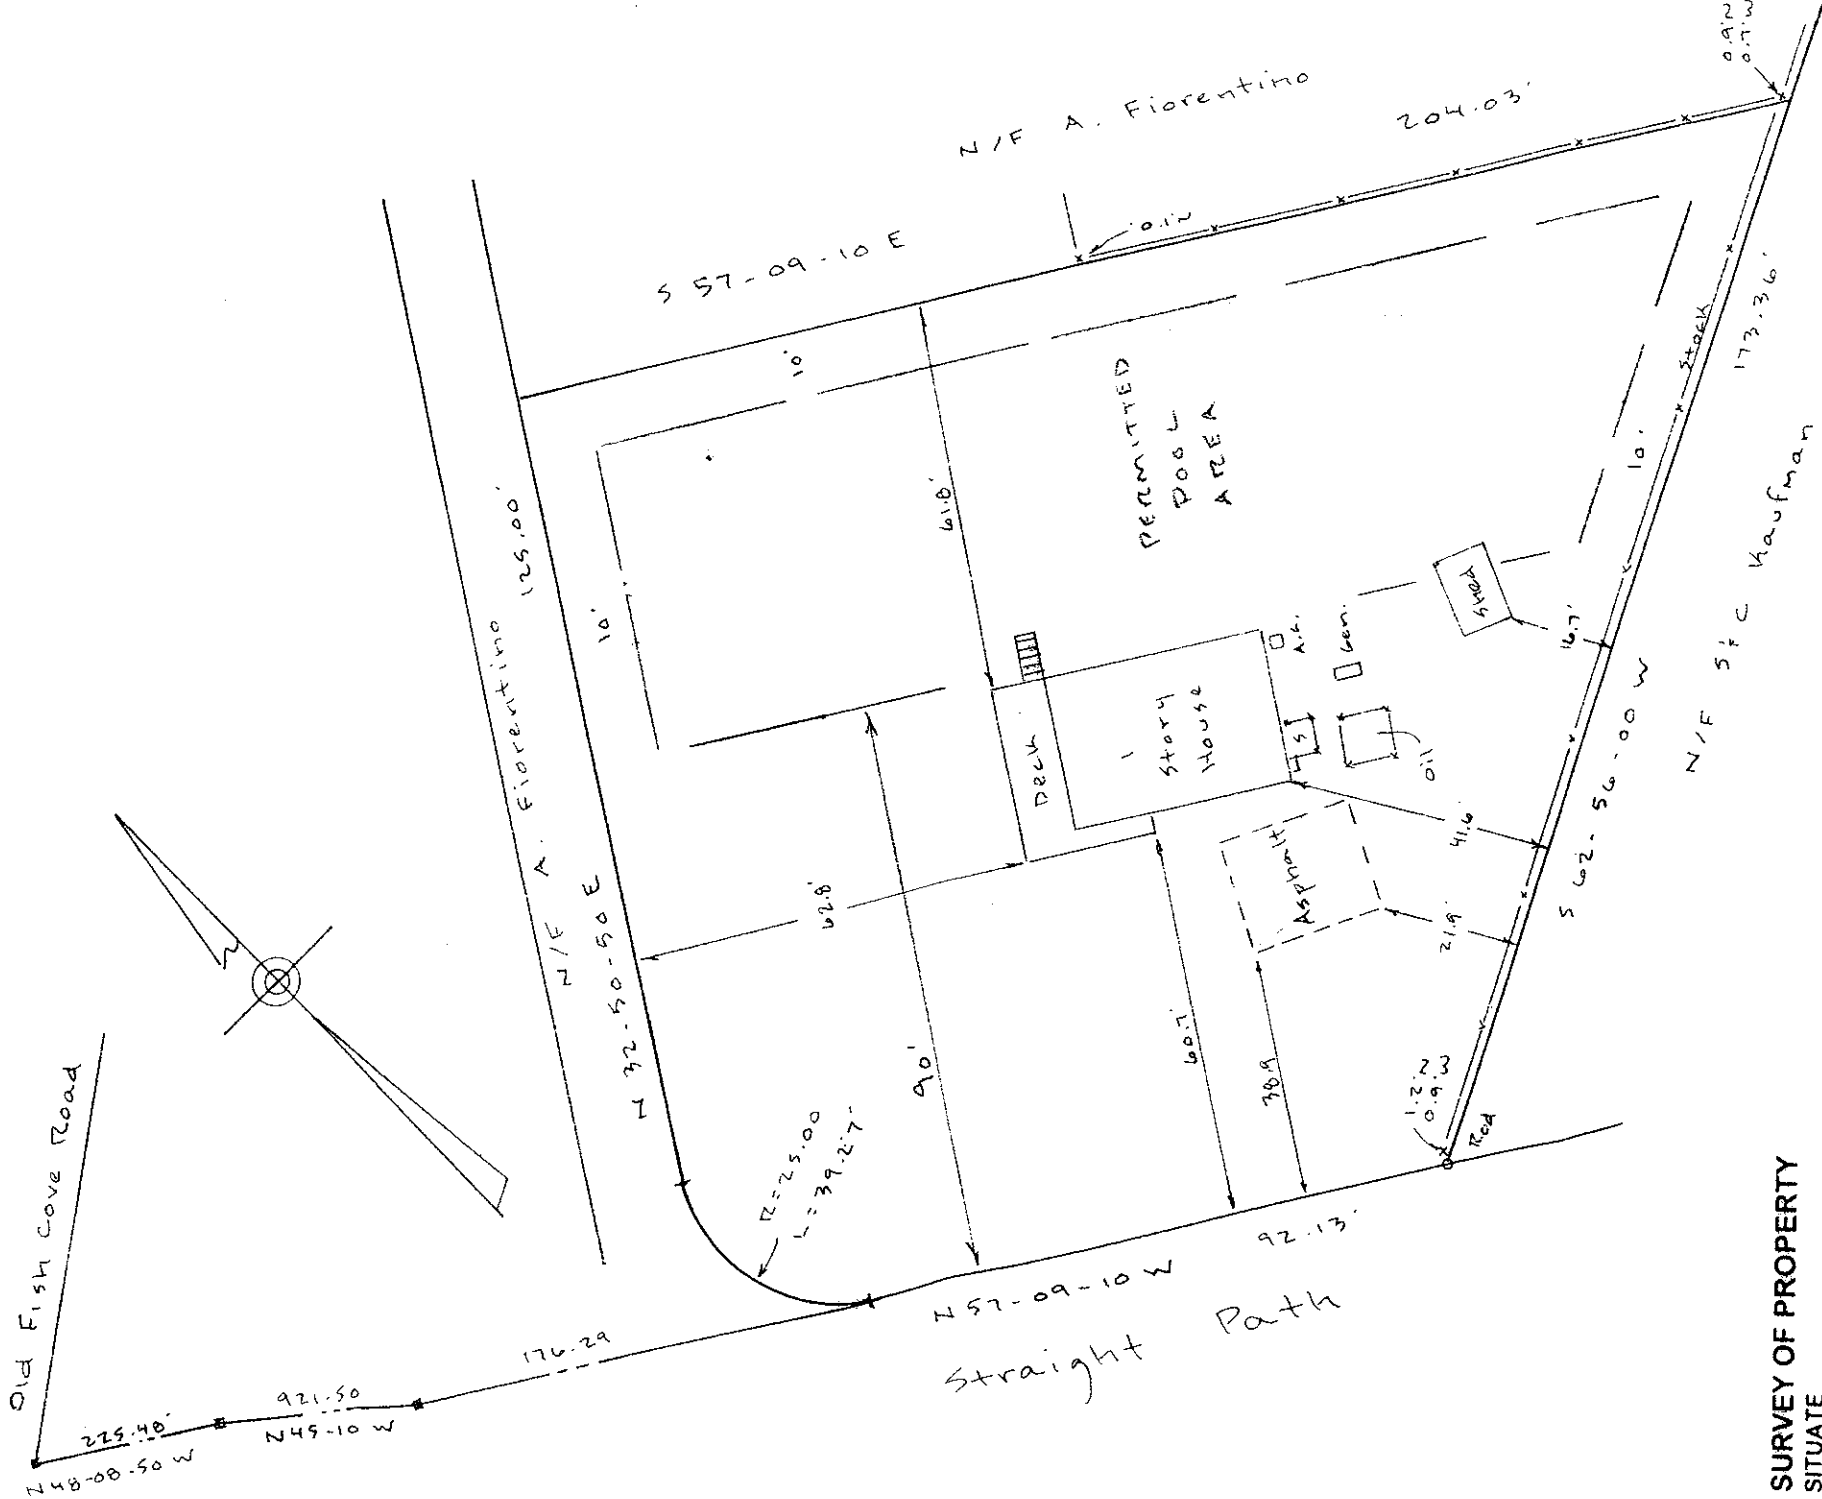

SURVEY OF PROPERTY  
SITUATE

No. 64  
Straight Path  
North Sea

TOWN OF  
SUFFOLK COUNTY, NEW YORK

CERTIFIED TO:


[Redacted signature area]

PREPARED 08-18-16 SURVEYED Aug 2, 2016  
SCALE 1" = 30'

■ DENOTES MONUMENTS

▲ DENOTES STAKES

BK 252 PG 157

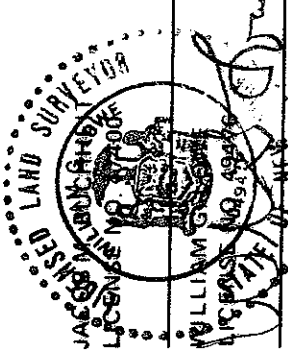

UNAUTHORIZED ALTERATION OR ADDITION TO THIS SURVEY IS A VIOLATION OF SECTION 1709 OF THE NEW YORK STATE EDUCATION LAW.  
COPIES OF THIS SURVEY MAP NOT BEARING THE SURVEYOR'S INKED SEAL OR EMBOSSED SEAL ARE NOT TO BE CONSIDERED TO BE A VALID TRUE COPY.  
WARRANTIES INDICATED HEREON SHALL RUN ONLY TO THE PERSON OR PERSONS TO WHOM THIS TITLE COMPANY, GOVERNMENTAL AGENCY AND LENDING INSTITUTION LISTED HEREON AND THEIR SUCCESSORS HAVE MADE AN INSTRUMENT OF TRANSFER. GUARANTEES ARE NOT TRANSFERRED TO ADDITIONAL INSTITUTIONS OR SUBSEQUENT OWNERS.  
E.O.W. EASEMENTS AND UNUSURROUND UTILITIES WHETHER ABANDONED OR IN USE UNLESS OTHERWISE NOTED ARE NOT SHOWN ON THIS SURVEY.

DOLLIVER LAND SURVEYING, PC  
LAND SURVEYORS AND PLANNERS  
HAMPTON BAYS, NEW YORK