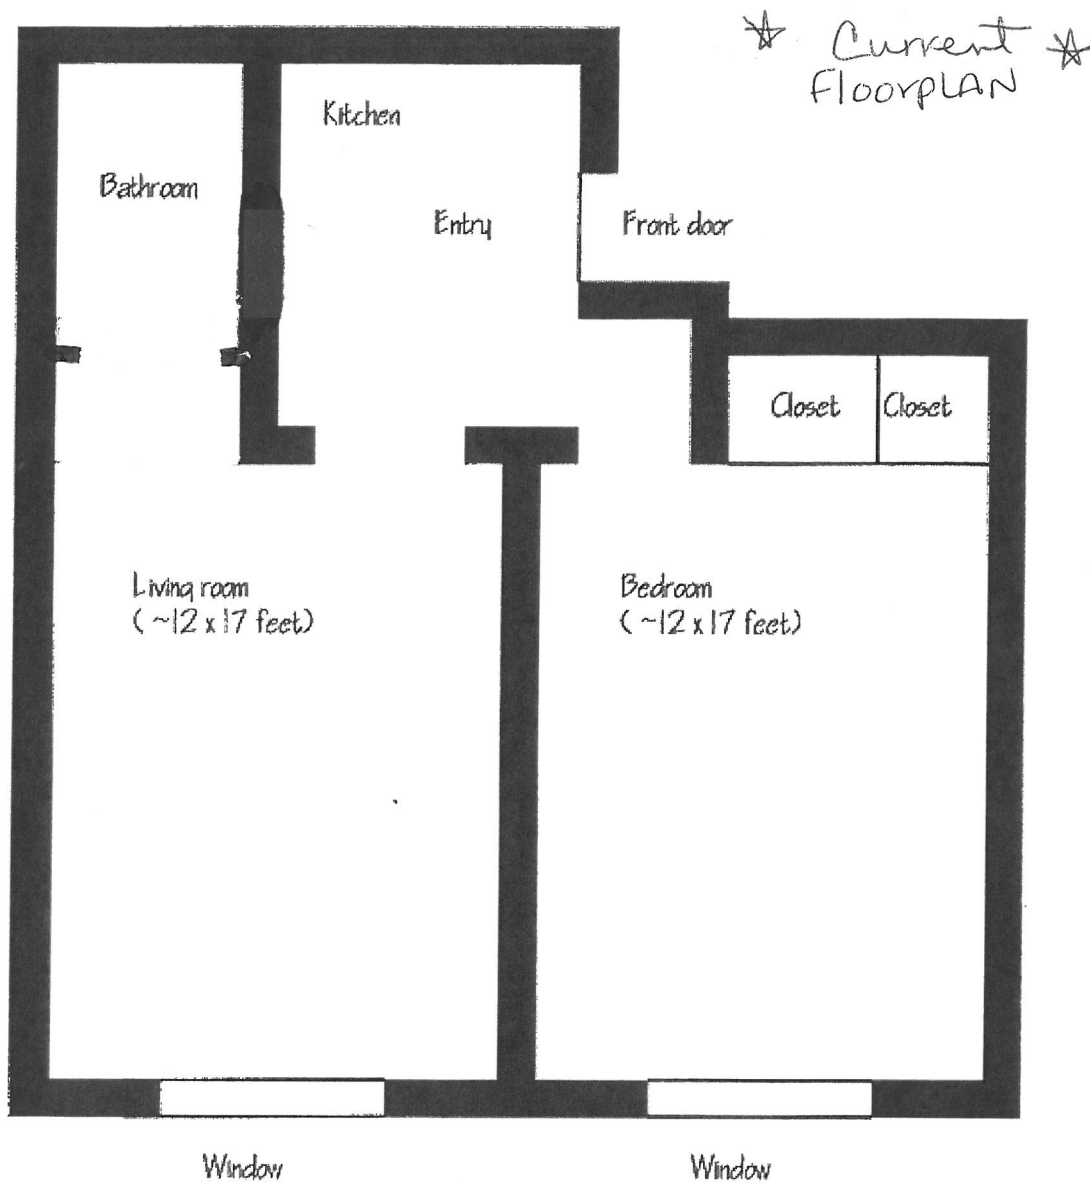


240 East 30 Street #4A

South side of East 30th Street (below)