Tax Map No. 900-33-03-33
Area = 18,758 s.f.
Zone R-20 [redacted]

SEE PYRAMID + LOT COVERAGE RESTRICTIONS ALSO,

Refer to Documents Recorded in Suffolk County Clerk's Office
Filed Map 3078 (Nov. 9, 1959)

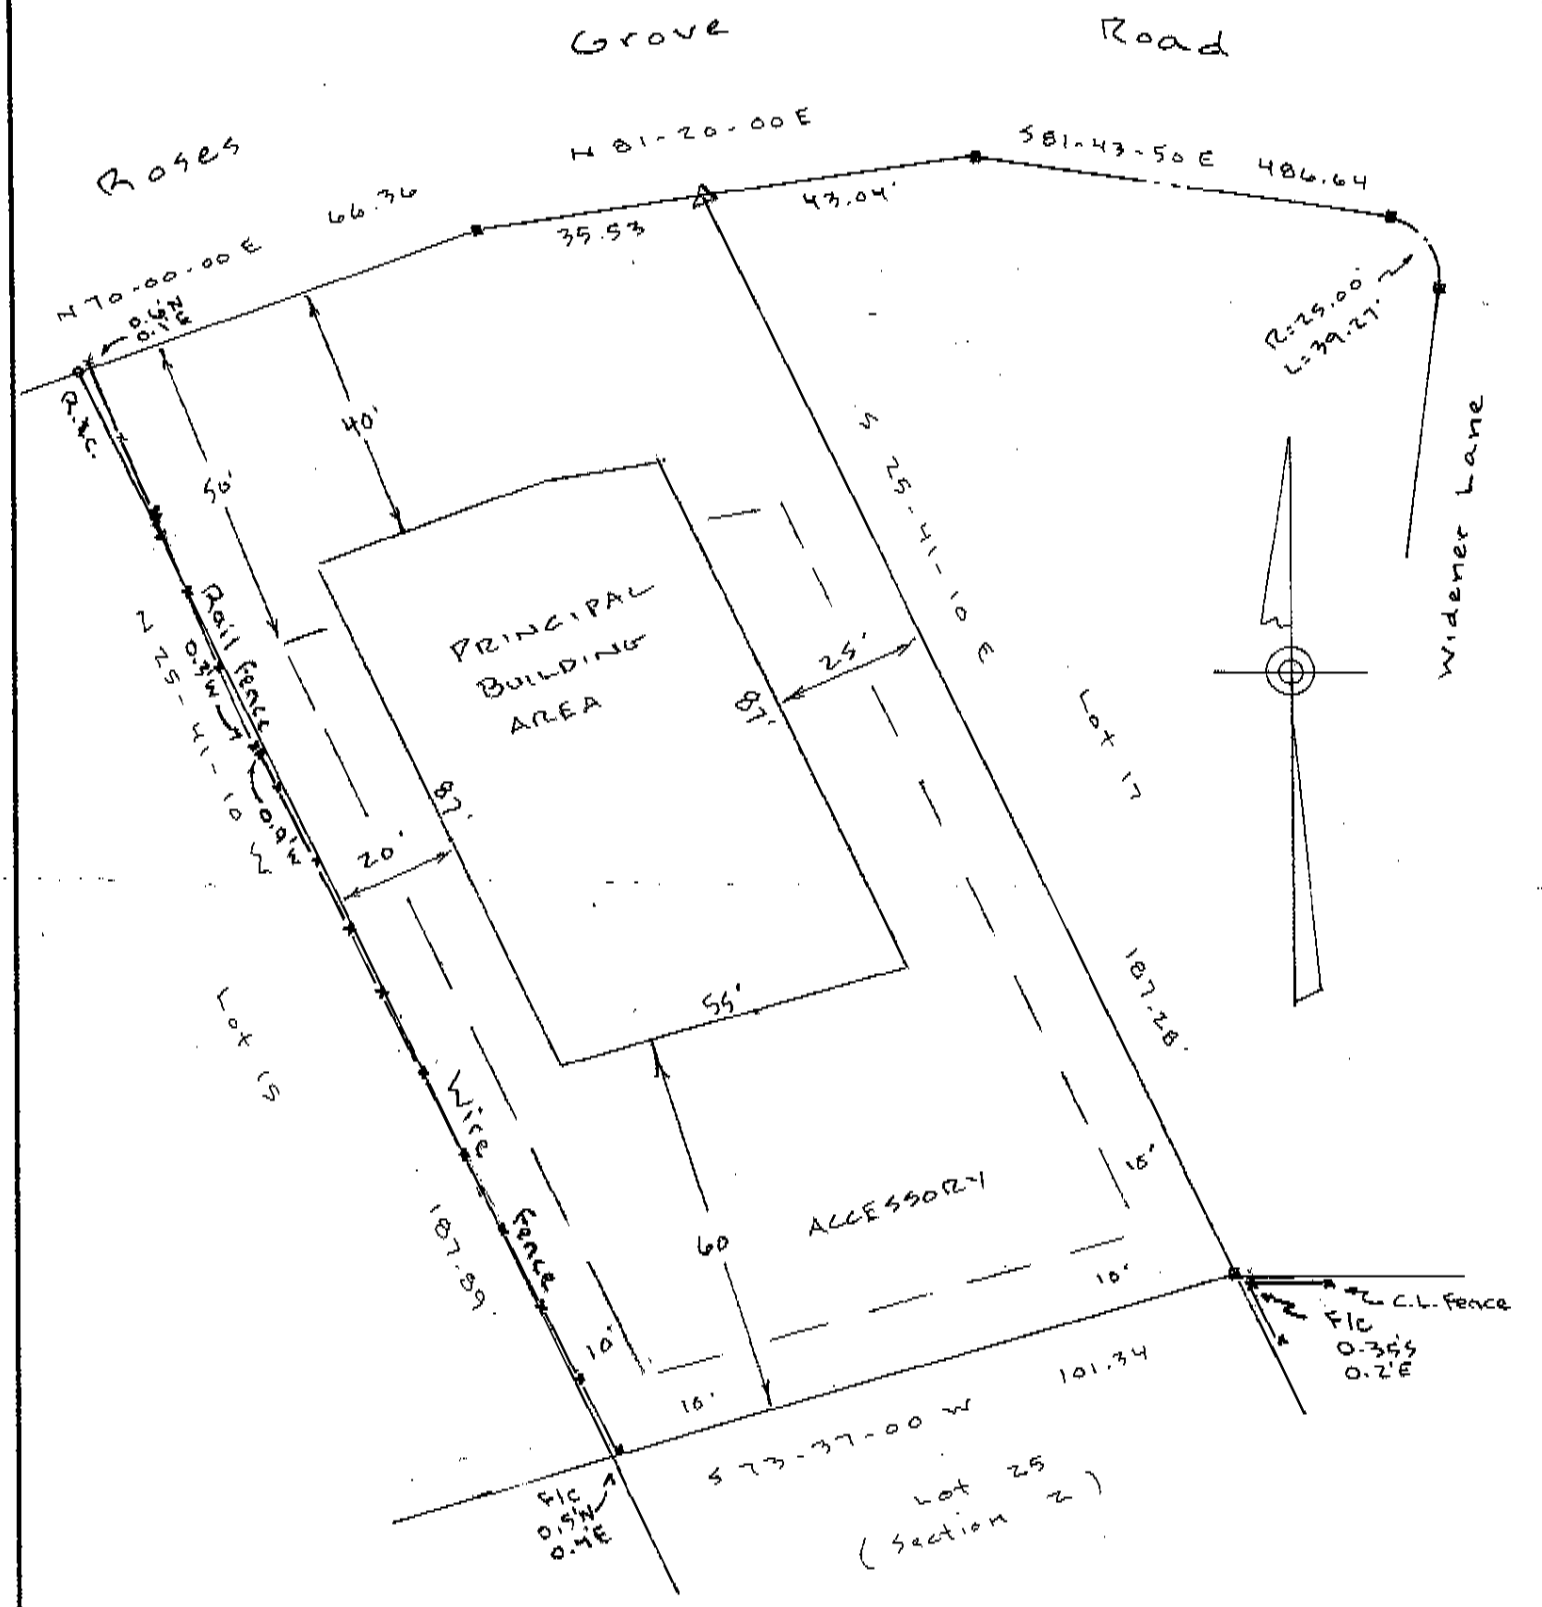

SURVEY OF PROPERTY
SITUATE