

CERTIFIED TO: W.B. MANAGEMENT COMPANY, LLC
FIDELITY NATIONAL TITLE INSURANCE COMPANY

JOB NO.: 2007-2864

MAP NO.:

FILED:

REVISIONS:

ADD CLEARING LIMITS TO A.P.O.D.

CURRENT RESTRICTIONS 1/30/08

REV. TENNIS COURT TO

SPORTS COURT 4/29/08

SET BM ON SITE FOR HEIGHT COMPLIANCE 6/06/08

FOUNDATION LOCATION 7/7/08

REV. TENNIS COURT SIZE, CALC NOT

COVERAGE 10/10/08


SCDHS FINAL SURVEY 6/16/10

PLOT REVEGETATION 7/22/10

LOCATE FINAL CLEARING 9/13/10

LOC. ADD'L REVEG & CURB. 1/4/11

LICENSE NO. 050863

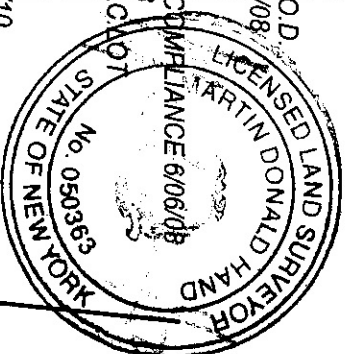


HANDS ON SURVEYING
26 SILVER BROOK DRIVE
FLANDERS, NEW YORK 11901
TEL: (631)-369-8312 - FAX: (631)-369-8313
MARTIN D. HANDL, S.



SUFFOLK COUNTY
MONUMENT
9-1454


SURVEY OF DESCRIBED PROPERTY SITUATE AT WATER MILL TOWN OF SOUTHAMPTON SUFFOLK COUNTY, NEW YORK S.C.T.M. DIST. 0900 SEC. 35 BLK. 1 LOT 14

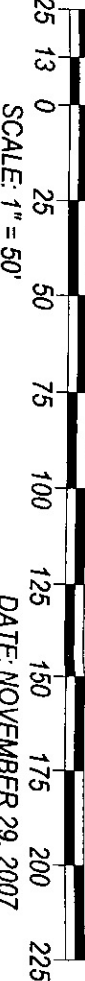

LAND NOW OR FORMERLY OF
JOHN D. PARRY & SUSANNE J. PARRY

LAND NOW OR FORMERLY OF
ELLEN L. SAIDENBERG
& LAWRENCE D. SAIDENBERG

DEERFIELD ROAD
(LITTLE NOYACK PATH)

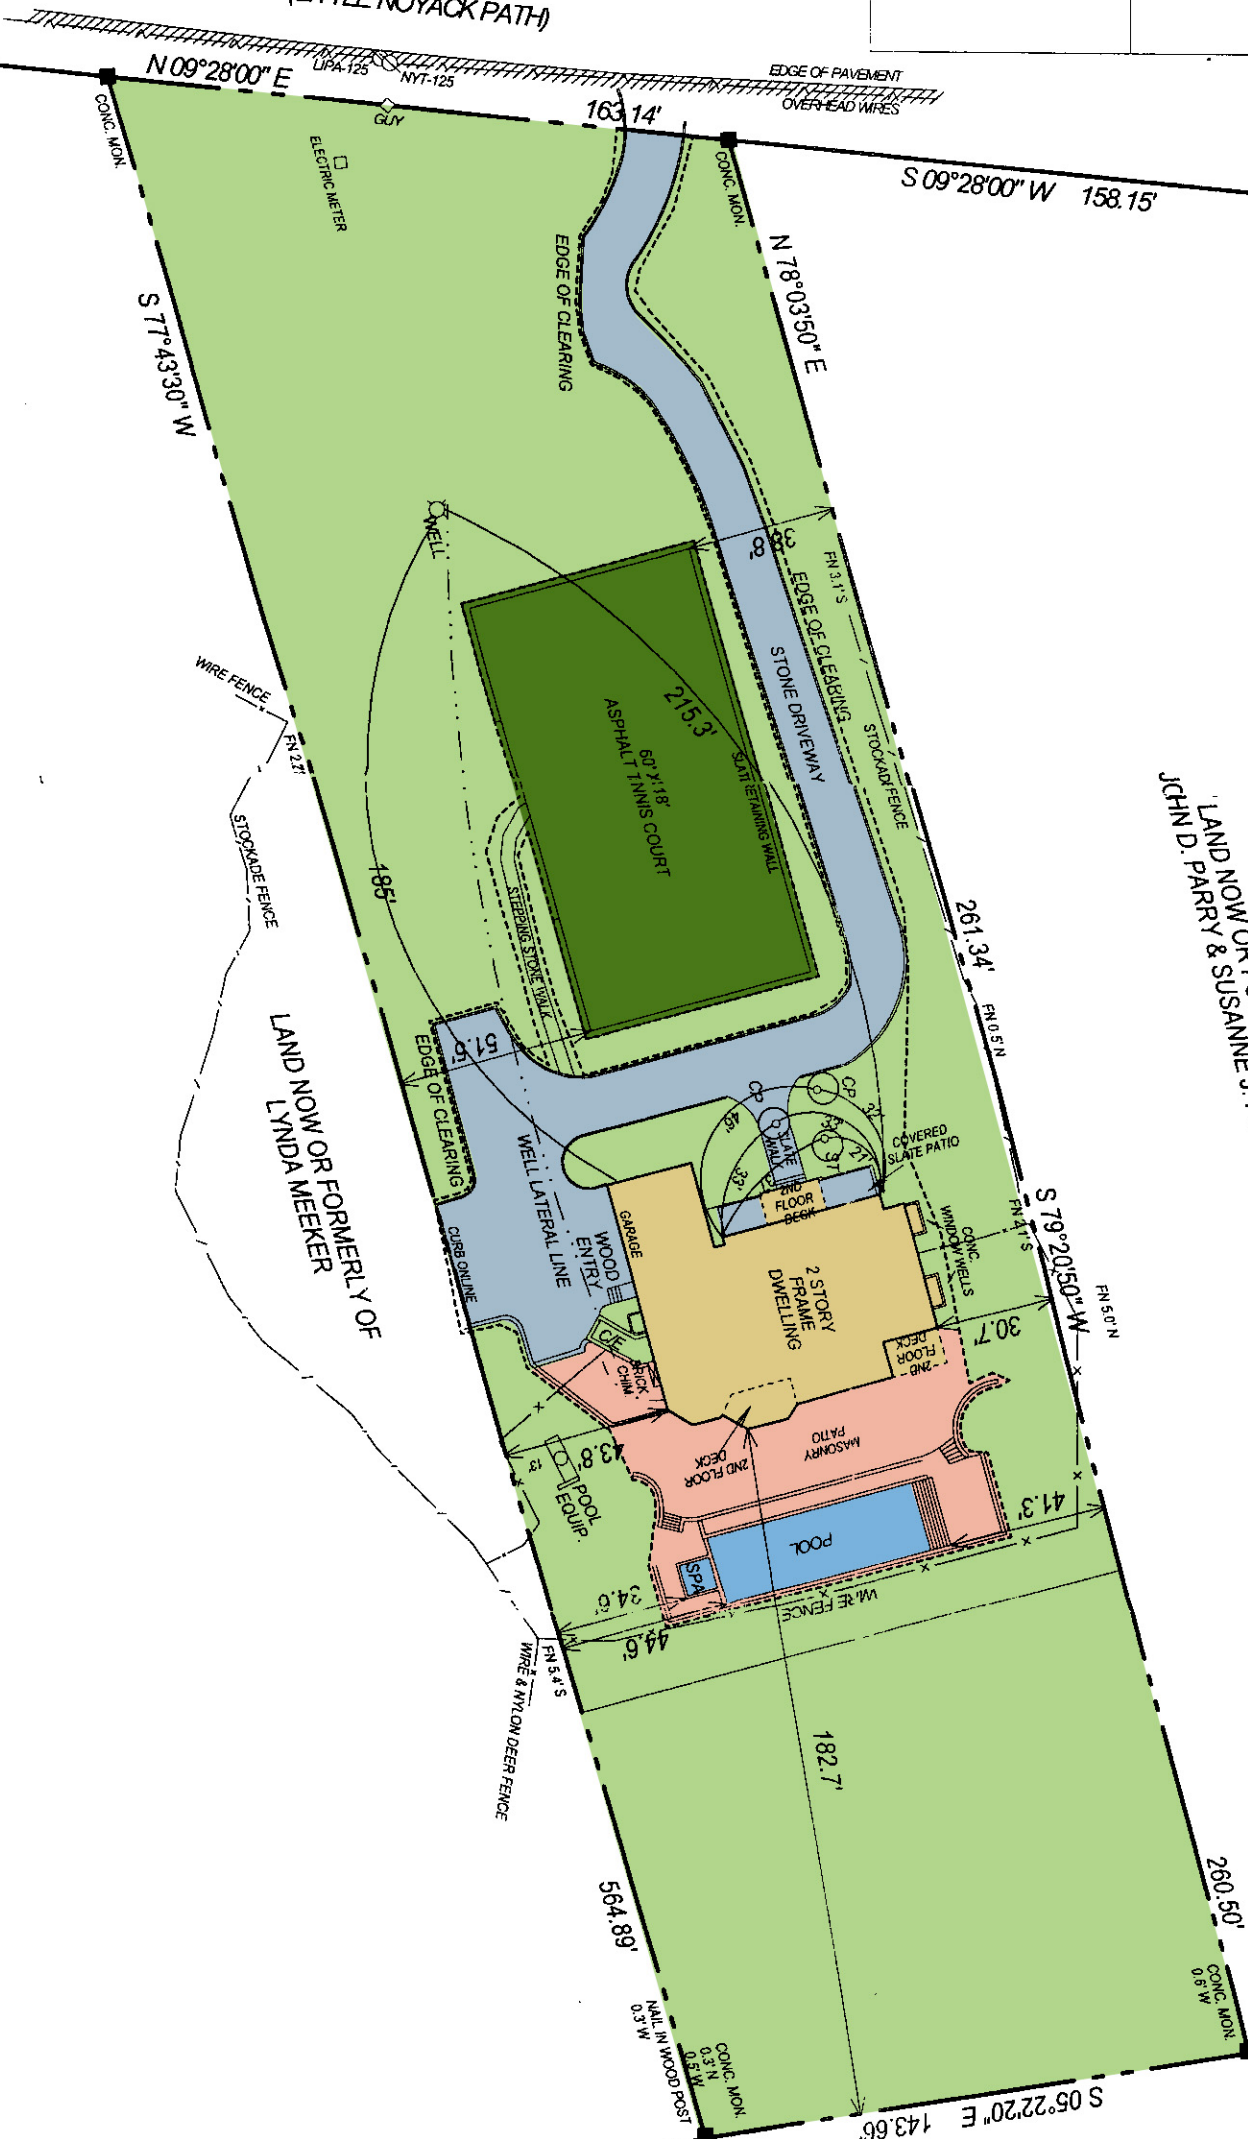

LOT AREA: 80,846 SQ. FT. = 1.866 ACRES
CURRENT ZONING: CR-200 AQUIFER PROTECTION OVERLAY DISTRICT
ALLOWABLE LOT COVERAGE: 4,042 SQ. FT. = 5.0 %
FINAL LOT COVERAGE: 4,042 SQ. FT. = 5.0 %
ALLOWABLE CLEARING: 28,296 SQ. FT. = 35 %
FINAL CLEARING: 27,964 SQ. FT. = 34.6 %

