


SURVEYED FOR:
PROPERTY LOCATED AT BRIDGEHAMPTON
LOT No. 28
MAP OF MITCHELL LANE FARM
FILED: FEBRUARY 22, 1979; FILE No. 6789
TOWN OF SOUTHAMPTON
SUFFOLK COUNTY, NEW YORK
S.C.T.N. # 900-868-81-3.22
AREA = 61.680 SF. = 1.4160 ACRES

NOTE: THE EXISTENCE OF RIGHT OF WAYS,
IF ANY, NOT SHOWN ARE NOT GUARANTEED.

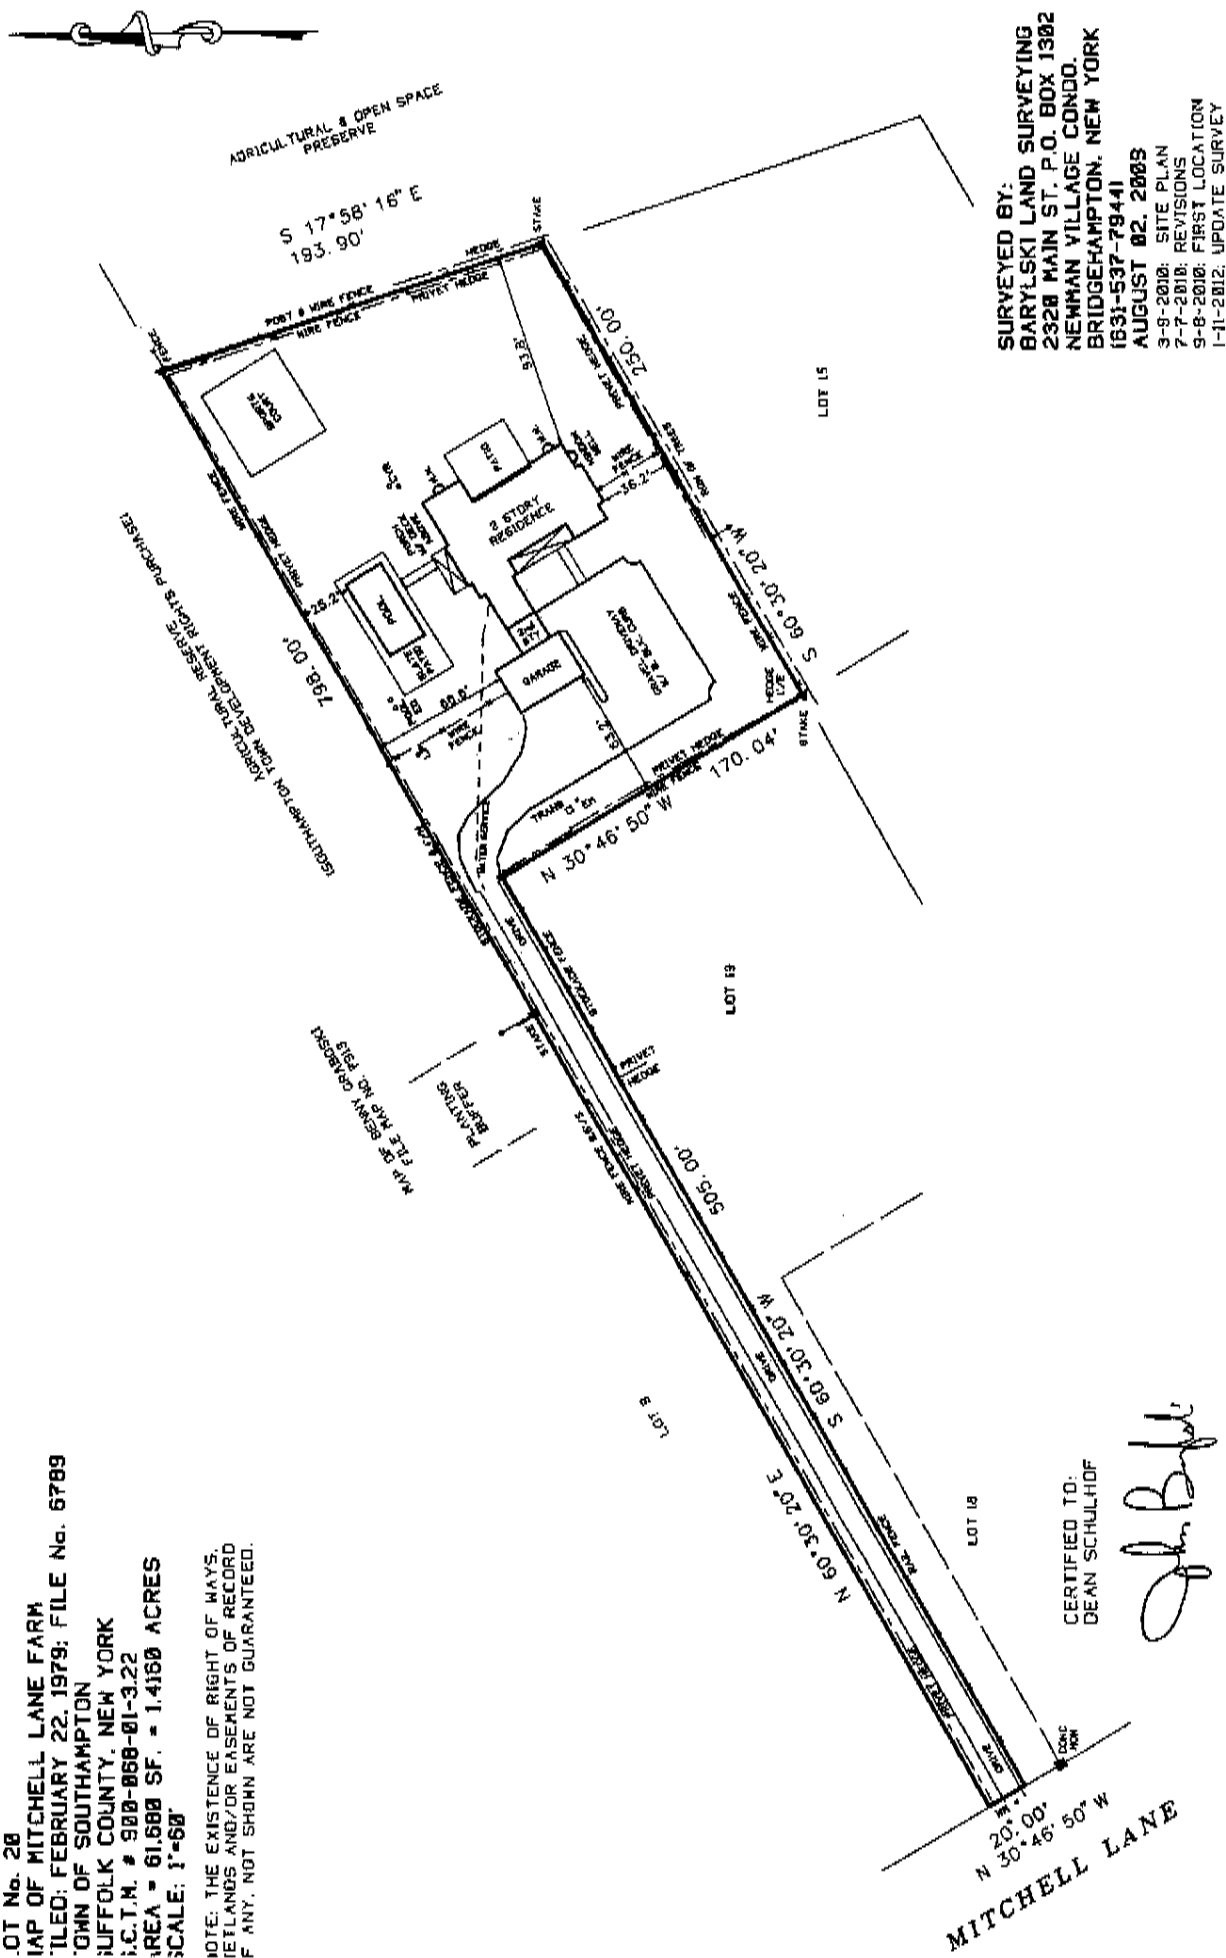

SURVEYED BY:
BARYLSKI LAND SURVEYING
2328 MAIN ST. P.O. BOX 1382
NEWMAN VILLAGE CONDO.
BRIDGEHAMPTON, NEW YORK
1631-537-7944
AUGUST 02, 2009
3-8-2010: SITE PLAN
7-7-2010: REVISIONS
9-8-2010: FIRST LOCATION
1-11-2012: UPDATE SURVEY

CERTIFIED TO:
DEAN SCHULHOF

John Baryl