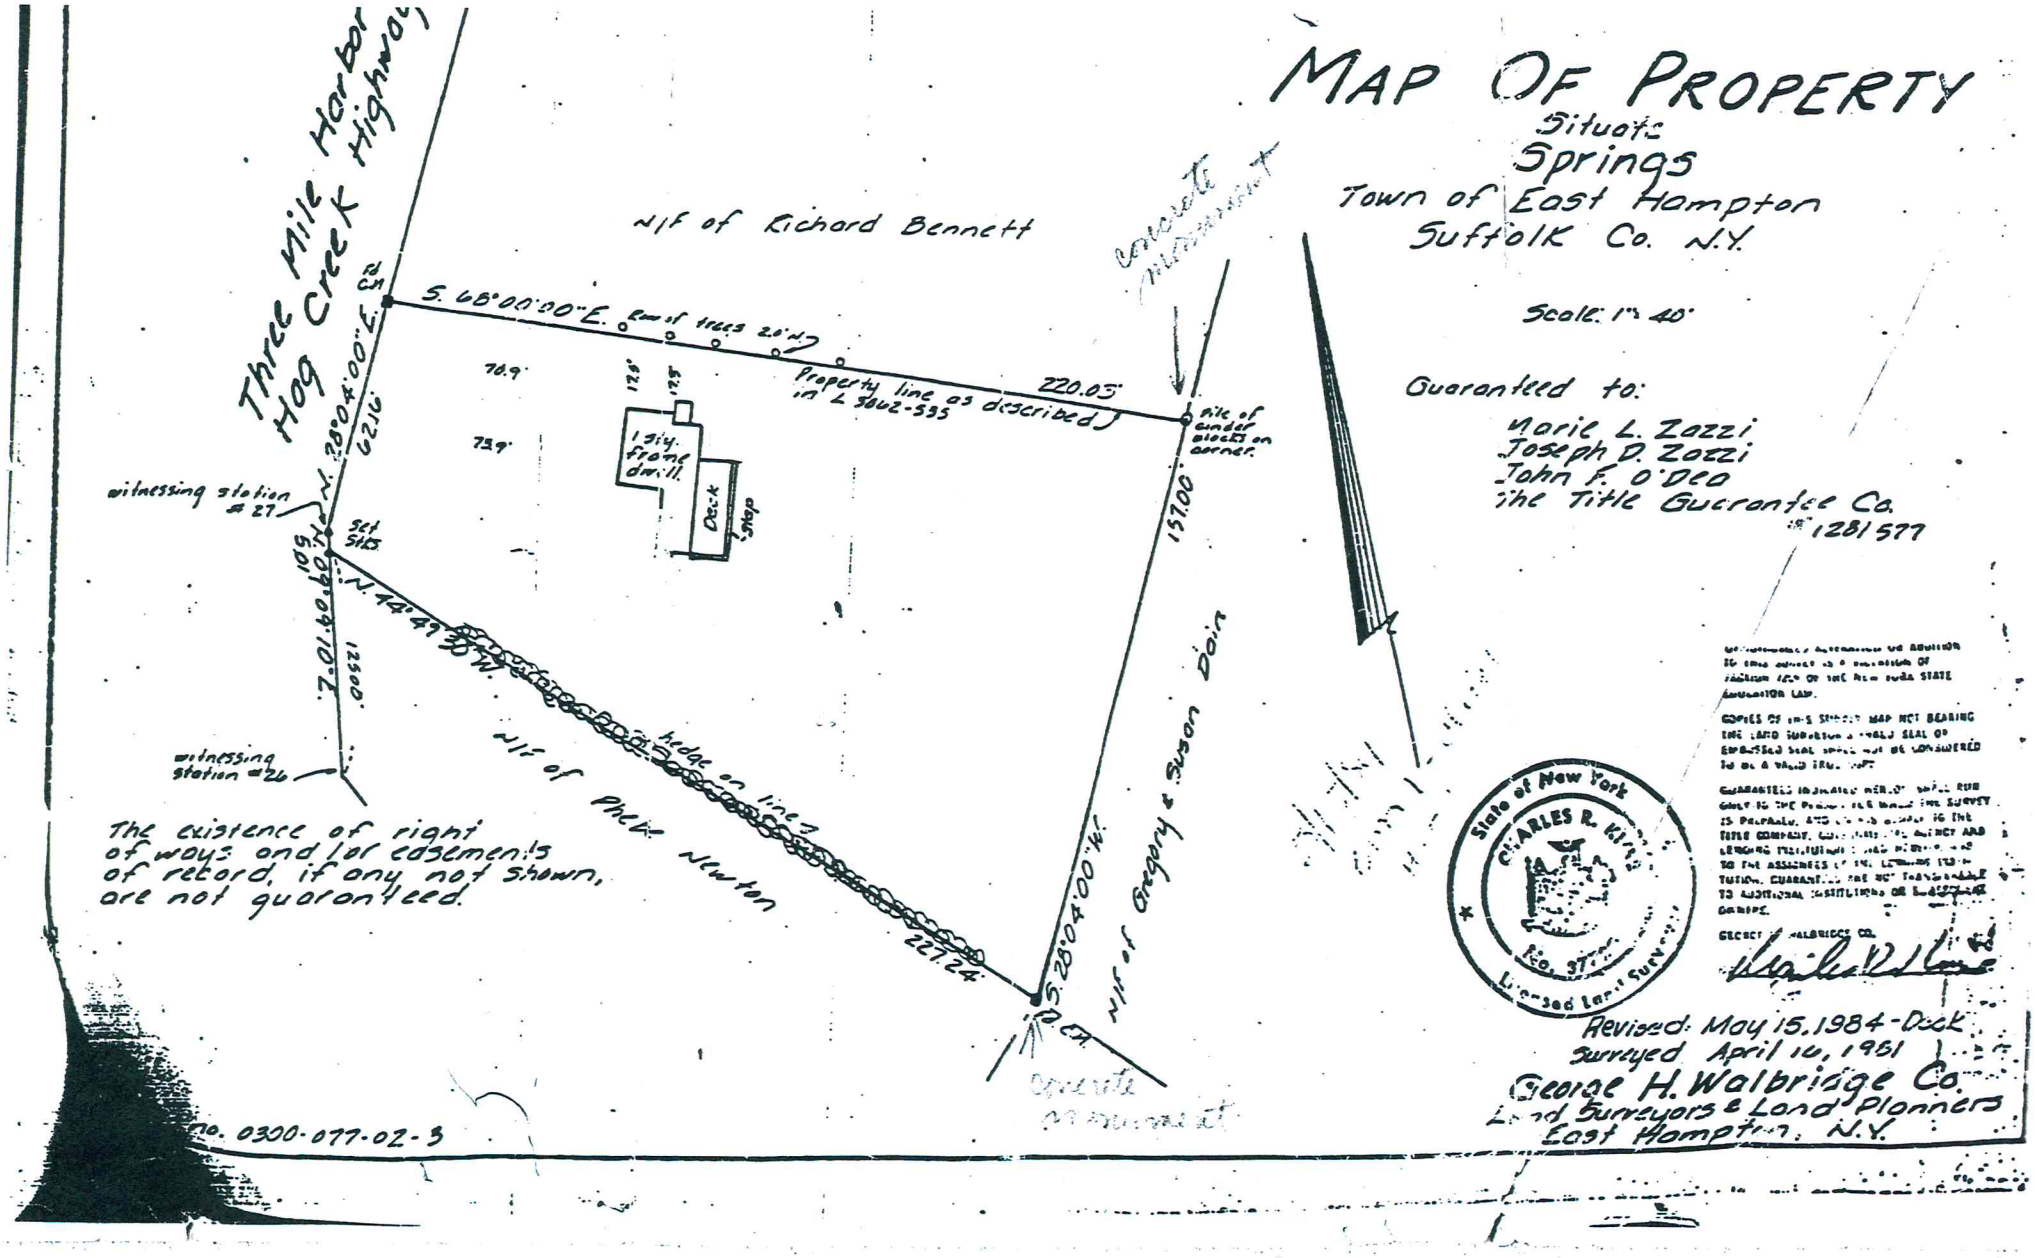
MAP OF PROPERTY
Situate
Springs
Town of East Hampton
Suffolk Co. N.Y.
Scale: 1" = 40'
Guaranteed to:
Marie L. Zazzi
Joseph D. Zazzi
John F. O'Dea
The Title Guarantee Co.
#1281577
Three Mile Harbor Hog Creek Highway
N/F of Richard Bennett
S. 68°00'00"E. Row of trees 2.0' N.
Property line as described in L 3802-335
220.03'
N. 28°04'00"E.
621.6'
P/K of cinder blocks on corner
Concrete monument
witnessing station #27
witnessing station #26
Set Stks
109.00'
N. 44°49'30"W.
1250.0'
157.00'
S. 28°04'00"W.
227.24'
1 Sty. frame dwl.
Deck
Shop
12'
12.5'
70.9'
73.9'
N/F of Phebe Newton
N/F of Gregory & Susan Dain
bridge on line
Concrete monument
The existence of right of ways and/or easements of record, if any not shown, are not guaranteed.
State of New York
Charles R. Kirk
Lic. No. 37...
Licensed Land Surveyor
Revised: May 15, 1984 - Dock
Surveyed April 10, 1981
George H. Walbridge Co.
Land Surveyors & Land Planners
East Hampton, N.Y.
No. 0300-077-02-3