


SURVEY OF
DESCRIBED PROPERTY
SITUATE AT
EAST HAMPTON

TOWN OF EAST HAMPTON
SUFFOLK COUNTY, NEW YORK

S.C.T.M. DIST 0300 SEC. 135 BLK. 02 LOT 4.003

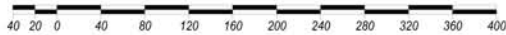

SCALE: 1" = 80'




DATE: OCTOBER 21, 2000



LOT AREA: 84,599 SQ. FT. = 1.942 ACRES
AREA EXCLUDING FLAG 74,591 SQ. FT.
ALLOWABLE CLEARING = 12.5% OF AREA EXCL. FLAG + 10,000 SQ. FT. = 19,324 SQ. FT.
INITIAL CLEARING 42,112 SQ. FT. = 56.5%
AREA REVEGETATED: 23,387 SQ. FT. = 27.64%
FINAL AREA CLEARED W/ REVEG.: 18,725 SQ. FT. = 22.13%
SUBJECT PARCEL IS IN THE WATER RECHARGE OVERLAY DISTRICT

PROPOSED ADDITIONAL CLEARING FOR TENNIS COURT: 6,197 SQ. FT.
PROPOSED FINAL CLEARING AFTER ADDITIONAL REVEGETATION: 19,093 SQ. FT. = 22.56 %

CLEARING LIMITS TO BE VERIFIED BY THE PROPER MUNICIPALITY AND/OR AGENCIES BEFORE USING CLEARING LIMITS ARE NOT CERTIFIED TO BE CORRECT.

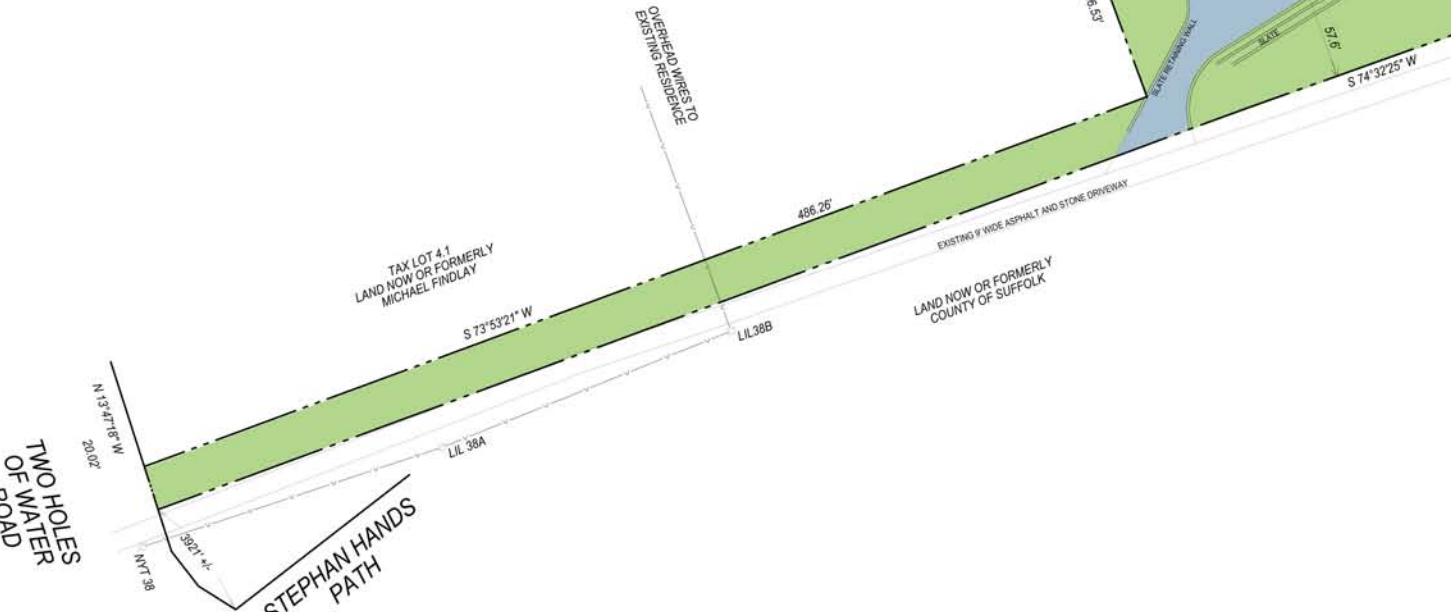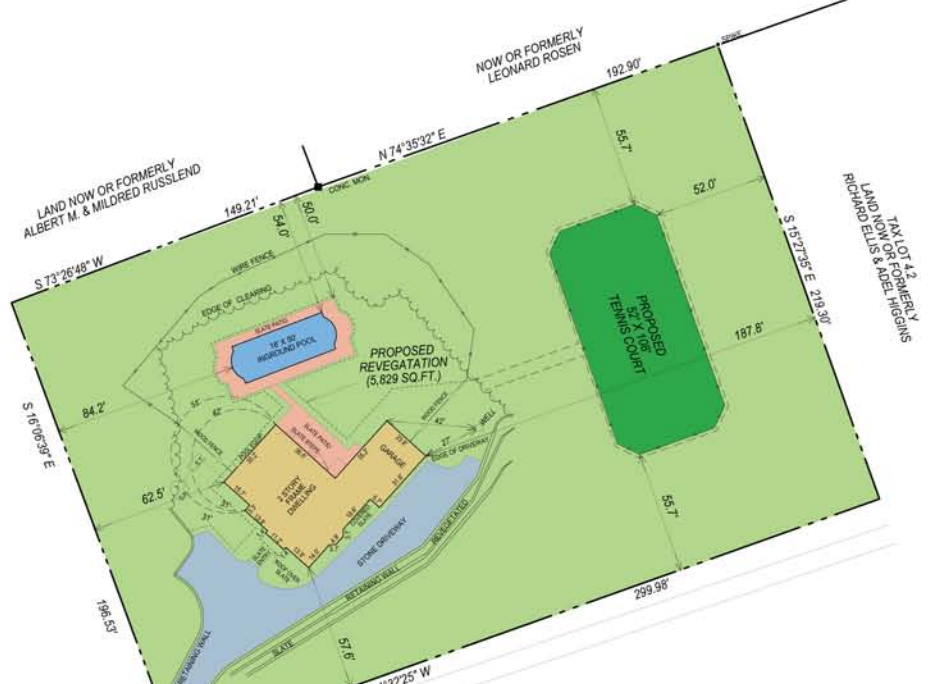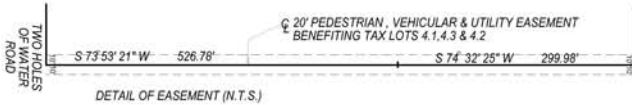

CERTIFIED: KIRI BORG
ASTORIA FEDERAL SAVINGS BANK
FIRST AMERICAN TITLE INSURANCE CO.

JOB NO. 2000-131
MAP NO.
FILED:
REVISIONS:
ADD HSE, SAN & WELL 12/08/00
FOUND LOC. 2/19/01
REV SAN LOC. 4/2/01
ADD EXIST. CLEARING & PROP.
REV. PROP POOL 6/20/01
REVEG 4/30/01
ADD EXIST REVEG. 7/20/01
FINAL: 2/12/02
REV. POOL PATIO 3/15/02
ADD PROP TEN. CRT. CLEARING & REVEG. 4/26/03
UPDATE SURVEY, PLOT PROP. TENNIS COURT
PLOT PROP REVEG. RECERT TO NEW
OWNER: 2/26/09

LICENSE NO. 050363

HANDS ON SURVEYING
26 SILVER BROOK DRIVE
FLANDERS, NEW YORK
11901
TEL: (631)-369-8312 - FAX: (631)-369-8313
MARTIN D. HAND L.S.