

**SURVEY OF PROPERTY
AT BRIDGEHAMPTON
TOWN OF SOUTHAMPTON
SUFFOLK COUNTY, N.Y.**

900'-36-01-36.7

SCALE: 1"=60'

APRIL 19, 2007

MAY 21, 2007 (CERTIFICATION)

MAY 29, 2007 (STK)

JUNE 20, 2007 (pond)


SUFFOLK COUNTY DEPARTMENT OF HEALTH SERVICES
PERMIT FOR APPROVAL OF CONSTRUCTION FOR A
SINGLE FAMILY RESIDENCE AND
DATE: 5/21/07 H.S. REF. NO. 209-07-0374
APPROVED: [Signature]
TOTAL MINIMUM BEDROOMS: 5
EXPIRES THREE YEARS FROM DATE OF APPROVAL

EXCAVATION INSPECTION REQUIRED
FOR SANITARY SYSTEM
BY HEALTH DEPARTMENT

CERTIFIED TO:
CRAIG MITCHELL & DARLENE
MITCHELL
WASHINGTON TITLE INSURANCE
COMPANY

Septic system
5 bedrooms
1 1500gal precast 8' x 8' septic
tank
2 leaching pools 8' x 8' deep

AREA=4.5609 ACRES

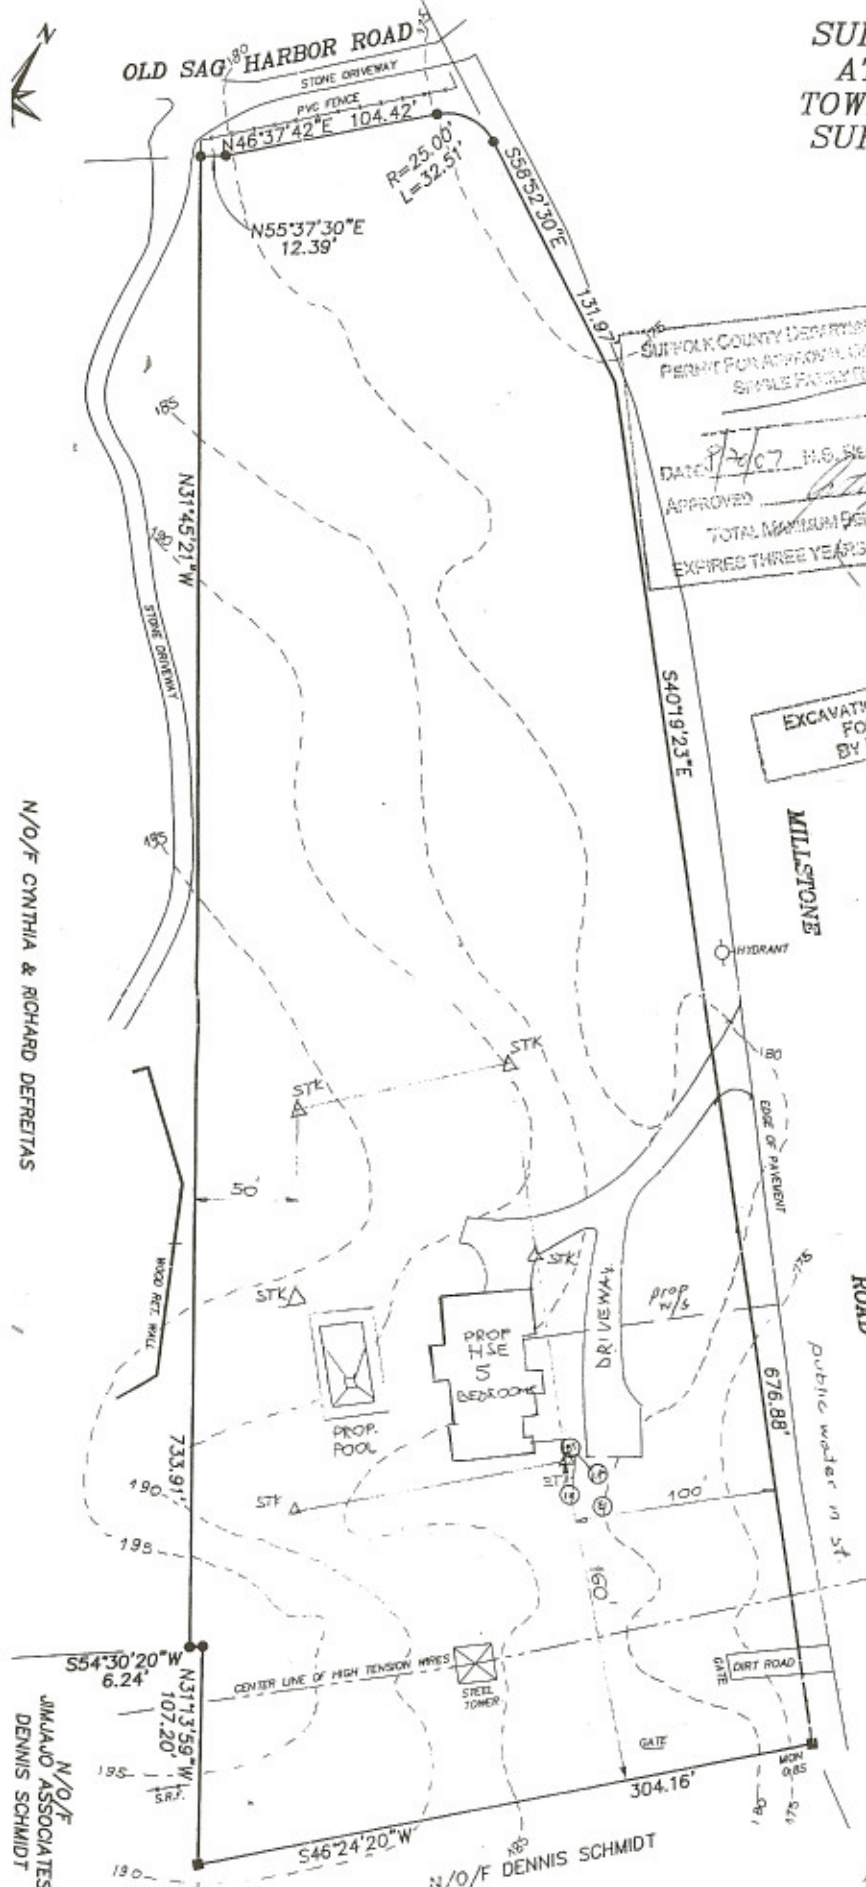

N/O/F CYNTHIA & RICHARD DEFREITAS

N/O/F JIM AND ASSOCIATES DENNIS SCHMIDT

N/O/F DENNIS SCHMIDT

■ = MONUMENT
● = REBAR SET

ANY ALTERATION OR ADDITION TO THIS SURVEY IS A VIOLATION OF SECTION 2209 OF THE NEW YORK STATE EDUCATION LAW EXCEPT AS PER SECTION 2209-SUBSECTION 2. ALL CERTIFICATIONS HEREON ARE VALID FOR THIS MAP AND COPIES THEREOF ONLY IF SAID MAP OR COPIES BEAR THE IMPRESSED SEAL OF THE SURVEYOR WHOSE SIGNATURE APPEARS HEREON.

STATE OF NEW YORK
JOHN T. METZGER
N.Y. S. E. C. NO. 49618
RECONIC SURVEYORS
(631) 765-5020 FAX (631) 765-1797
P.O. BOX 909
1230 TRAVELER STREET
SOUTHOLD, N.Y. 11971
07-141

RECEIVED
SUFFOLK COUNTY
MAY 23 2007 11:55