Tax Map No. 908-09-01-05
Area 49,131 s.f.
Zone R-120

Refer to Documents Recorded in Suffolk County Clerk's Office

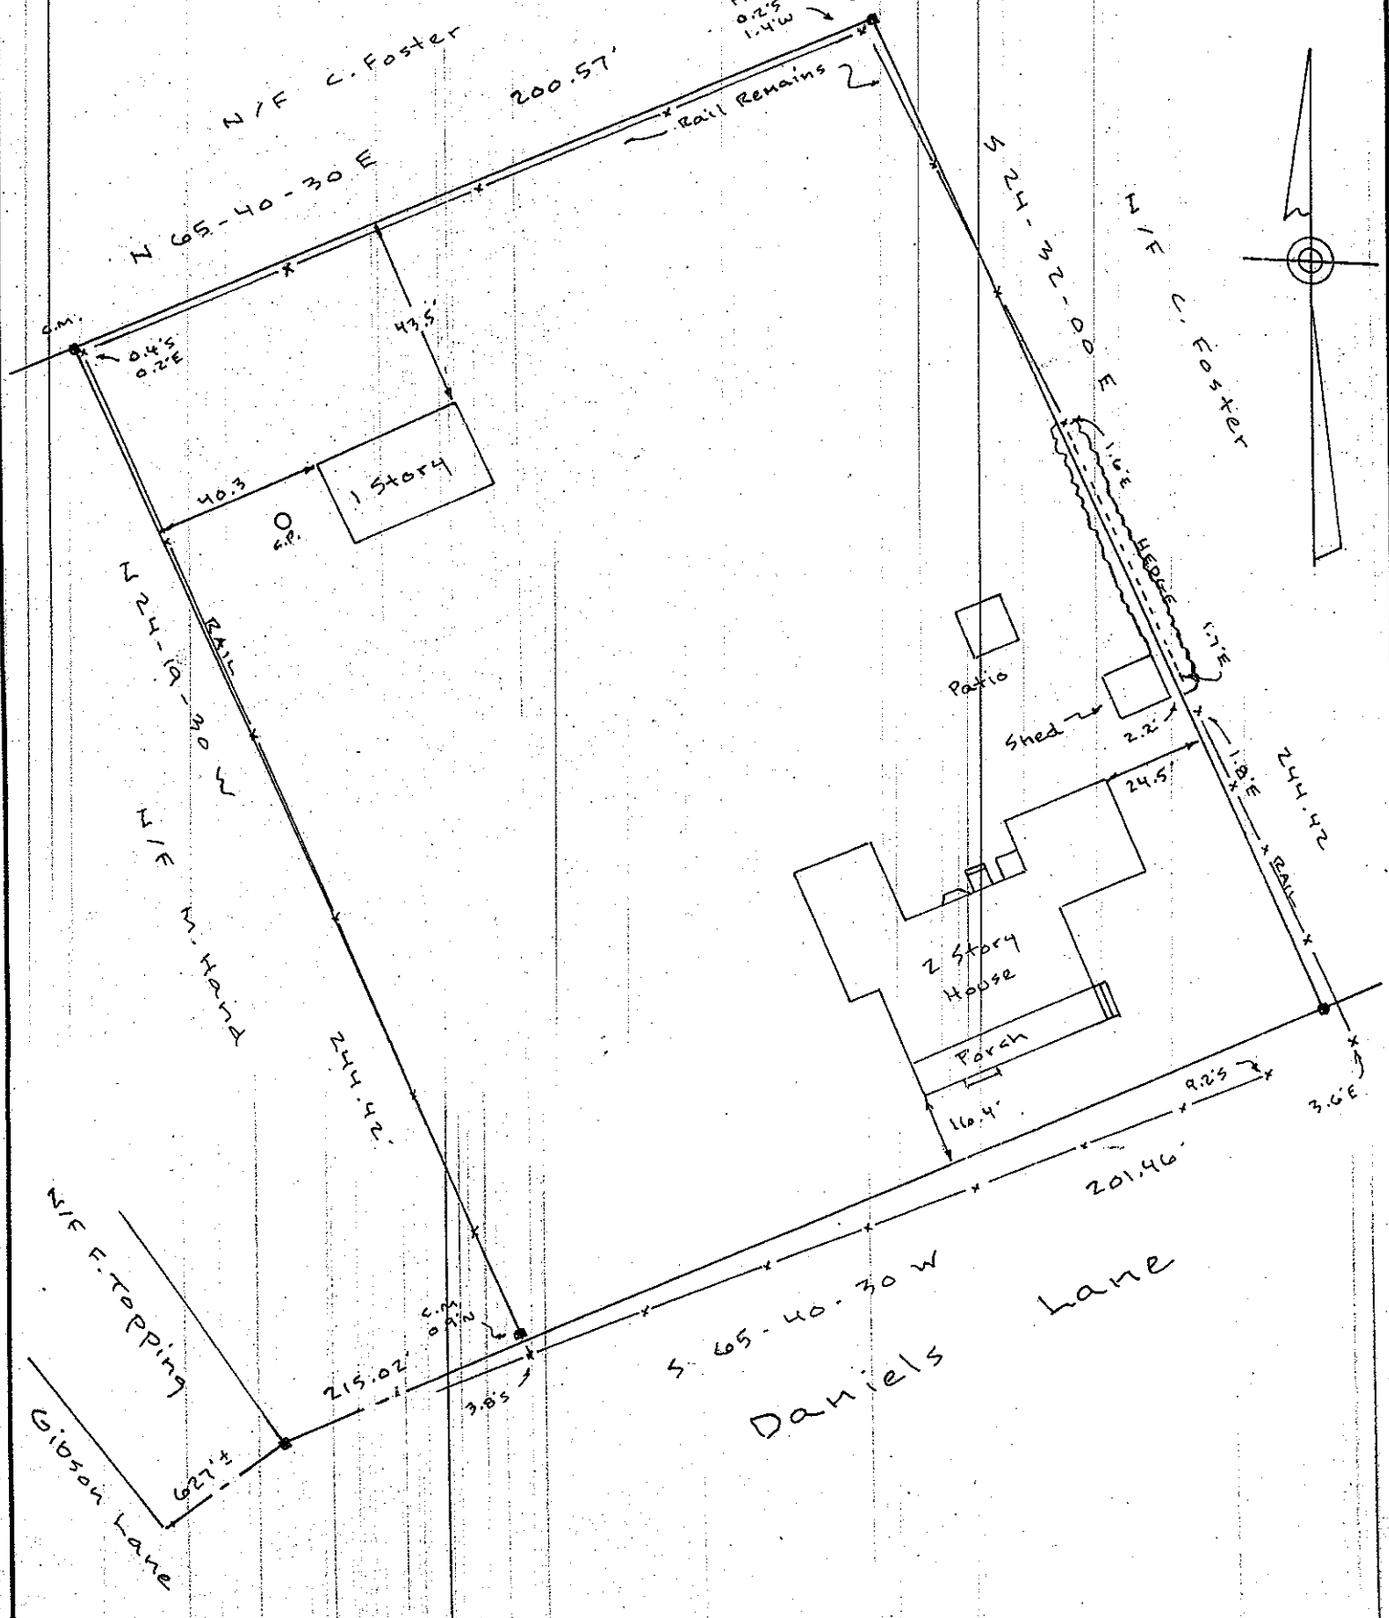

SURVEY OF PROPERTY
SITUATE

Daniels Lane
Village of Sagaponack

TOWN OF SOUTHAMPTON
SUFFOLK COUNTY, NEW YORK

CERTIFIED TO:
Anne Bradley

LICENSED LAND SURVEYOR
WILLIAM G. LOWE
JACOBY SCHMITT
LICENSE NO. 47400
WILLIAM G. LOWE
LICENSE NO. 49456

UNAUTHORIZED ALTERATION OR ADDITION TO THIS SURVEY IS A VIOLATION OF SECTION 7209 OF THE NEW YORK STATE EDUCATION LAW.

COPIES OF THIS SURVEY MAP NOT BEARING THIS LAND SURVEYOR'S INKED SEAL OR EMBOSSED SEAL SHALL NOT BE CONSIDERED TO BE A VALID TRUE COPY.

GUARANTEES INDICATED HEREON SHALL RUN ONLY TO THE PERSON FOR WHOM THE SURVEY IS PREPARED AND ON HIS BEHALF TO THE TITLE COMPANY, GOVERNMENTAL AGENCY AND LENDING INSTITUTION LISTED HEREON AND TO THE ASSIGNEES OF THE LENDING INSTITUTION. GUARANTEES ARE NOT TRANSFERABLE TO ADDITIONAL INSTITUTIONS OR SUBSEQUENT OWNERS

R.O.W. EASEMENTS, AND UNDERGROUND UTILITIES WHETHER ABANDONED OR IN USE UNLESS OTHERWISE NOTED ARE NOT SHOWN ON THIS SURVEY.

DOLLIVER LAND SURVEYING, PC
LAND SURVEYORS AND PLANNERS
HAMPTON BAYS, NEW YORK

PREPARED 8-16-10 SURVEYED Aug 12, 2010
SCALE 1" = 40
■ DENOTES MONUMENTS ▲ DENOTES STAKES

BK 229 PG 124