

SURVEY OF PRO

LOT 18

Map Of

NORTH HAVEN HIL

Situate

Filed May 14, 1980 as map

INCORPORATED VILLAGE OF NO

Town Of Southampton

Suffolk County, New York

SCALE: 1" = 50'

AREA: 182,879 sq. ft.
or 4.1983 acres



Certified only to:

Nina Kammer
Fidelity National Title Insurance Company
Staten Island Savings Bank

- indicates found concrete monument.
- ▲ indicates found stake.
- indicates set 12" iron pin.
- △ indicates set stake

NOTES:

1. Unauthorized alteration or addition to a survey map bearing a licensed land surveyor's seal is a violation of section 7209, sub-division 2 of the N.Y. State Education Law.
2. Only copies from the original of this survey marked with an original of the land surveyor's embossed seal or inked seal shall be considered to be valid copies.
3. Certifications indicated hereon signify that this survey was prepared in accordance with the various Code of Practice for Land Surveyors adopted by the State of New York.


LINE	BEARING	DISTANCE
L 1	S 73° 54' 54" E	17.00'



July 22, 2001
July 23, 2001
May 24, 2000
November 8, 2000
June 25, 2000
May 8, 2001
April 18, 2001


Subdivided May 14, 1980 as Map no. 6901
 INCORPORATED VILLAGE OF NORTH HAVEN
 Town of Southampton
 Suffolk County, New York

SCALE: 1" = 50'
 AREA: 81,081 sq. ft.
 or 1.8613 acres

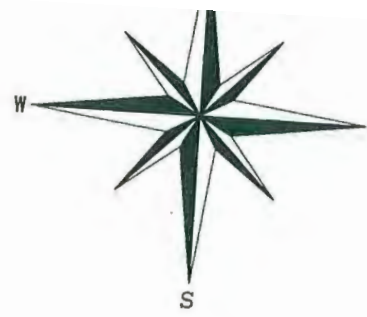

Conveyed only to:
 Vina Kaminer
 Allen Cohen
 Fidelity National Title
 Insurance Company of
 New York, Inc.

Land Now or Formerly of
 Ralph J. Herbert &
 Karen A. Wagner
 (Well & Cesspool over 100')

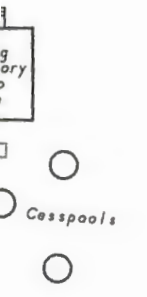

Lot 18

House - Well over 150'



Lot 16
 Vacant

North Haven Way

Sunset Beach Dr.

Indicates found iron pin.
 Indicates found stake.
 Indicates set 12" iron pin.
 Indicates set stake.

Lot 18

House - Well over 150'

Electric Meter

North Haven Way

Sunset Beach Drive

Lot 16
Vacant

