
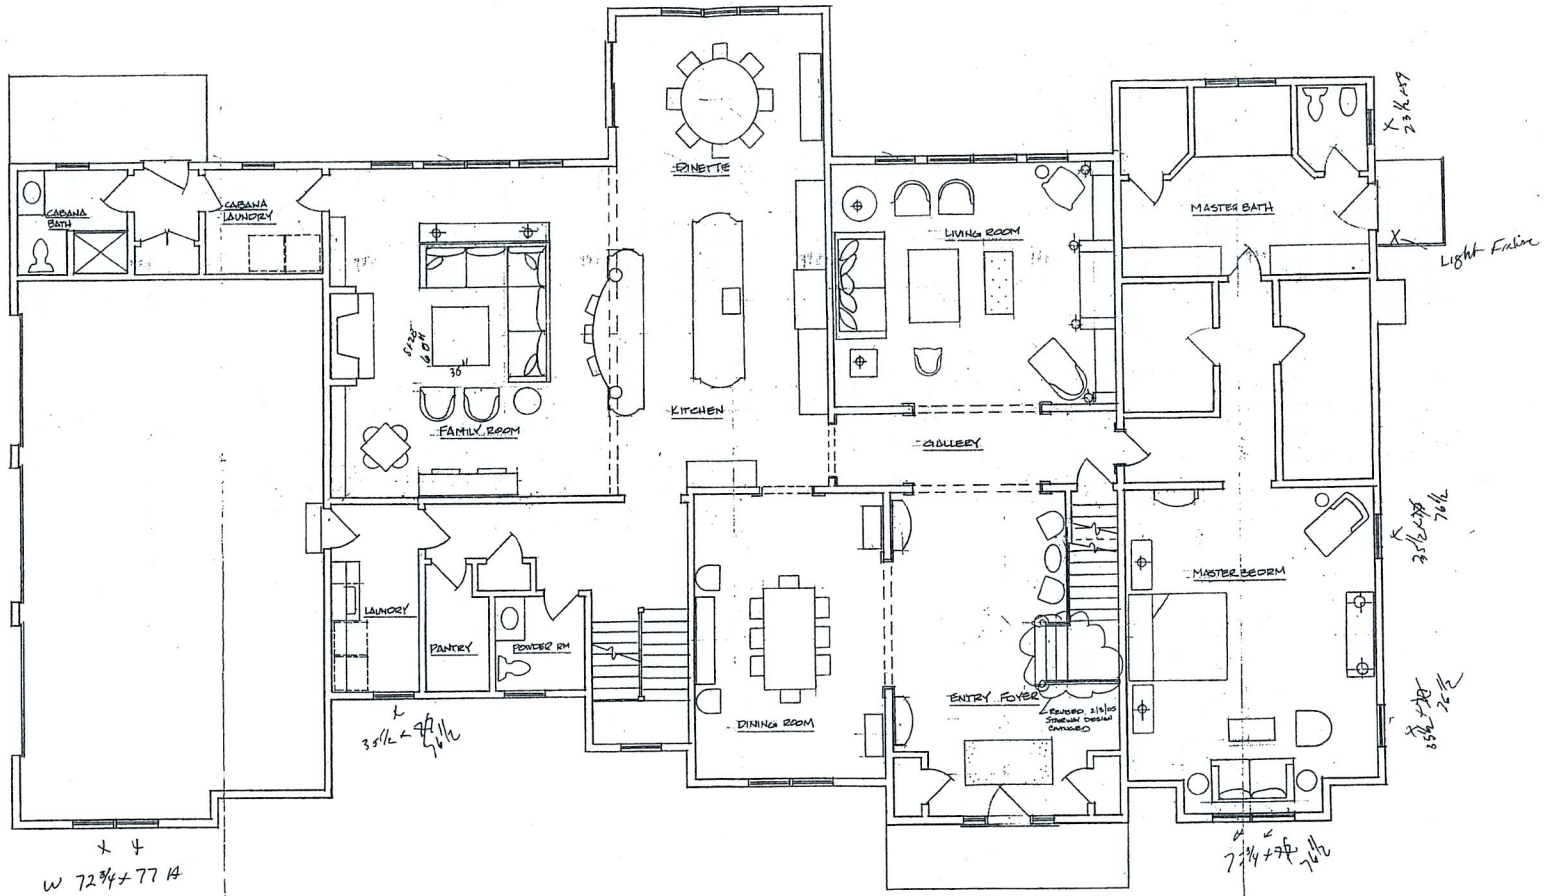


TABATCHNICK RESIDENCE

FIRST FLOOR PLAN

1/26/05
REV. 2/3/05

1/4" = 1'-0"

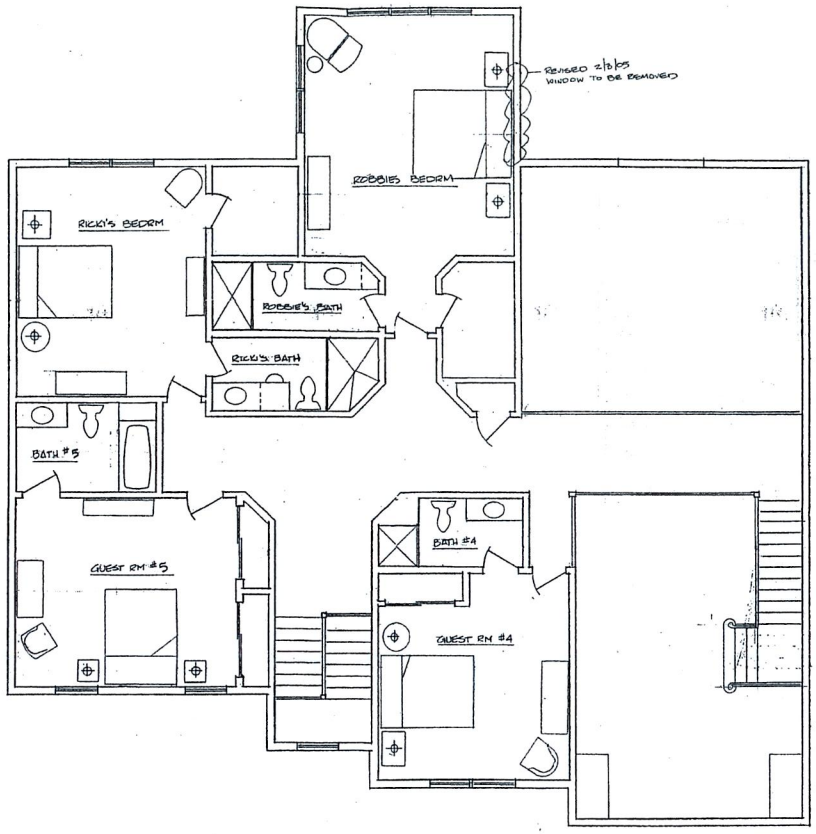

2/1/05 REVISED 2/3/05

TABATCHNICK RESIDENCE
SECOND FLOOR PLAN