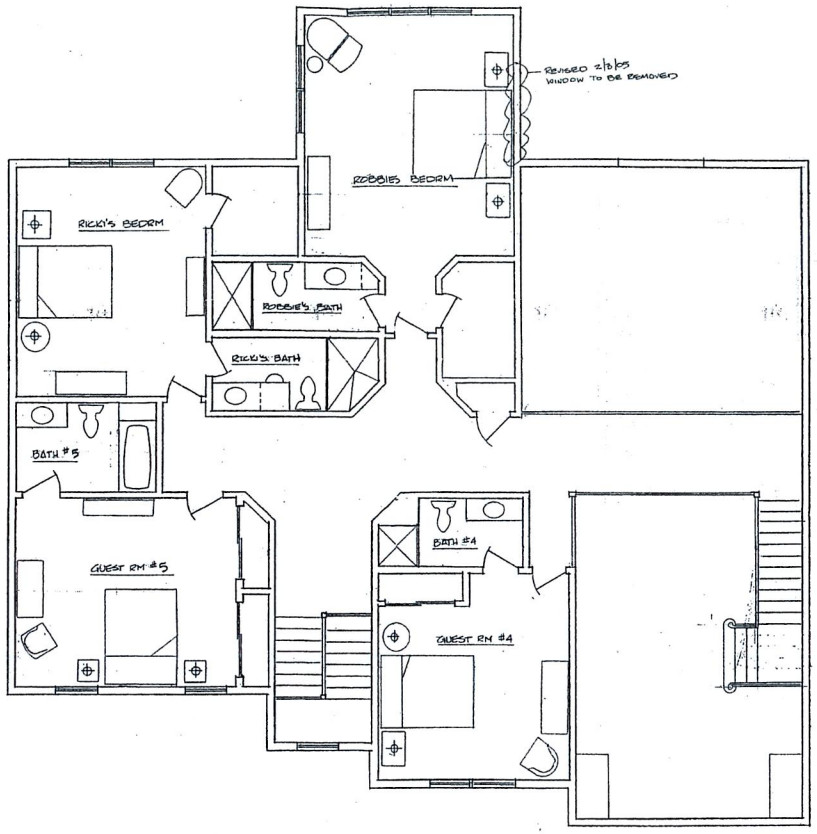

2/1/05 REVISED 2/3/05

TABATCHNICK RESIDENCE
SECOND FLOOR PLAN