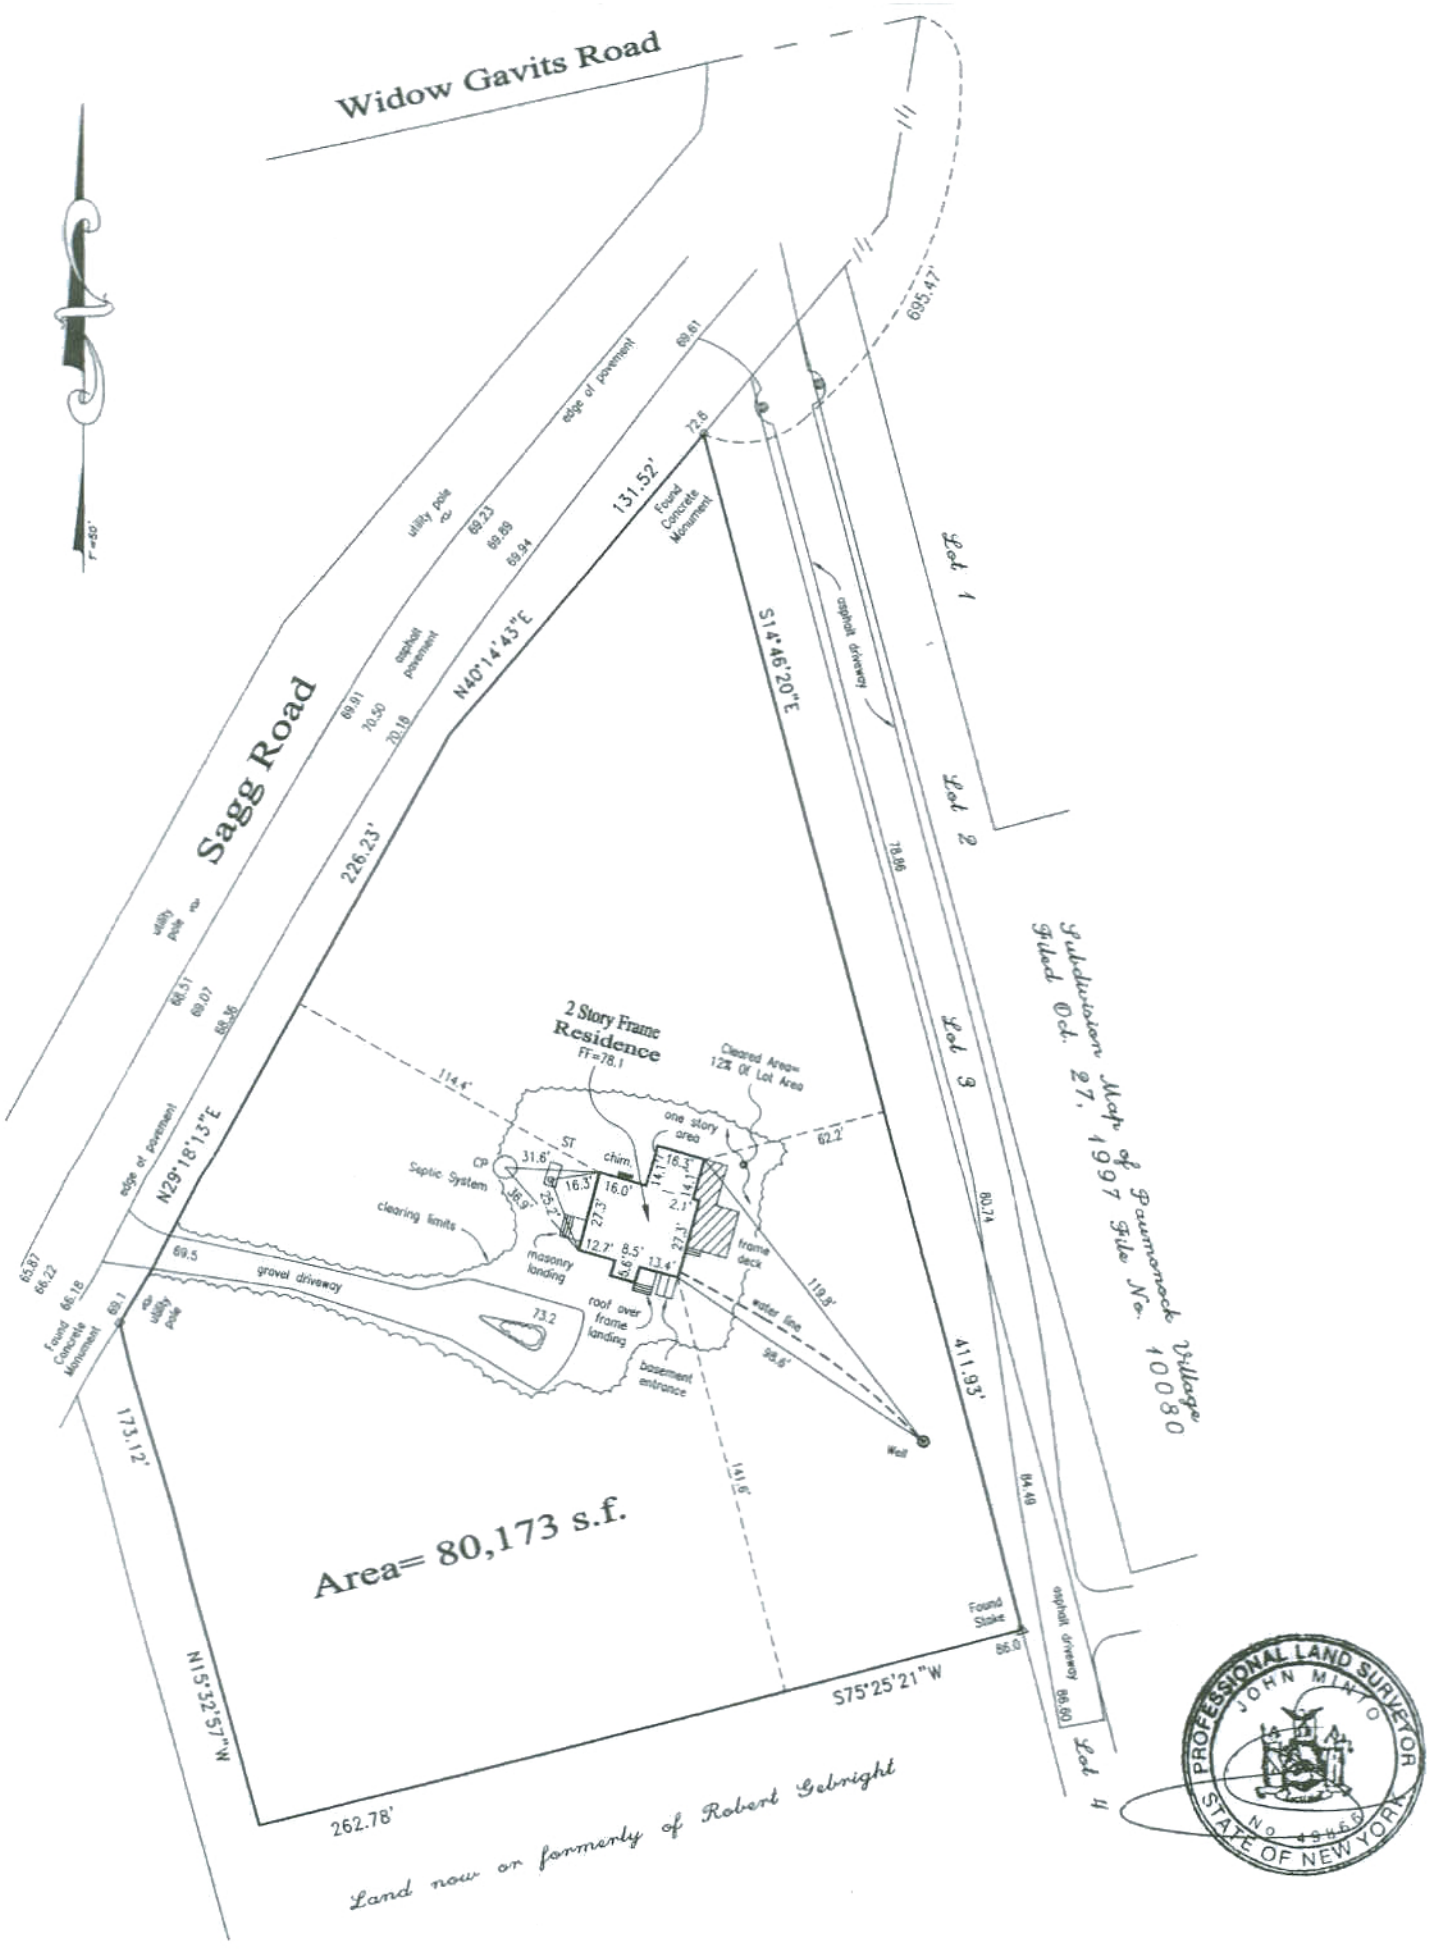
Widow Gavits Road
Sagg Road
edge of pavement
utility pole
asphalt pavement
N40°14'43"E
131.52'
S14°46'20"E
226.23'
N29°18'13"E
173.12'
N15°32'57"W
262.78'
S75°25'21"W
411.93'
695.47'
Found Concrete Monument
Found Stake
asphalt driveway
Lot 1
Lot 2
Lot 3
Lot 4
Subdivision Map of Paumanock Village
Filed Oct. 27, 1997 File No. 10080
2 Story Frame Residence
FF=78.1
Cleared Area= 12% Of Lot Area
one story area
chim.
ST
CP
Septic System
clearing limits
masonry landing
roof over frame landing
frame deck
basement entrance
water line
Well
gravel driveway
Area= 80,173 s.f.
Land now or formerly of Robert Gebright
PROFESSIONAL LAND SURVEYOR
JOHN MINTO
No. 49869
STATE OF NEW YORK