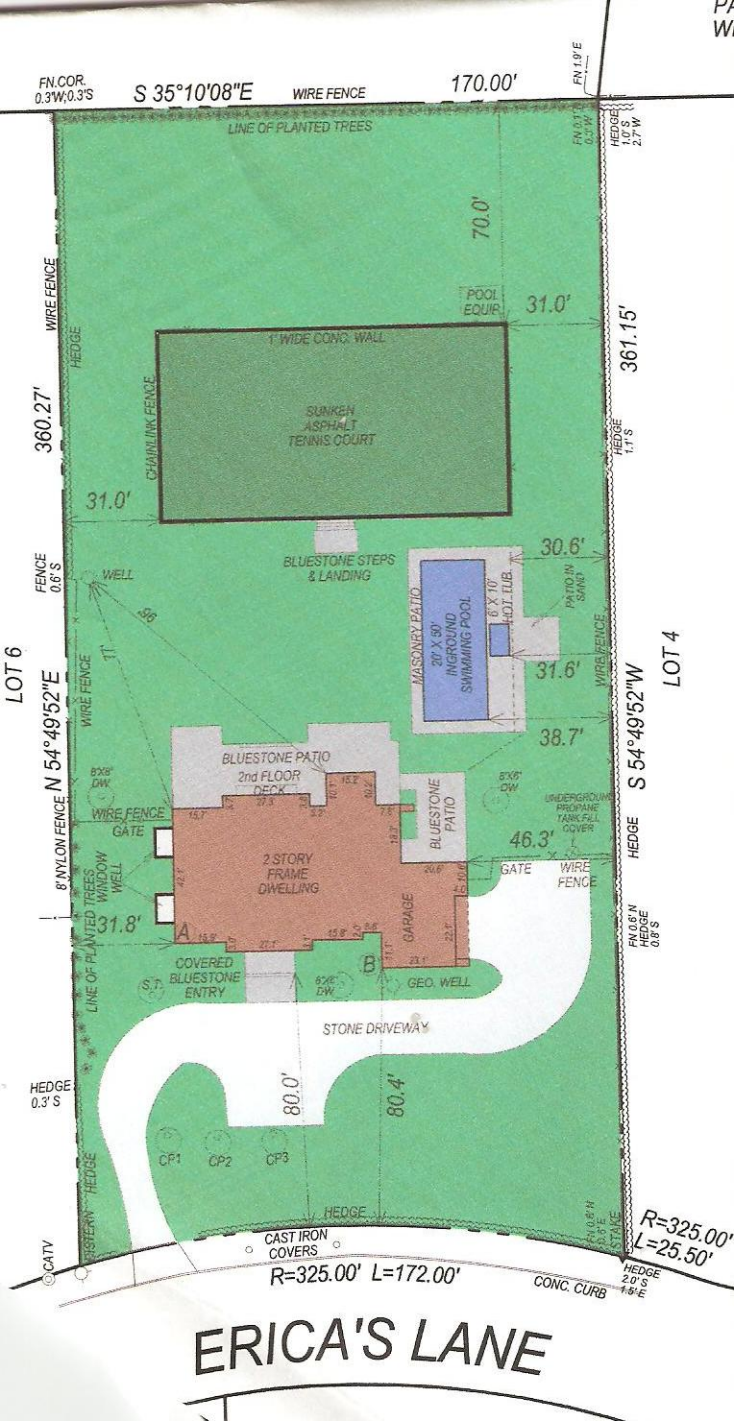
FN.COR. 0.3'W;0.3'S
S 35°10'08"E
WIRE FENCE
170.00'
FN 1.9' E
LINE OF PLANTED TREES
FN 0.1' E 0.2' W
HEDGE 1.0' S 2.7' W
70.0'
POOL EQUIP.
31.0'
361.15'
WIRE FENCE
HEDGE
1' WIDE CONC. WALL
CHAIN LINK FENCE
SUNKEN ASPHALT TENNIS COURT
360.27'
HEDGE 1.1' S
31.0'
30.6'
FENCE 0.6' S
WELL
BLUESTONE STEPS & LANDING
MASONRY PATIO
20' X 50' INGROUND SWIMMING POOL
6' X 10' HOT TUB
PATIO IN SAND
31.6'
WIRE FENCE
LOT 6
LOT 4
98'
11'
WIRE FENCE
38.7'
N 54°49'52"E
S 54°49'52"W
BLUESTONE PATIO
2nd FLOOR DECK
8'X6' DW
8'X6' DW
BLUESTONE PATIO
UNDERGROUND PROPANE TANK FILL COVER
WIRE FENCE GATE
8' NYLON FENCE
HEDGE
46.3'
GATE
WIRE FENCE
WINDOW WELL
2 STORY FRAME DWELLING
GARAGE
31.8'
A
B
FN 0.6' N HEDGE 0.6' S
LINE OF PLANTED TREES
COVERED BLUESTONE ENTRY
S.T.
8'X6' DW
GEO. WELL
STONE DRIVEWAY
HEDGE 0.3' S
80.0'
80.4'
CP1
CP2
CP3
HEDGE
CISTERN
HEDGE
HEDGE
FN 0.6' N 0.1' W
STAKE
R=325.00'
L=25.50'
CATV
CAST IRON COVERS
R=325.00' L=172.00'
CONC. CURB
HEDGE 2.0' S 1.6' E
ERICA'S LANE