S.C.T.M. # 901-004-04-4
AREA = 96,270 SF. = 2.2101 ACRES
SCALE: 1"=60'

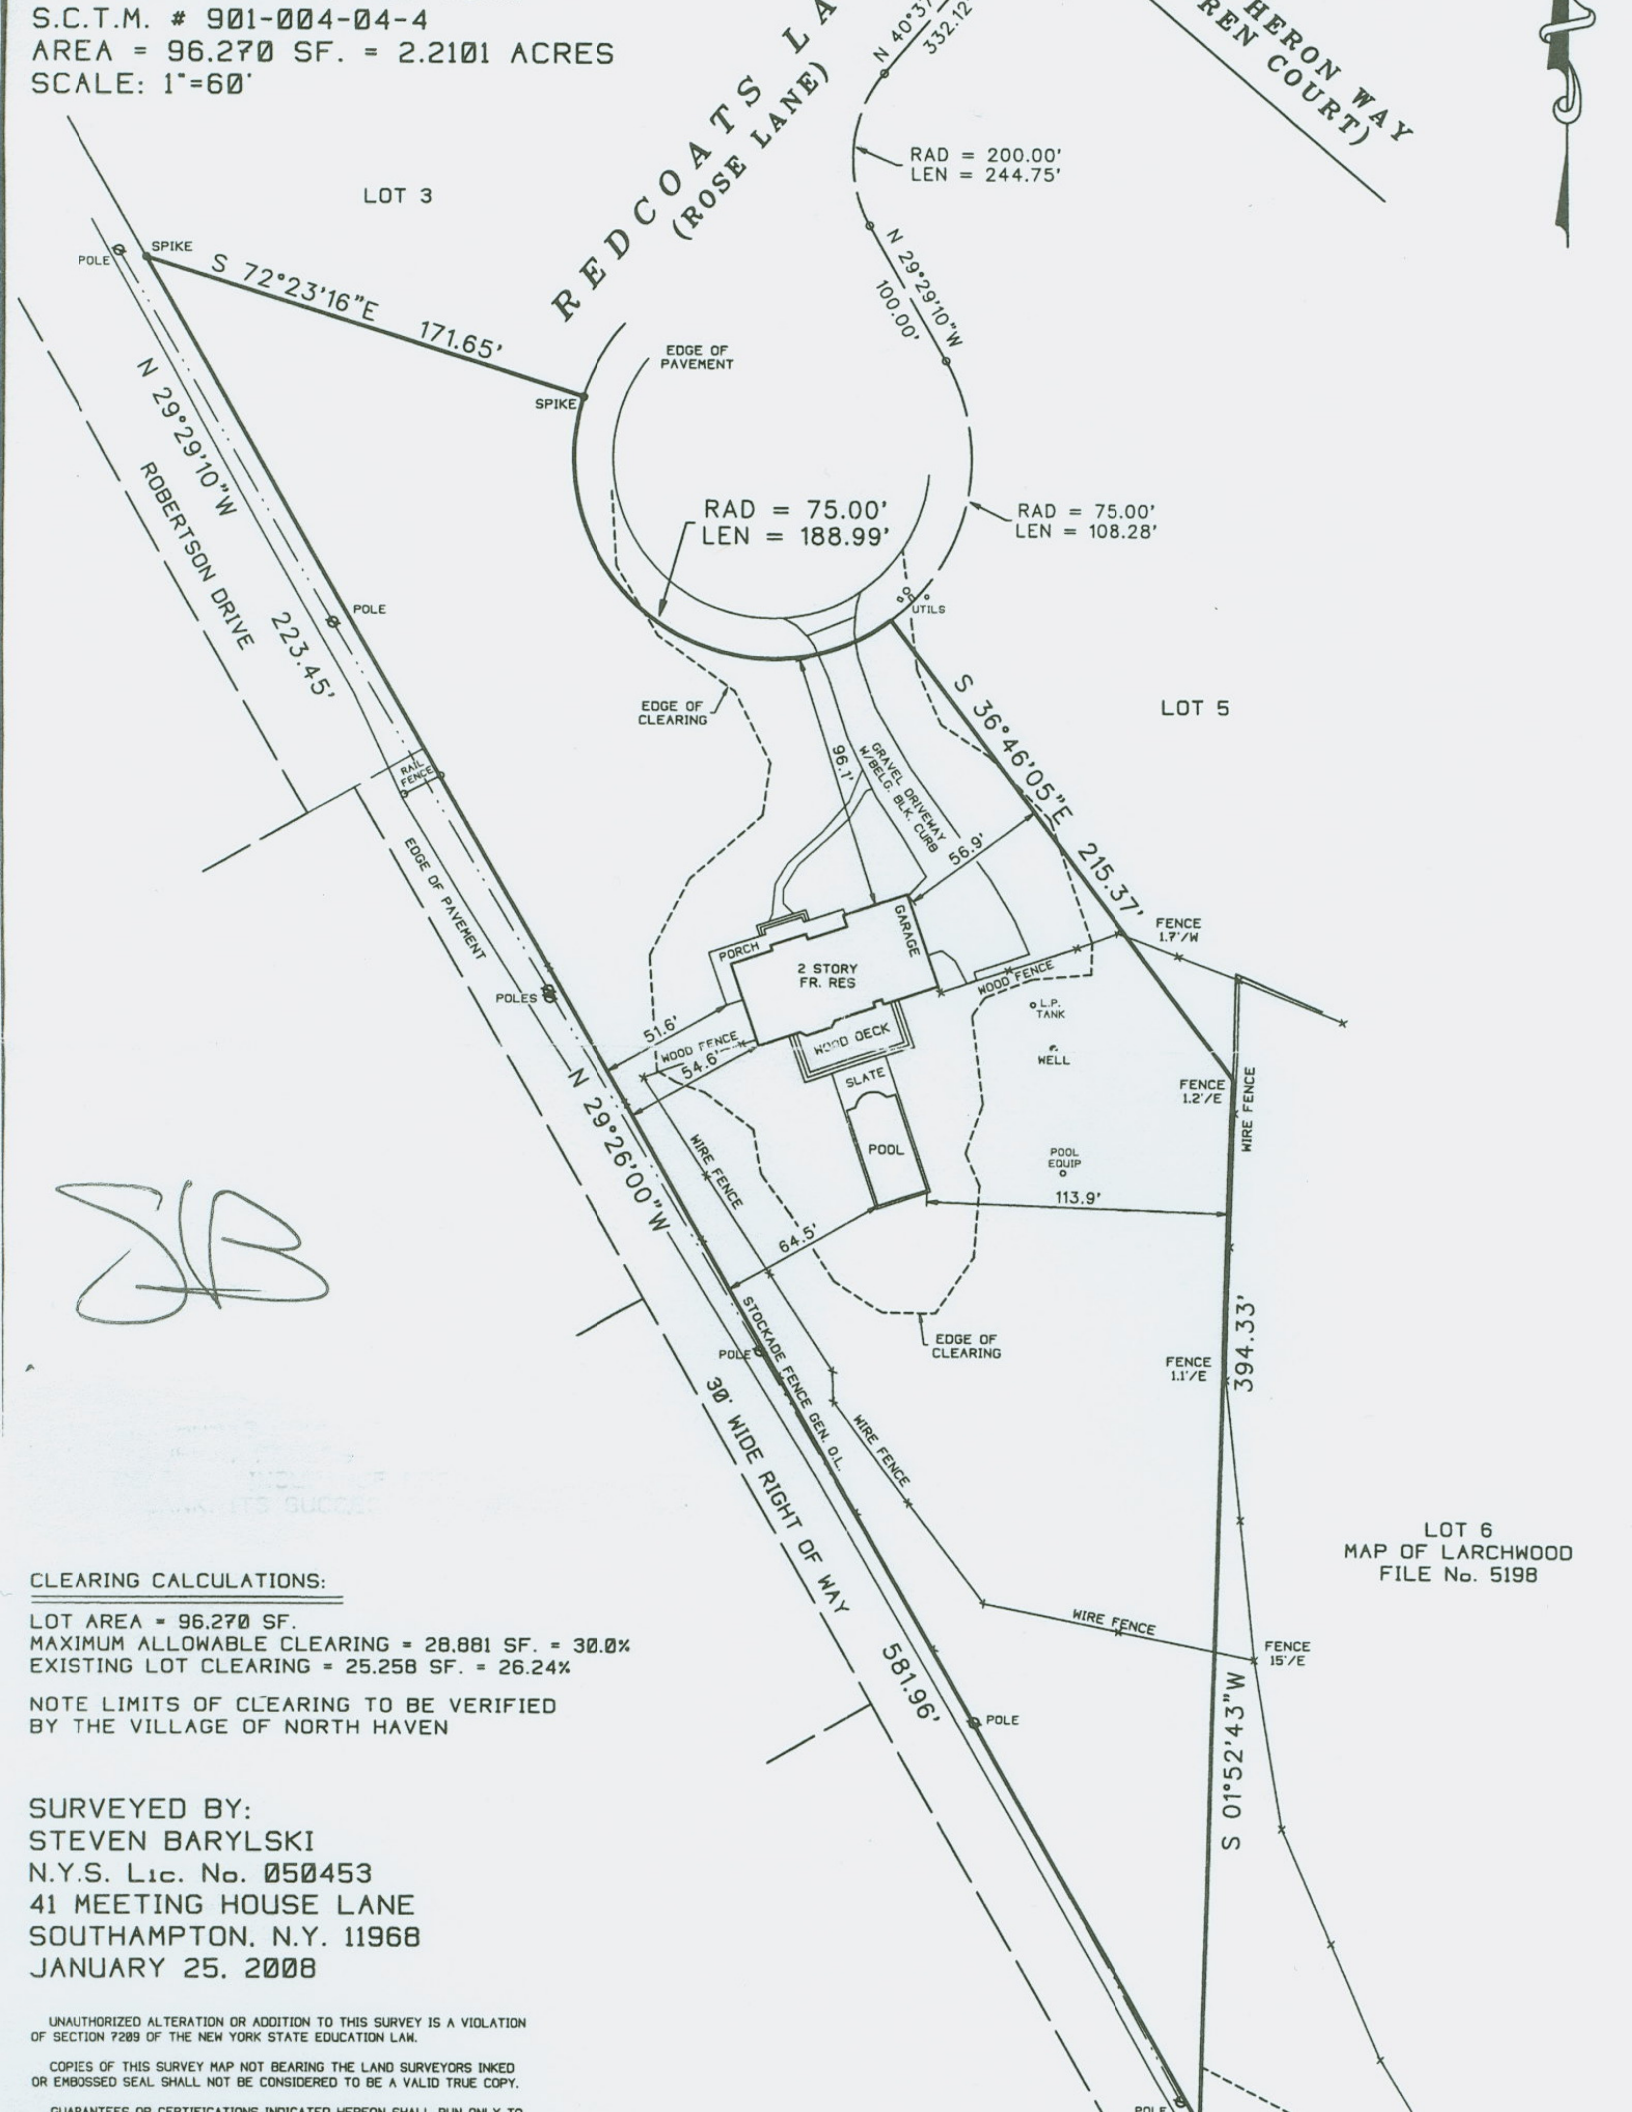

CLEARING CALCULATIONS:

LOT AREA = 96,270 SF.
MAXIMUM ALLOWABLE CLEARING = 28,881 SF. = 30.0%
EXISTING LOT CLEARING = 25,258 SF. = 26.24%

NOTE LIMITS OF CLEARING TO BE VERIFIED BY THE VILLAGE OF NORTH HAVEN

SURVEYED BY:
STEVEN BARYLSKI
N.Y.S. Lic. No. 050453
41 MEETING HOUSE LANE
SOUTHAMPTON, N.Y. 11968
JANUARY 25, 2008

UNAUTHORIZED ALTERATION OR ADDITION TO THIS SURVEY IS A VIOLATION OF SECTION 7209 OF THE NEW YORK STATE EDUCATION LAW.

COPIES OF THIS SURVEY MAP NOT BEARING THE LAND SURVEYORS INKED OR EMBOSSED SEAL SHALL NOT BE CONSIDERED TO BE A VALID TRUE COPY.

GUARANTEES OR CERTIFICATIONS INDICATED HEREON SHALL RUN ONLY TO