


WETLANDS BOUNDARY AS FLAGGED
BY THE TOWN OF SOUTHAMPTON
ENVIRONMENT DIVISION ON JULY 29,
2015.

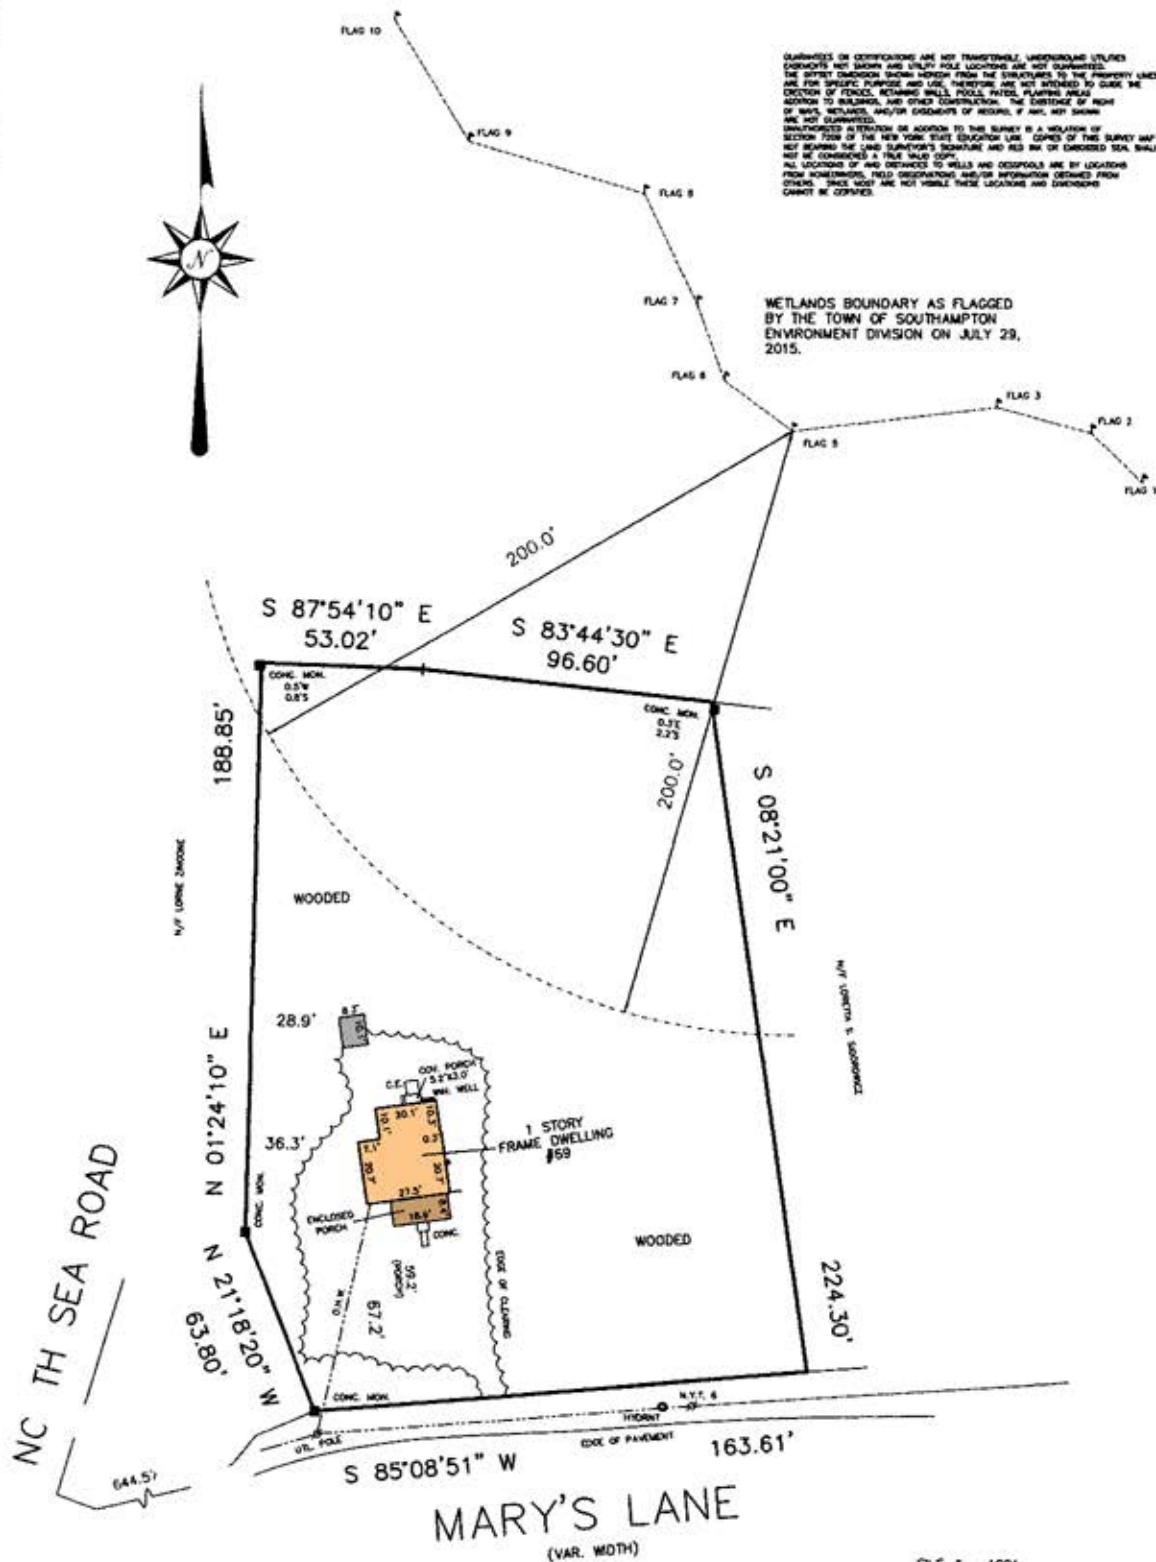

SCALE: 1" = 40'

N.Y.S. LIC. NO. 050906
149 HAMPTON ROAD
SOUTHAMPTON, NY 11968
PH 631-283-5500 FAX 631-283-3228
COPYRIGHT - 2015 COLONIAL SURFACING, INC.