JOB No. 14497 ~ (E6542) A6445

SUFFOLK COUNTY TAX MAP

DISTRICT	0904
SECTION	012.00
BLOCK	03.00
PARCEL	028.002

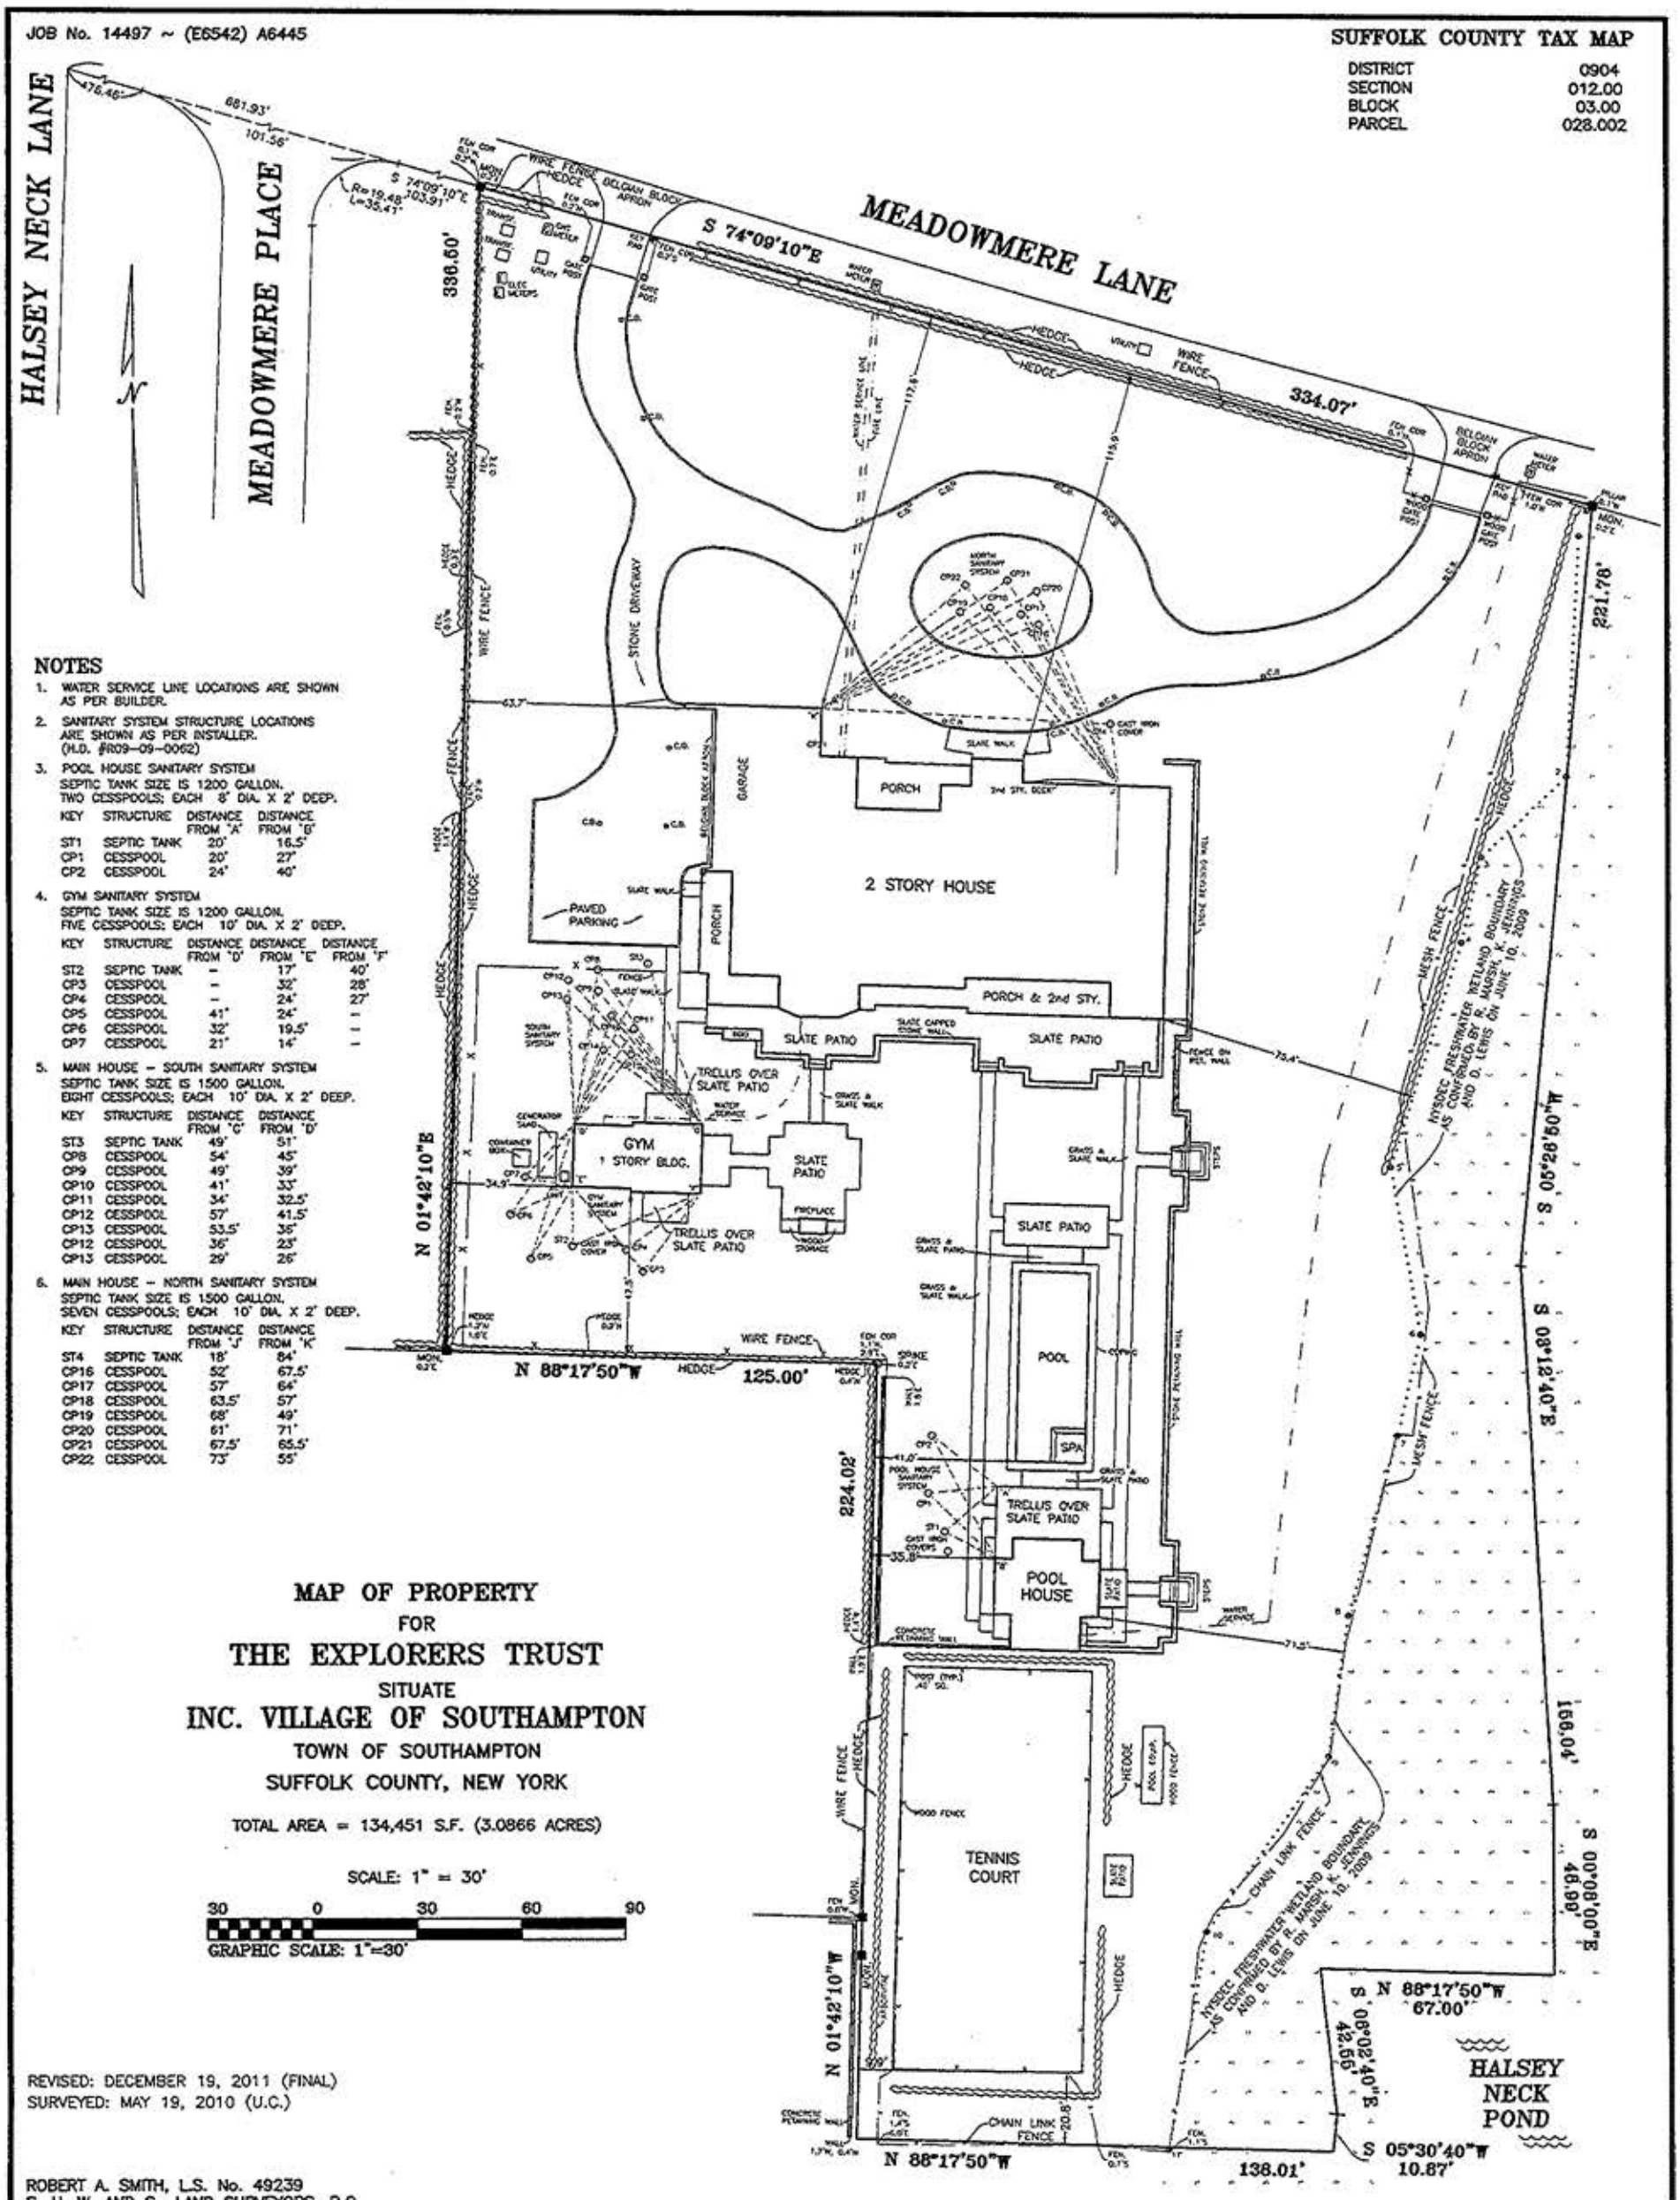

NOTES

1. WATER SERVICE LINE LOCATIONS ARE SHOWN AS PER BUILDER.
2. SANITARY SYSTEM STRUCTURE LOCATIONS ARE SHOWN AS PER INSTALLER. (H.D. #R09-09-0062)
3. POOL HOUSE SANITARY SYSTEM
   SEPTIC TANK SIZE IS 1200 GALLON.
   TWO CESSPOOLS; EACH 8' DIA. X 2' DEEP.

KEY	STRUCTURE	DISTANCE FROM 'A'	DISTANCE FROM 'G'
ST1	SEPTIC TANK	20'	16.5'
CP1	CESSPOOL	20'	27'
CP2	CESSPOOL	24'	40'

4. GYM SANITARY SYSTEM
   SEPTIC TANK SIZE IS 1200 GALLON.
   FIVE CESSPOOLS; EACH 10' DIA. X 2' DEEP.

KEY	STRUCTURE	DISTANCE FROM 'D'	DISTANCE FROM 'E'	DISTANCE FROM 'F'
ST2	SEPTIC TANK	–	17'	40'
CP3	CESSPOOL	–	32'	28'
CP4	CESSPOOL	–	24'	27'
CP5	CESSPOOL	41'	24'	–
CP6	CESSPOOL	32'	19.5'	–
CP7	CESSPOOL	21'	14'	–

5. MAIN HOUSE – SOUTH SANITARY SYSTEM
   SEPTIC TANK SIZE IS 1500 GALLON.
   EIGHT CESSPOOLS; EACH 10' DIA. X 2' DEEP.

KEY	STRUCTURE	DISTANCE FROM 'C'	DISTANCE FROM 'D'
ST3	SEPTIC TANK	49'	51'
CP8	CESSPOOL	54'	45'
CP9	CESSPOOL	49'	39'
CP10	CESSPOOL	41'	33'
CP11	CESSPOOL	34'	32.5'
CP12	CESSPOOL	57'	41.5'
CP13	CESSPOOL	53.5'	36'
CP12	CESSPOOL	36'	23'
CP13	CESSPOOL	29'	26'

6. MAIN HOUSE – NORTH SANITARY SYSTEM
   SEPTIC TANK SIZE IS 1500 GALLON.
   SEVEN CESSPOOLS; EACH 10' DIA. X 2' DEEP.

KEY	STRUCTURE	DISTANCE FROM 'J'	DISTANCE FROM 'K'
ST4	SEPTIC TANK	18'	84'
CP16	CESSPOOL	52'	67.5'
CP17	CESSPOOL	57'	64'
CP18	CESSPOOL	63.5'	57'
CP19	CESSPOOL	68'	49'
CP20	CESSPOOL	61'	71'
CP21	CESSPOOL	67.5'	65.5'
CP22	CESSPOOL	73'	55'

MAP OF PROPERTY
FOR
THE EXPLORERS TRUST
SITUATE
INC. VILLAGE OF SOUTHAMPTON
TOWN OF SOUTHAMPTON
SUFFOLK COUNTY, NEW YORK

TOTAL AREA = 134,451 S.F. (3.0866 ACRES)

SCALE: 1" = 30'

30 0 30 60 90
GRAPHIC SCALE: 1"=30'

REVISED: DECEMBER 19, 2011 (FINAL)
SURVEYED: MAY 19, 2010 (U.C.)

ROBERT A. SMITH, L.S. No. 49239
S. H. W. AND S., LAND SURVEYORS, P.C.
SQUIRES, HOLDEN, WEISENBACHER and SMITH
LAND SURVEYING ~ LAND PLANNING ~ ENGINEERING
SOUTHAMPTON ~ NEW YORK