



SUFFOLK COUNTY TAX MAP

DISTRICT 0800  
SECTION 130.00  
BLOCK 01.00  
PARCEL 011.001

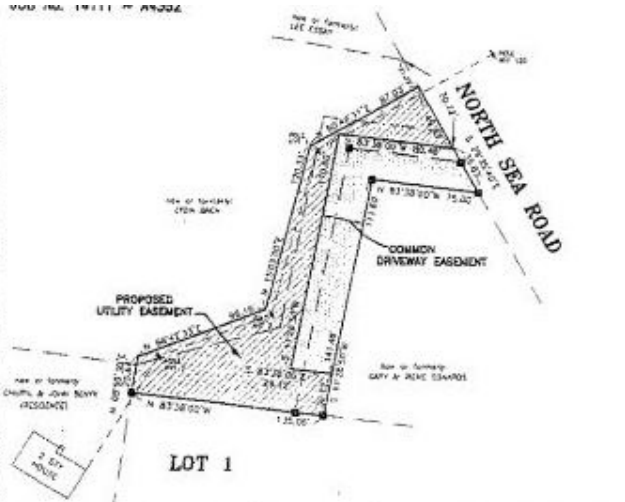

DETAIL OF UTILITY AND COMMON DRIVEWAY EASEMENTS  
SCALE: 1" = 60'

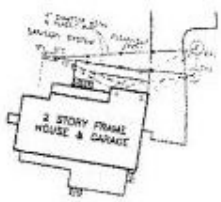

SANITARY STRUCTURE LOCATIONS  
SCALE: 1" = 50'

SANITARY SYSTEM STRUCTURE LOCATIONS ARE SHOWN AS PER ACTUAL FIELD SURVEY.

STRUCTURE	DISTANCE FROM 'A'	DISTANCE FROM 'B'
ST1	42.78'	64.55'
ST2	37.72'	59.38'
CP1	55.82'	39.45'
CP2	48.88'	28.51'

MAP OF LOT No. 1

MAP No. 11253 ~ FILED: APR. 29, 2005

NORTH SEA  
TOWN OF SOUTHAMPTON  
SUFFOLK COUNTY, NEW YORK


AREA= 87,553 S.F. (2.010 ACRES)  
SCALE: 1" = 50'

TOWN OF SOUTHAMPTON  
CONSERVATION BOARD  
WETLANDS FLAGS

REVISED: AUGUST 13, 2014 (REV. SANITARY LABELS)  
REVISED: JUNE 13, 2014 (FINAL)  
REVISED: AUGUST 21, 2007 (FINAL & SAN. LOC.)  
SURVEYED: AUGUST 12, 2007



ROBERT A. SMITH, L.S. No. 49239  
S. H. W. and S. LAND SURVEYORS, P.C.  
**SQUIRES, HOLDEN, WEISENBACHER & SMITH**  
LAND SURVEYING ~ LAND PLANNING ~ ENGINEERING  
SOUTHAMPTON ~ NEW YORK

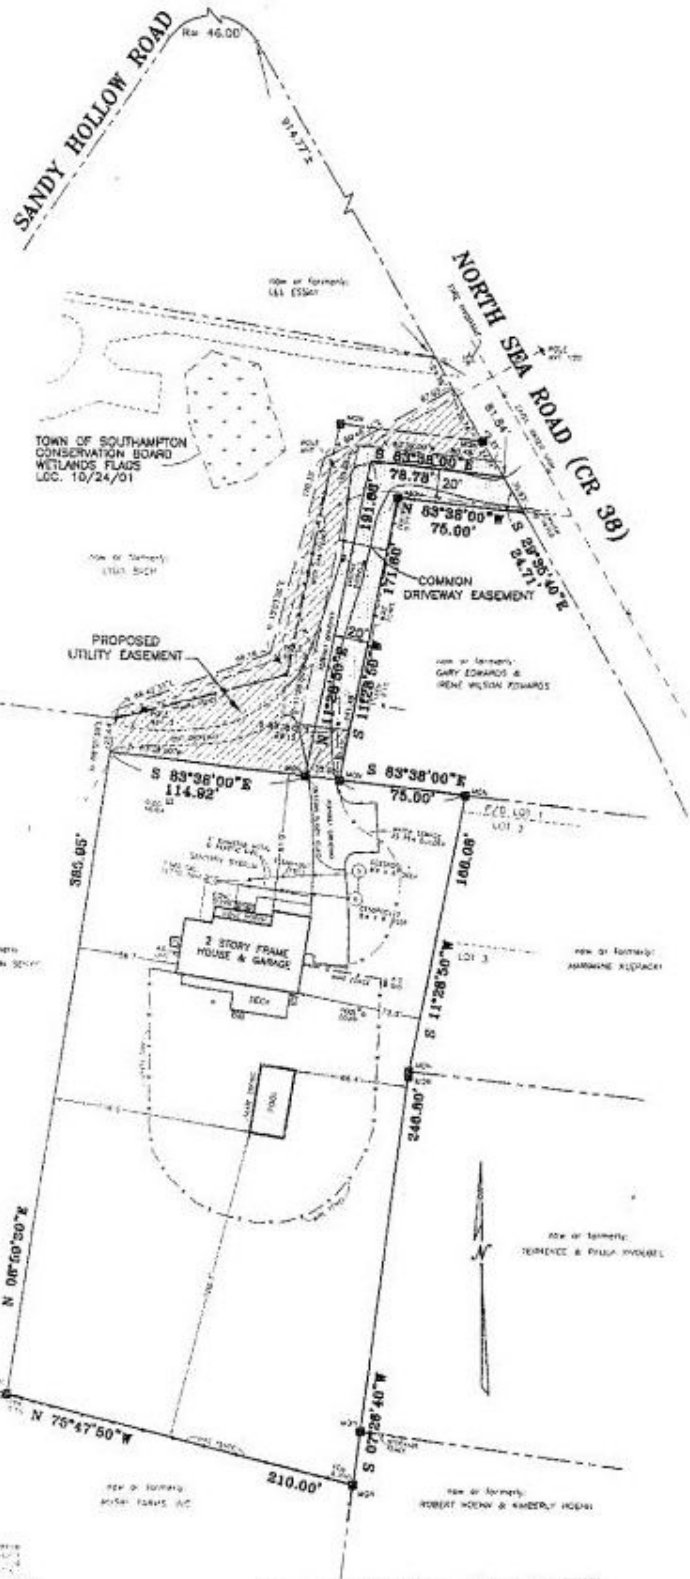

SUFFOLK COUNTY DEPARTMENT OF HEALTH SERVICES  
APPROVAL OF CONSTRUCTION WORKS FOR  
A RESIDENT ADDRESS  
Date: DEC 3 2004 MS. NO. 103-103-0011  
The signed report of this project and the project files have been  
accepted under conditions of approval. The project files will be  
be satisfactory for the purpose of the project.  
Walter J. P...  
Office of Wastewater Management