


PART OF LOT No. 2
now or formerly:

DISTRICT
SECTION
BLOCK
PARCEL

0900
234.00
01.00
016.000

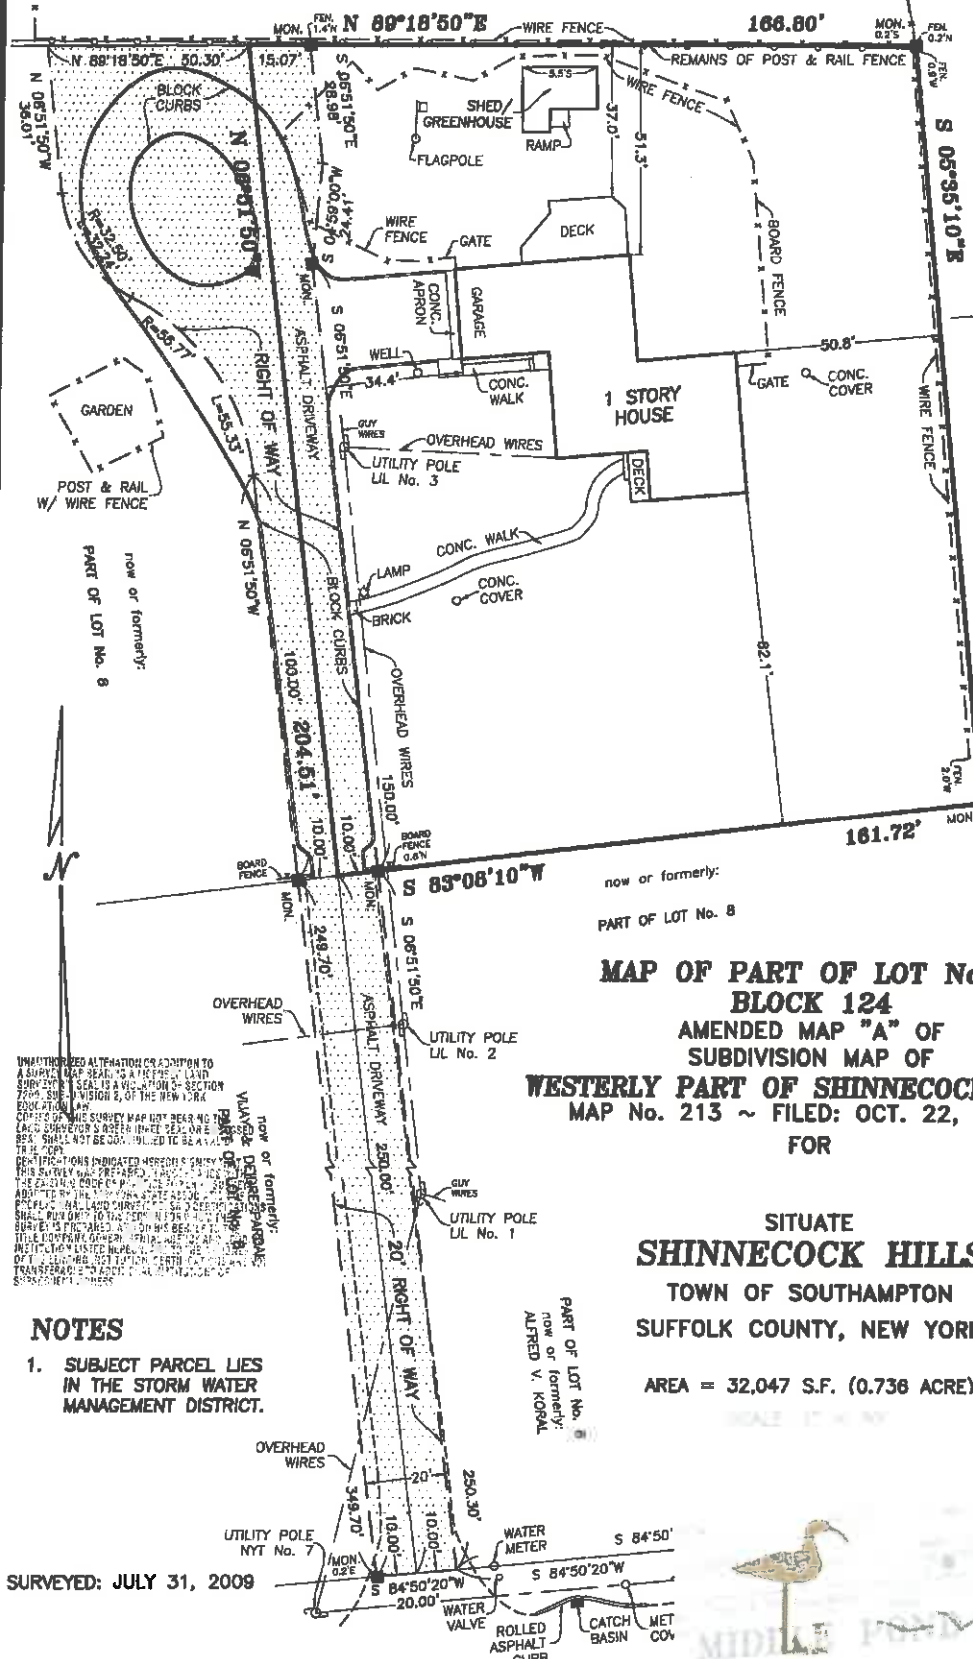

LOT No. 27
now or formerly:
SUBDIVISION MAP OF SURREY DOWNS
MAP No. 2498 ~ FILED: DECEMBER 5, 1985

LOT No. 28
now or formerly:
ARLETTE B. STERN LIVING TRUST
186.61'

LOT No. 25

**MAP OF PART OF LOT No. 8
BLOCK 124
AMENDED MAP "A" OF
SUBDIVISION MAP OF
WESTERLY PART OF SHINNECOCK HILLS**
MAP No. 213 ~ FILED: OCT. 22, 1925
FOR

**SITUATE
SHINNECOCK HILLS
TOWN OF SOUTHAMPTON
SUFFOLK COUNTY, NEW YORK**

AREA = 32,047 S.F. (0.736 ACRE)

LOT No. 23
now or formerly:
JOHN P. & CAROLYN
formerly: H. C. OLL

GEGAN DRIVE

NOTES
1. SUBJECT PARCEL LIES
IN THE STORM WATER
MANAGEMENT DISTRICT.

SURVEYED: JULY 31, 2009

