


NOTES

1. SUBJECT PARCEL IS WITHIN THE AQUIFER PROTECTION OVERLAY DISTRICT.
2. MAXIMUM ALLOWED CLEARED AREA = 35% OF OVERALL LOT SIZE, OR 29,845 S.F.
3. CURRENT CLEARED AREA MEASURES 25,064 S.F. OR 29.4% OF OVERALL LOT.
4. WELL & SANITARY SYSTEM LOCATIONS ARE AS PER OWNER.

DISTRICT	0900
SECTION	34.00
BLOCK	02.00
PARCEL	026.001

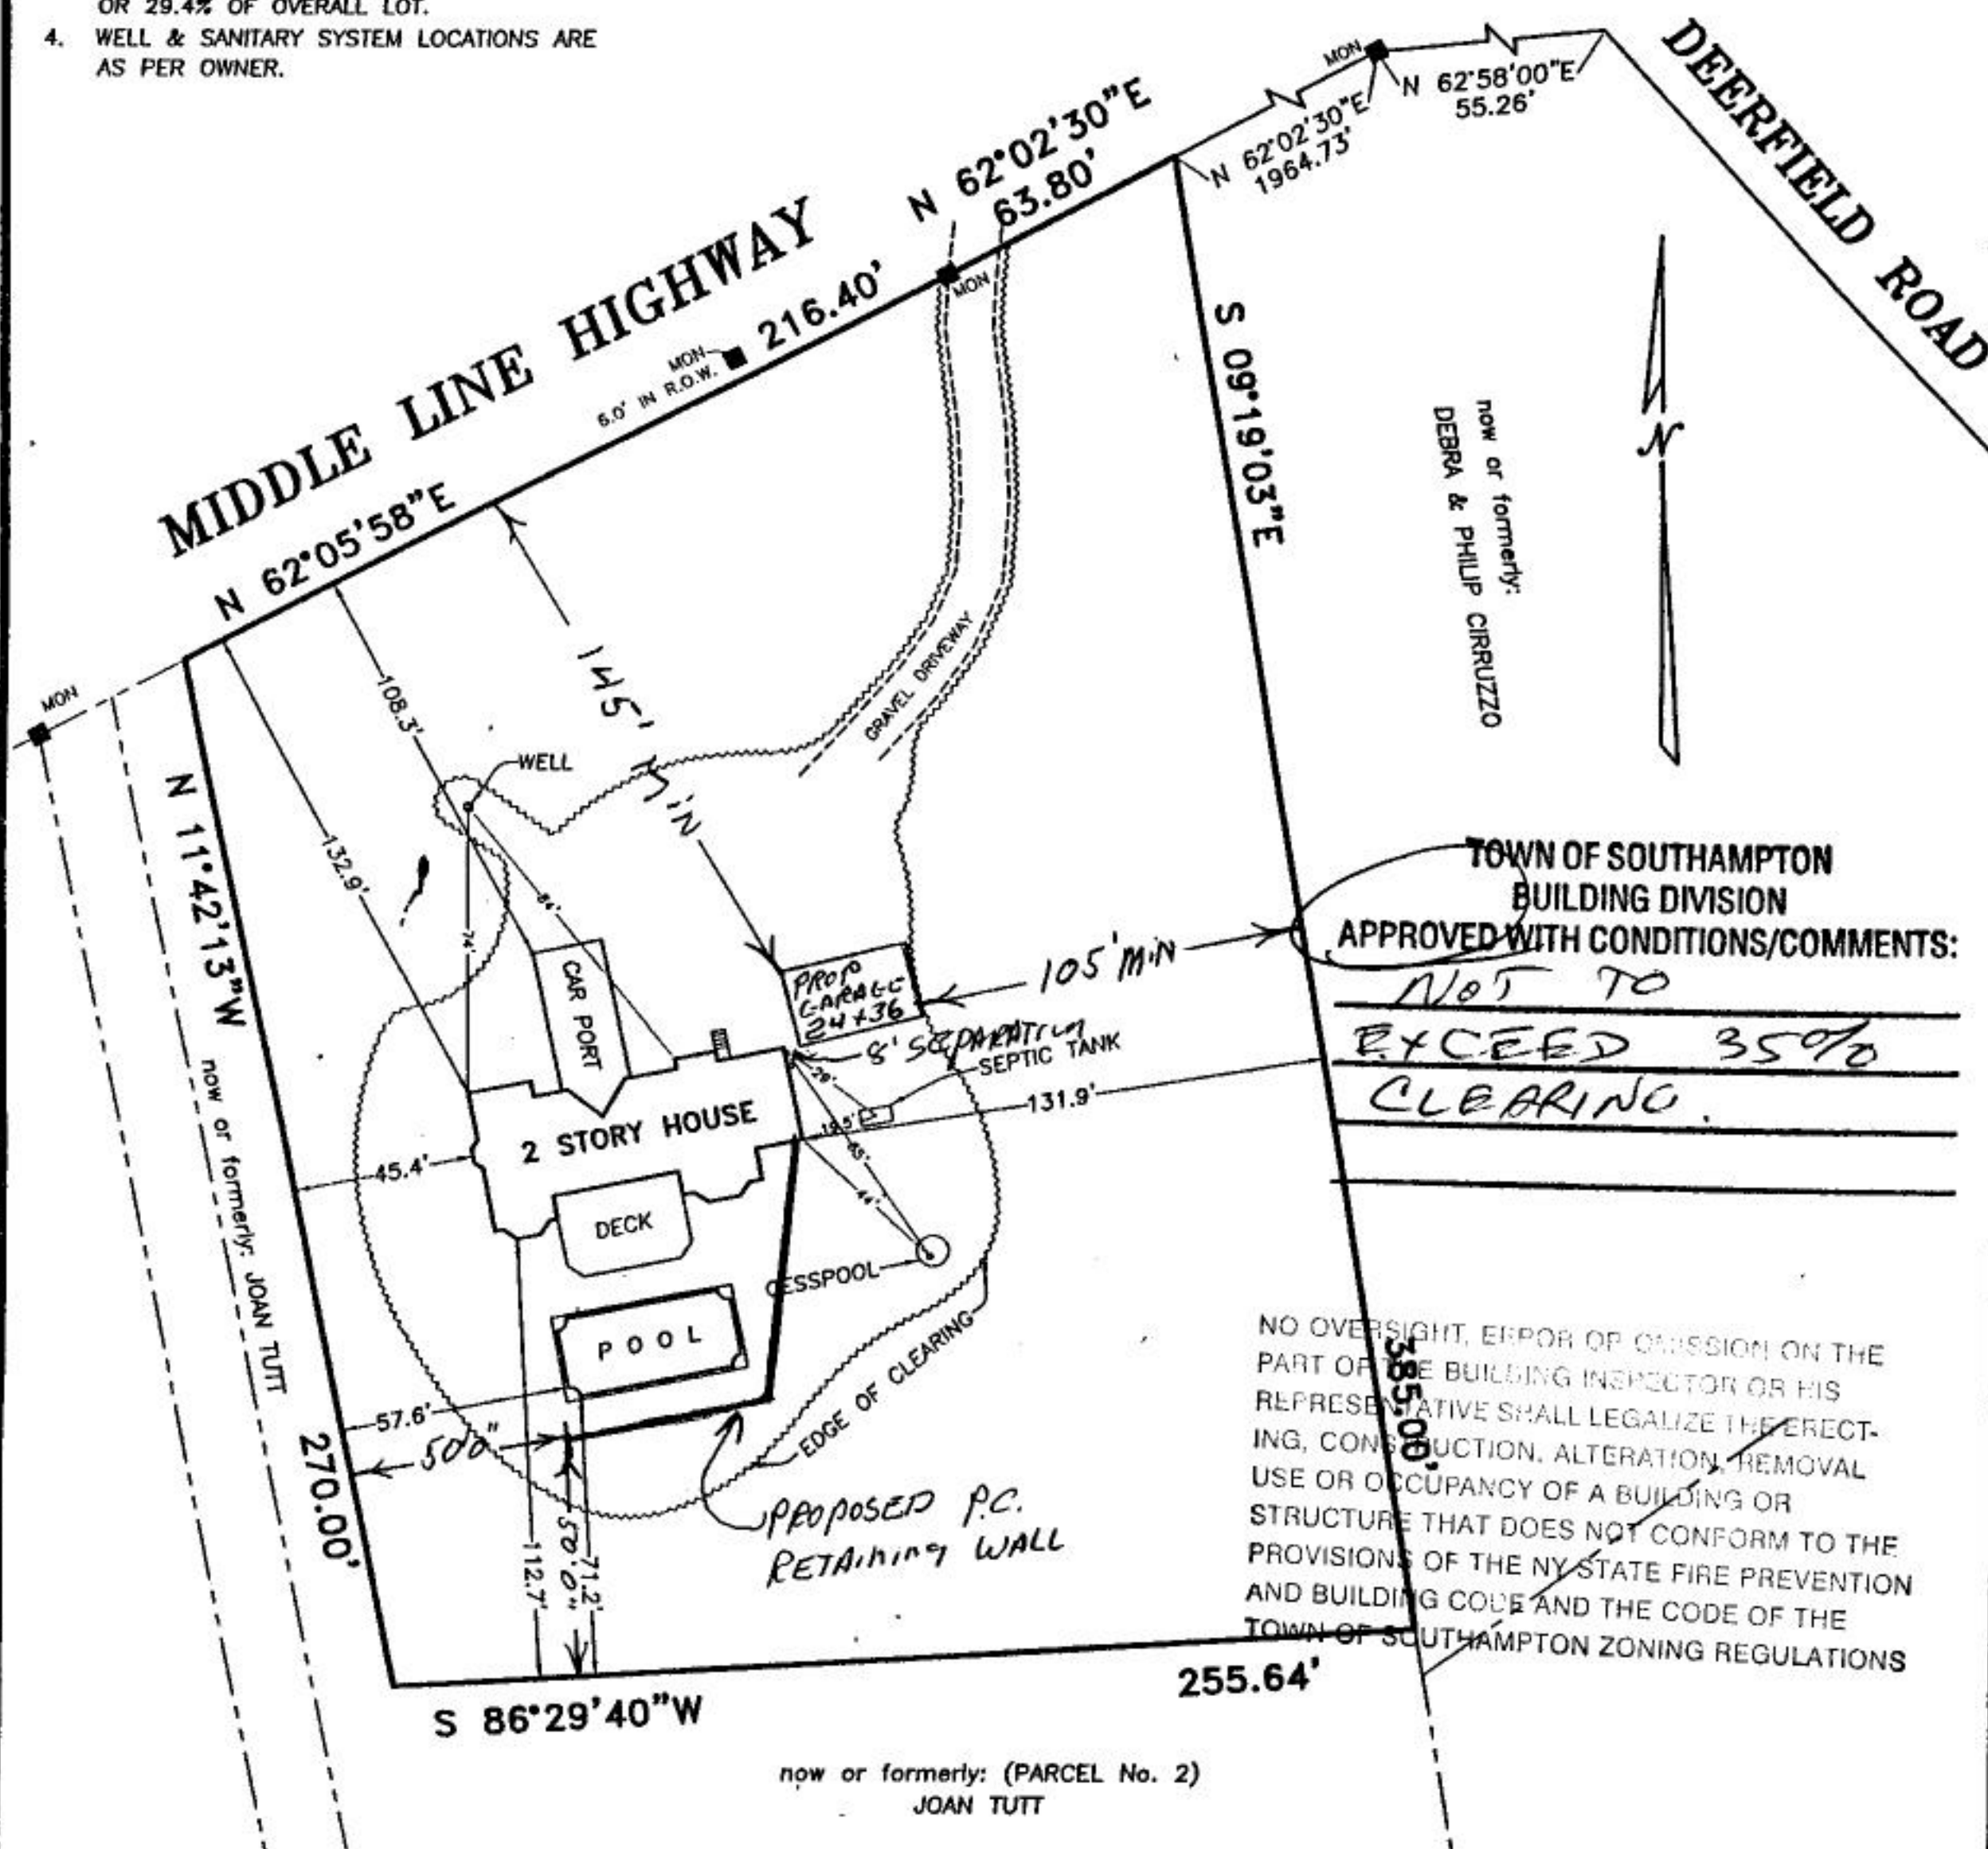

CERTIFIED TO:
CHARLES TUTT

[illegible]

REVISED: FEBRUARY 4, 2004 (FINAL)
SURVEYED: OCTOBER 7, 2002 (UNDER CONSTRUCTION)

KARL W. WEISENBACHER, L.S. No. 36195
S. H. W. & S. LAND SURVEYORS P.C.

SQUIRES, HOLDEN, WEISENBACHER & SMITH
LAND SURVEYORS ~ ENGINEERS
SOUTHAMPTON ~ NEW YORK

MAP OF PARCEL No. 1
MINOR SUBDIVISION MAP FOR
CHARLES TUTT
MAP No. 544 APPROVED: JUNE 18, 1981
FOR
CHARLES TUTT
SITUATE
NORTH SEA
TOWN OF SOUTHAMPTON
SUFFOLK COUNTY, NEW YORK

AREA = 85,272 S.F. (1.958 AC.)
SCALE: 1" = 50'