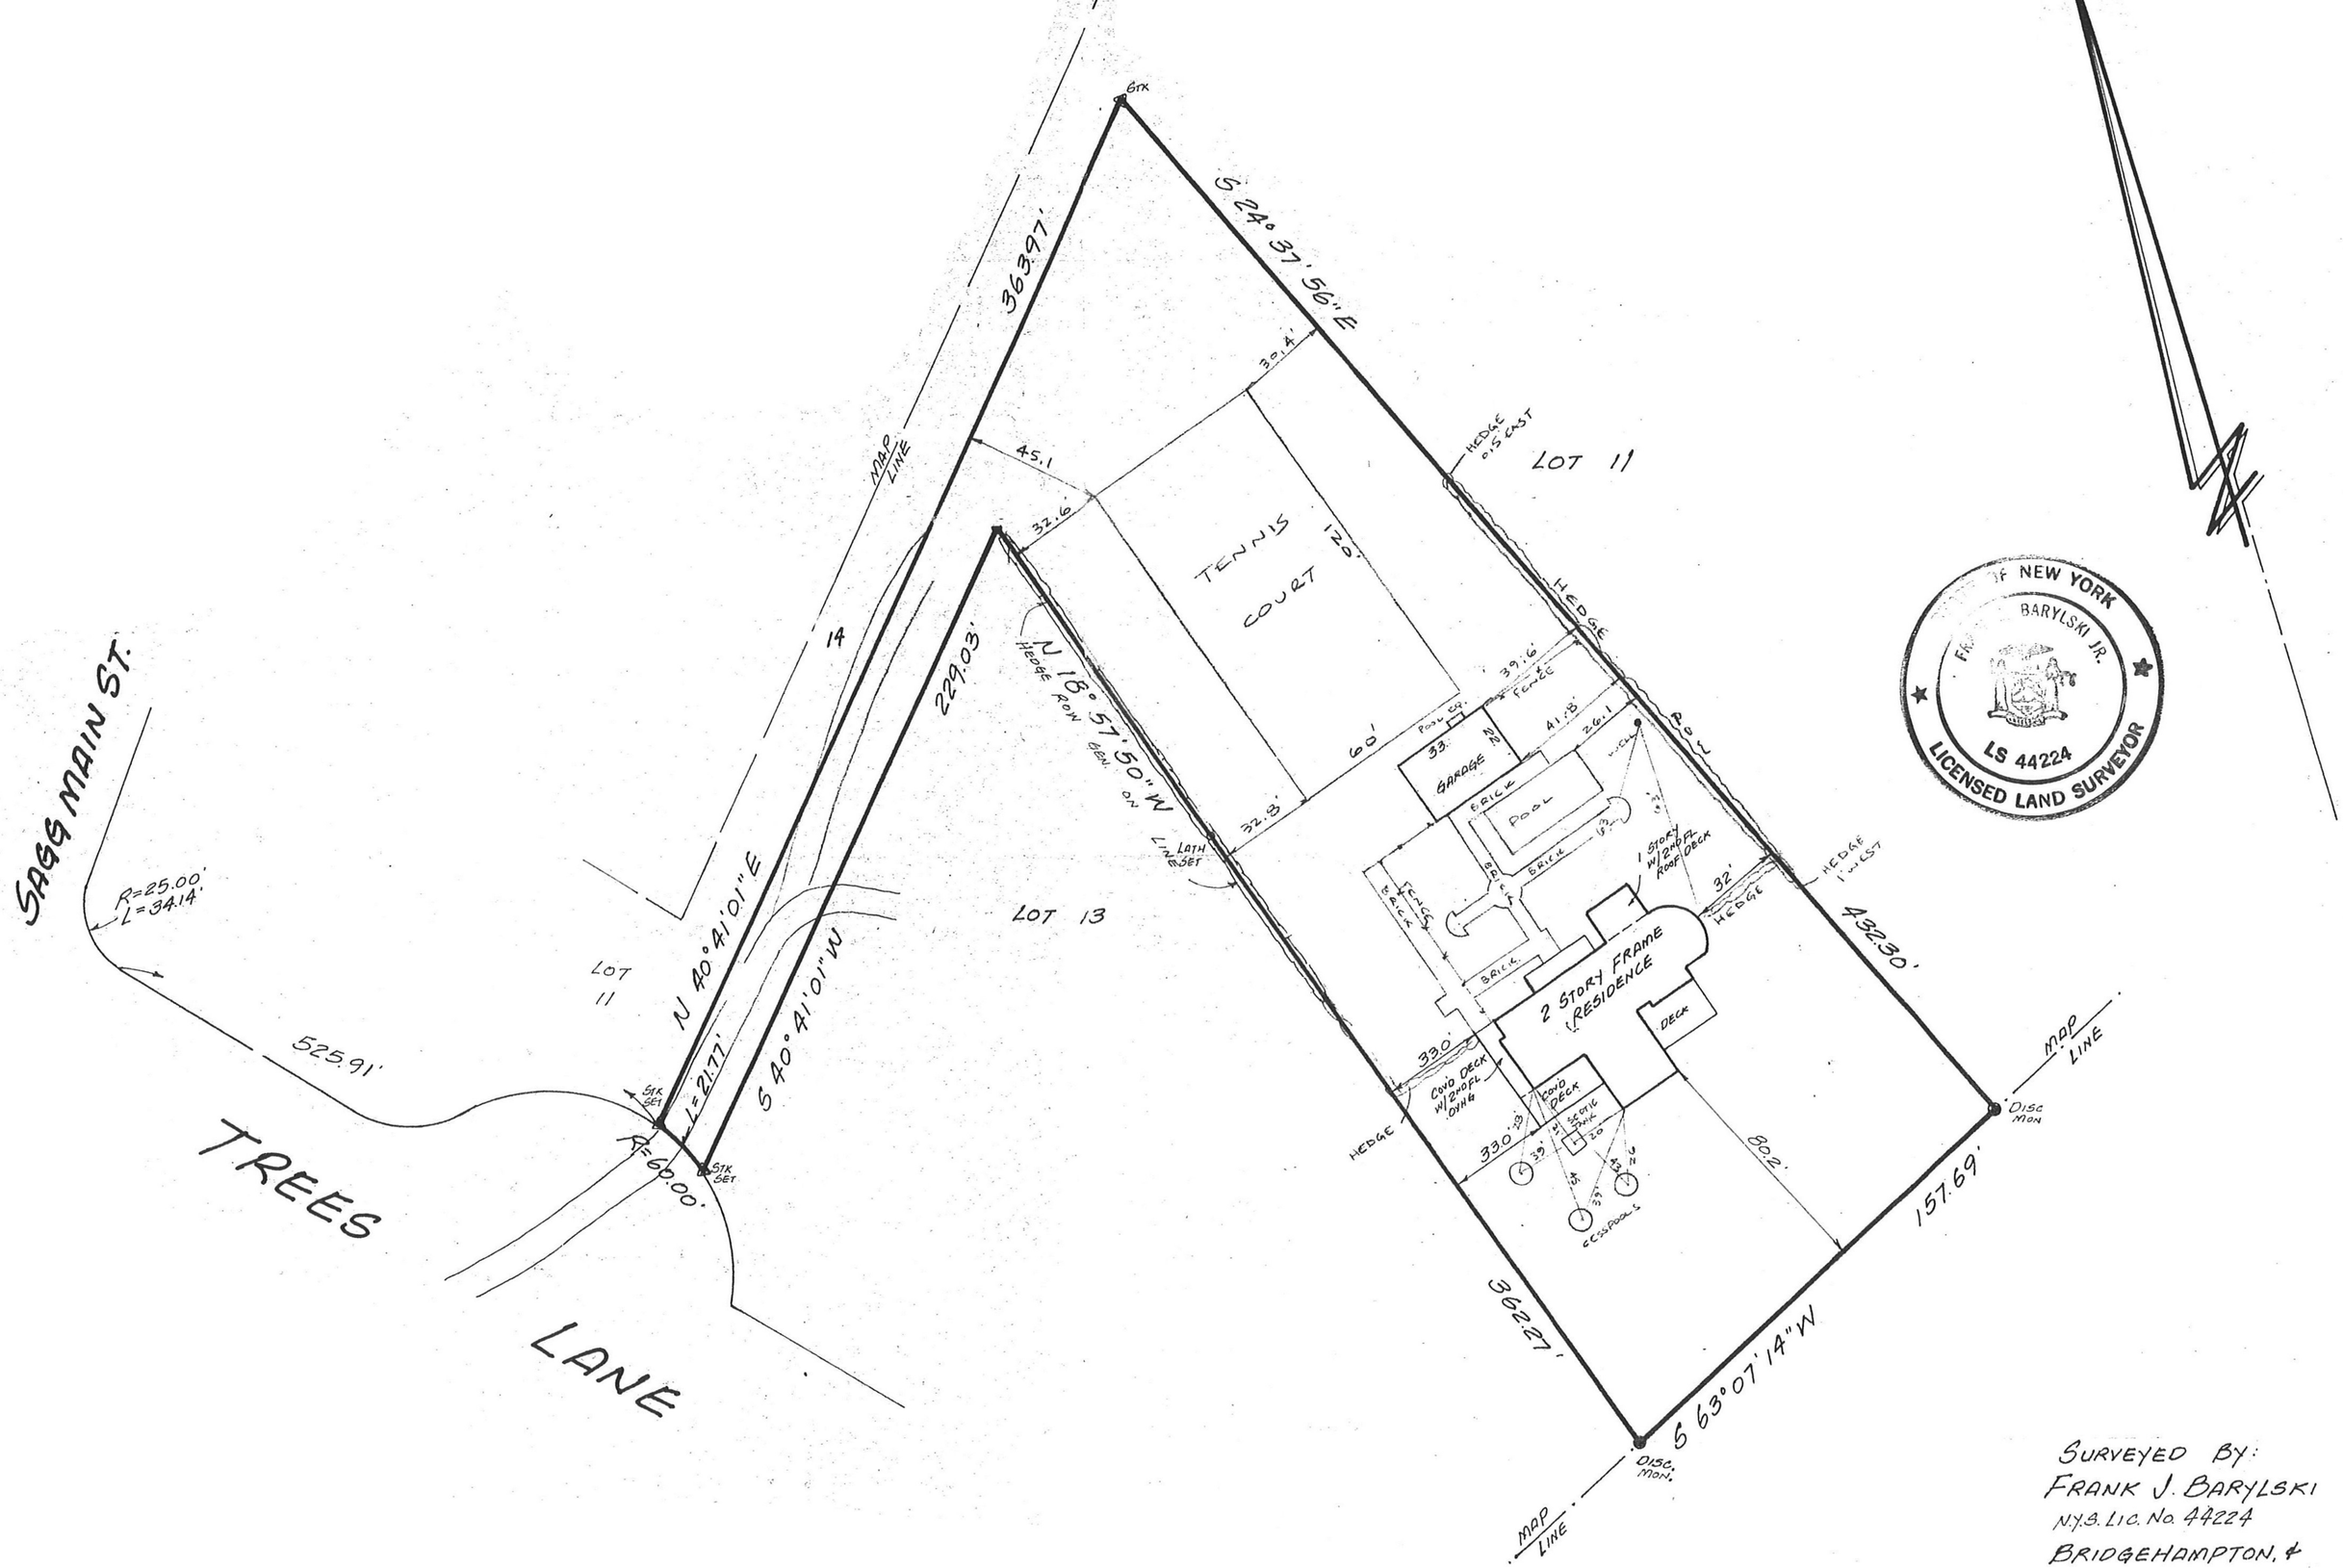

SURVEYED BY:
FRANK J. BARYLSKI
N.Y.S. LIC. No. 44224
BRIDGEHAMPTON, &
SAYVILLE, N.Y.