


SURVEYED FOR: CLAY DILWORTH
 PROPERTY LOCATED AT BRIDGEHAMPTON
 TOWN OF SOUTHAMPTON
 SUFFOLK COUNTY, NEW YORK
 S.C.T.M. # 900-085-01-13
 AREA = 40.216 SF. = 0.9232 ACRES
 SCALE: 1"=50'

NOTE: THE EXISTENCE OF RIGHT OF WAYS,
 WETLANDS AND/OR EASEMENTS OF RECORD
 IF ANY, NOT SHOWN ARE NOT GUARANTEED.

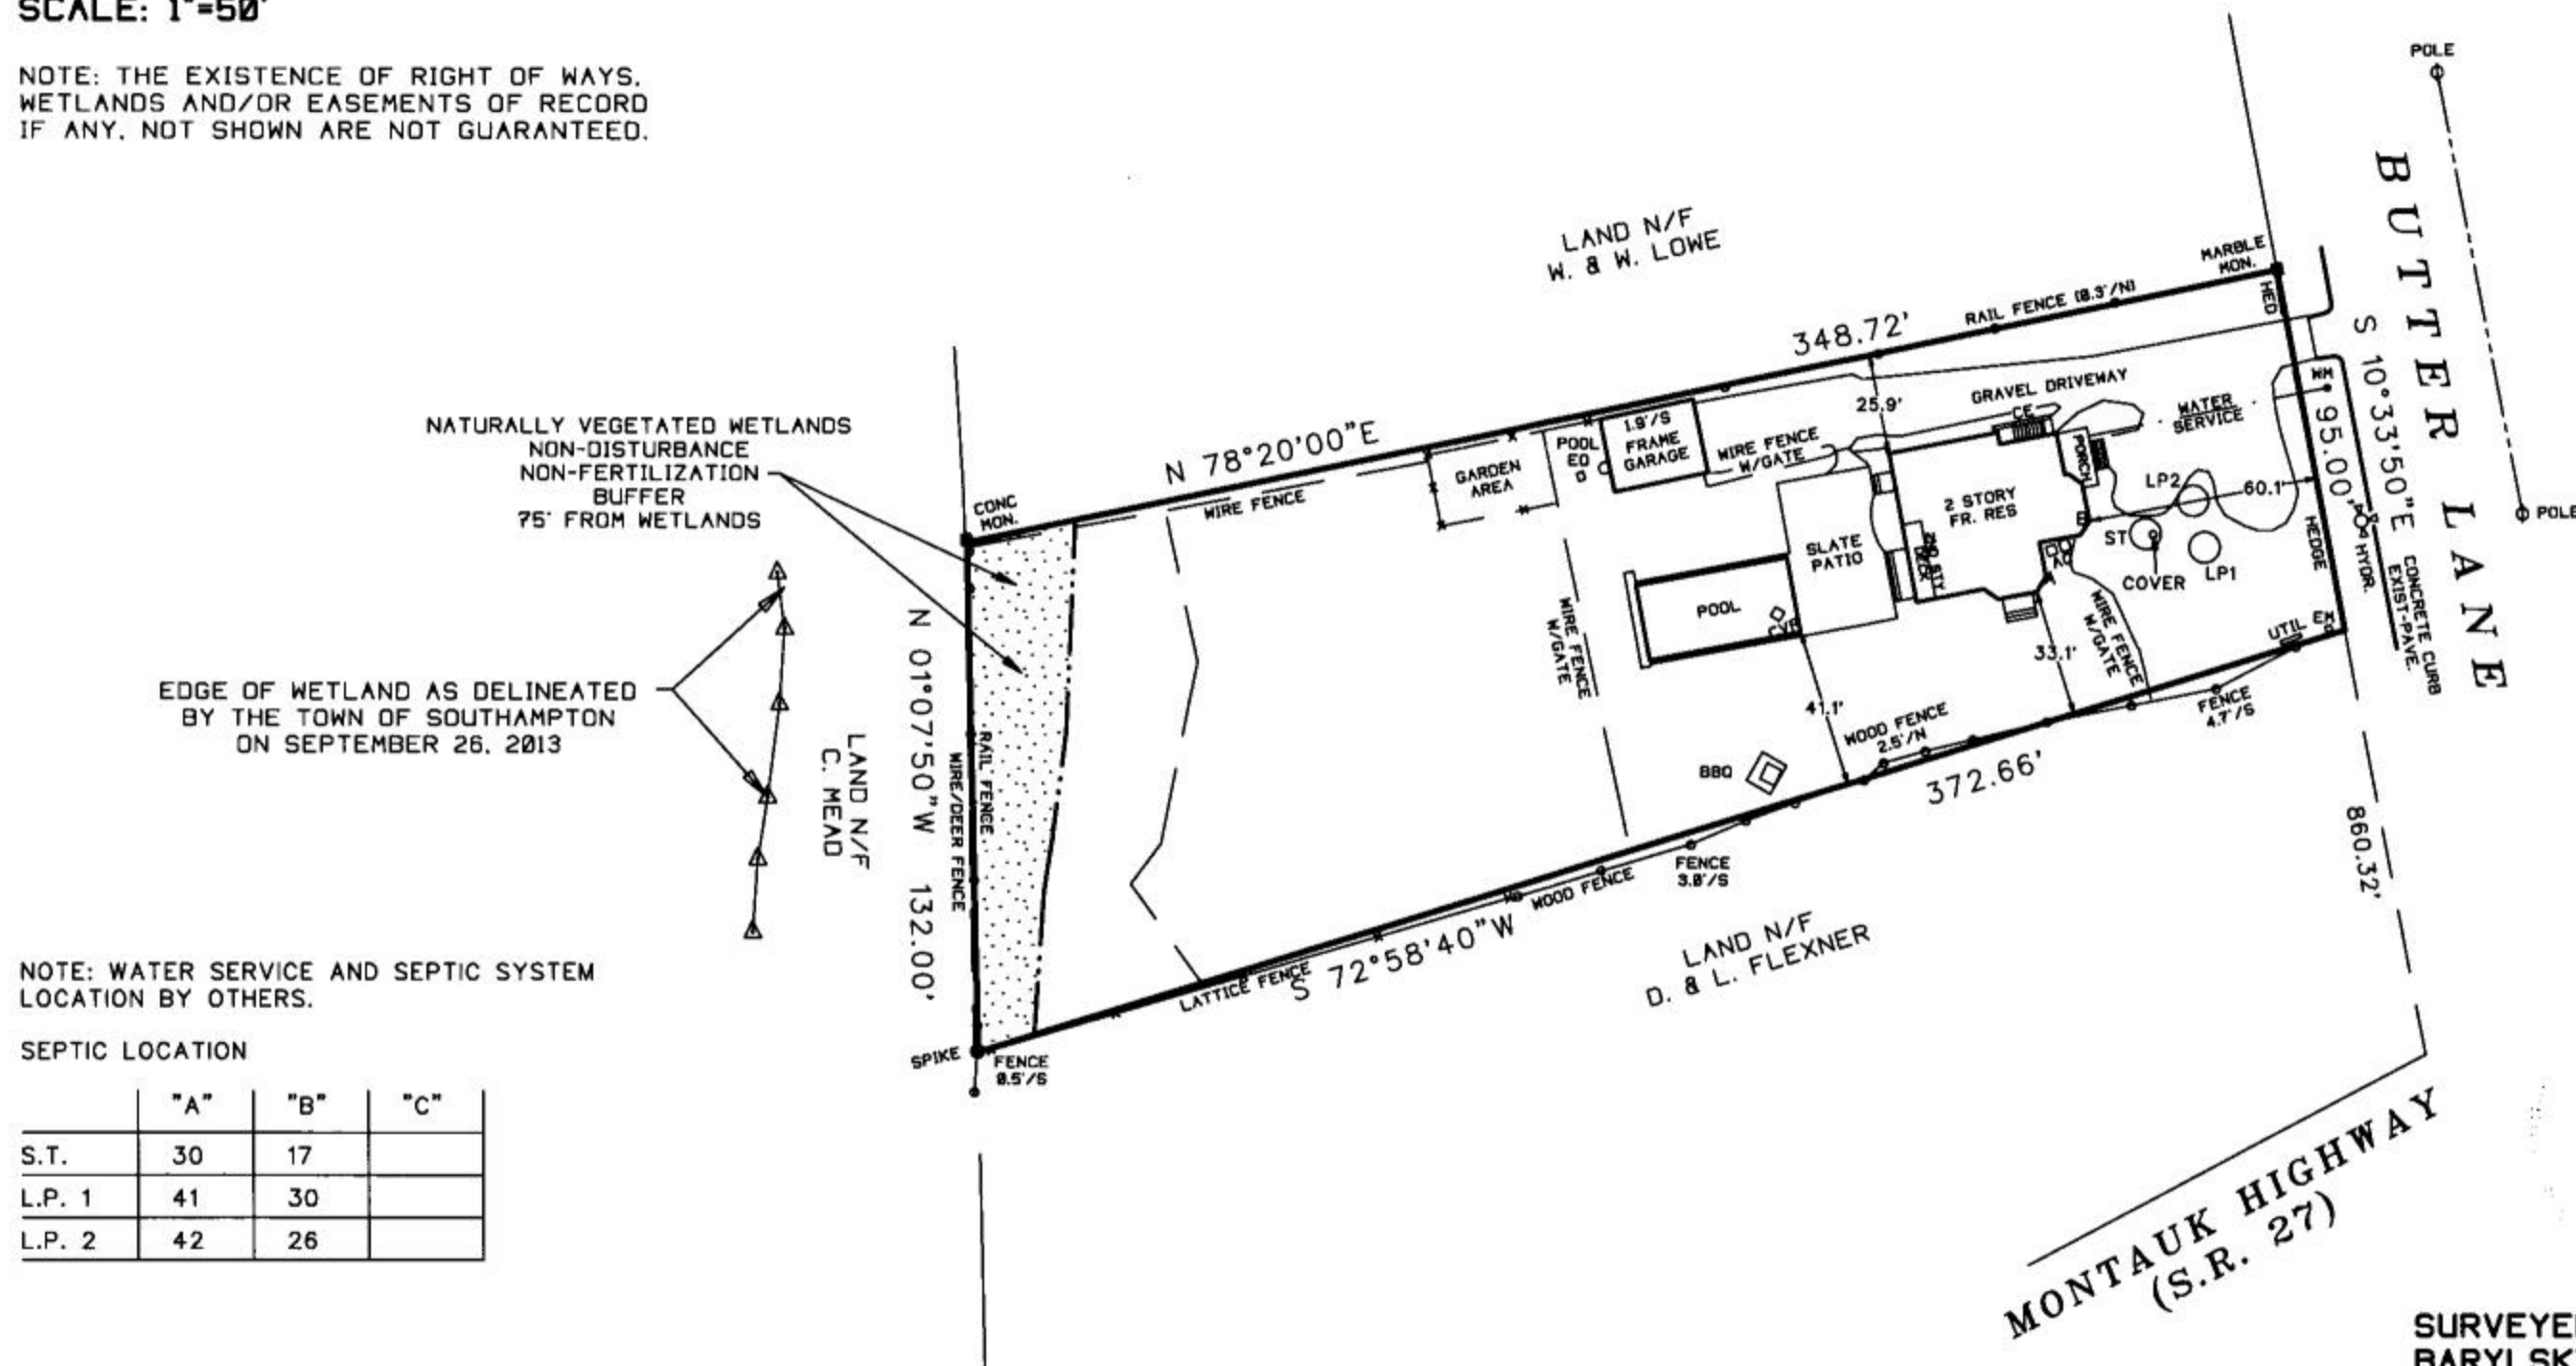

NOTE: WATER SERVICE AND SEPTIC SYSTEM
 LOCATION BY OTHERS.

SEPTIC LOCATION

	"A"	"B"	"C"
S.T.	30	17	
L.P. 1	41	30	
L.P. 2	42	26	

CERTIFIED TO:
 CLAY DILWORTH

John Baryl

22363-5852 (22363-2A)

UNAUTHORIZED ALTERATION OR ADDITION TO THIS SURVEY IS A VIOLATION
 OF SECTION 7209 OF THE NEW YORK STATE EDUCATION LAW.

COPIES OF THIS SURVEY MAP NOT BEARING THE LAND SURVEYORS INKED
 OR EMBOSSED SEAL SHALL NOT BE CONSIDERED TO BE A VALID TRUE COPY.

GUARANTEES OR CERTIFICATIONS INDICATED HEREON SHALL RUN ONLY TO
 THE PERSON FOR WHOM THE SURVEY IS PREPARED, AND ON HIS BEHALF TO
 THE TITLE COMPANY, GOVERNMENTAL AGENCY AND LENDING INSTITUTION
 LISTED HEREON, AND TO THE ASSIGNEES OF THE LENDING INSTITUTION.
 GUARANTEES OR CERTIFICATIONS ARE NOT TRANSFERABLE TO ADDITIONAL
 INSTITUTIONS OR SUBSEQUENT OWNERS.

SURVEYED BY:
 BARYLSKI LAND SURVEYING
 2320 MAIN ST. P.O. BOX 1302
 NEWMAN VILLAGE CONDO.
 BRIDGEHAMPTON, NEW YORK
 631-537-7944
 APRIL 11, 2012

11-3-2012: SITE PLAN
 11-6-2013: UPDATE: WETLAND LOCATION
 7-25-2016: FINAL SURVEY
 9-20-2016: REVISE SEPTIC LOCATION
 10-12-2016: ST COVER LOCATED - EXPOSED