

FLOORPLAN

Owner: STRACHAN, KEN

File No.: 47615

Property Address: 856 NARROW RIVER ROAD**


Case No.:

City: ORIENT

State: N.Y.

Zip: 11957

Lender: KEN STRACHAN

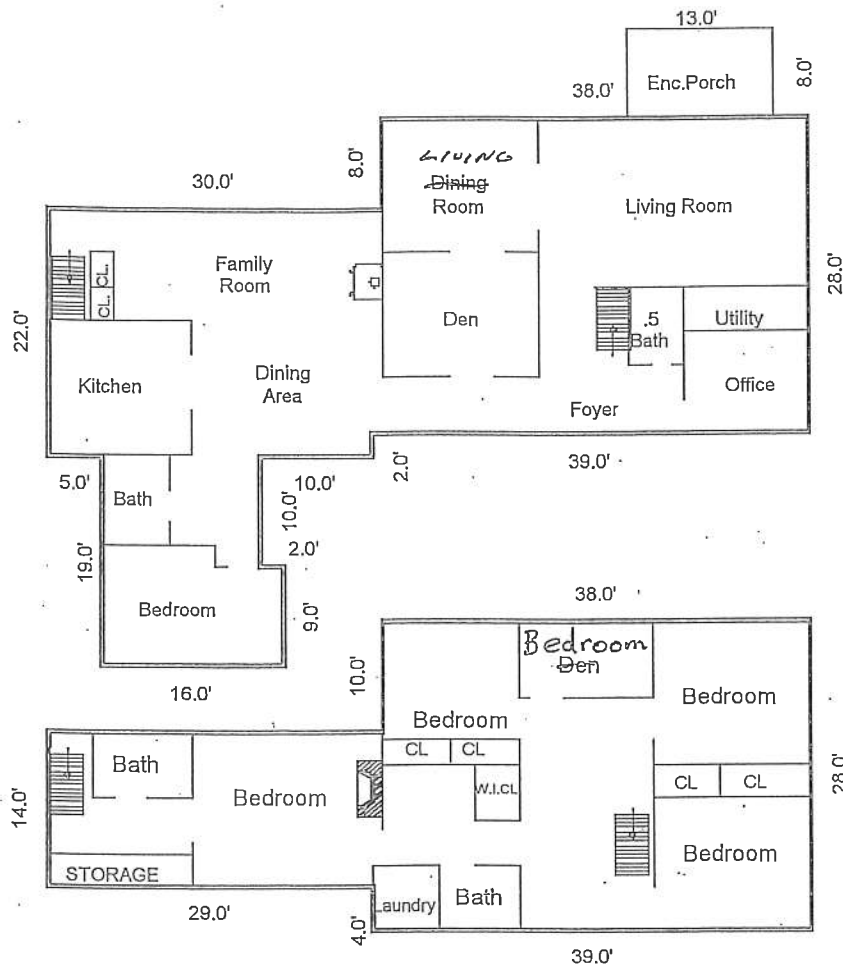

Sketch by Apex IV Windows™

AREA CALCULATIONS SUMMARY			
Code	Description	Size	Totals
GLA1	First Floor	2006.00	2006.00
GLA2	Second Floor	1488.00	1488.00
P/P	Porch	104.00	104.00
TOTAL LIVABLE (rounded)			3494

LIVING AREA BREAKDOWN		
Breakdown	Subtotals	
First Floor		
9.0 x 16.0	144.00	
10.0 x 14.0	140.00	
28.0 x 38.0	1064.00	
20.0 x 30.0	600.00	
2.0 x 29.0	58.00	
Second Floor		
14.0 x 68.0	952.00	
10.0 x 38.0	380.00	
4.0 x 39.0	156.00	
8 Areas Total (rounded)	3494	