


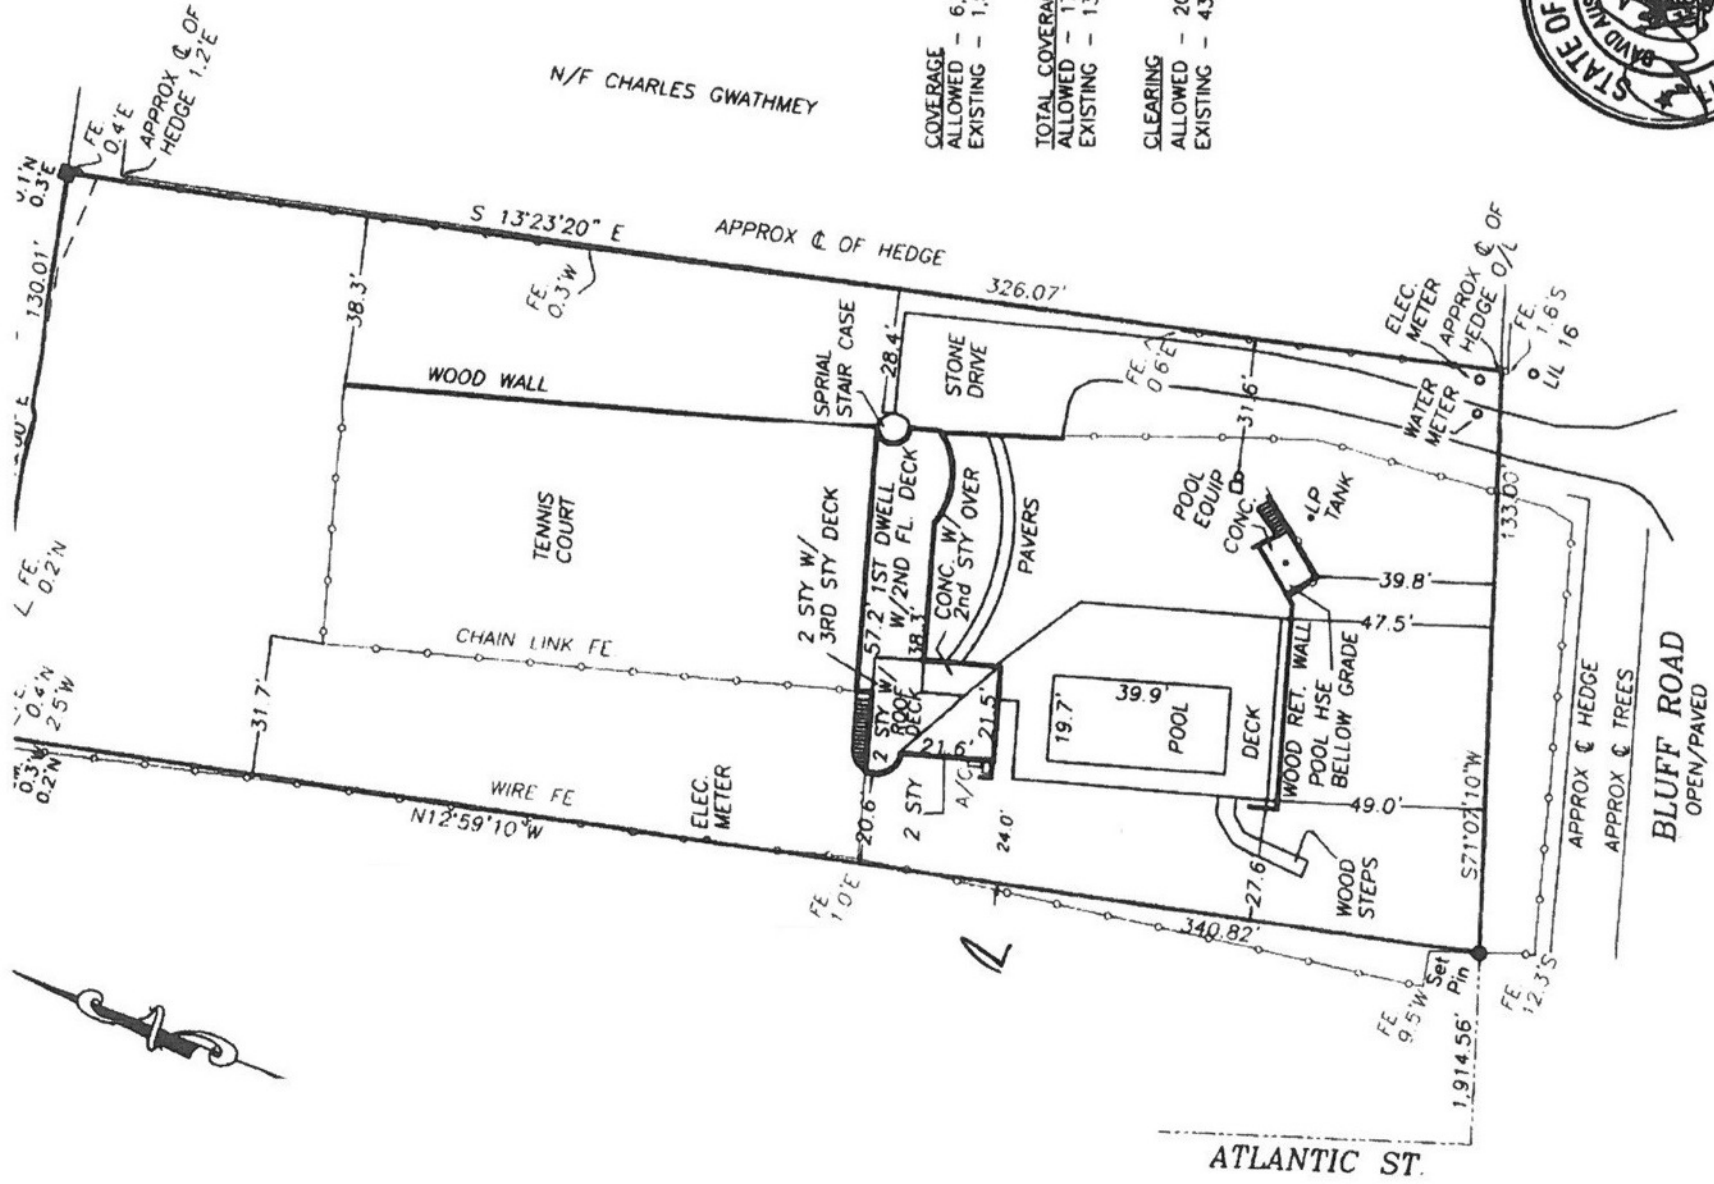

N/F CHARLES GWATHMEY

|                |              |
|----------------|--------------|
| COVERAGE       |              |
| ALLOWED        | - 6,561 SF.  |
| EXISTING       | - 1,550 SF.  |
| TOTAL COVERAGE |              |
| ALLOWED        | - 17,495 SF. |
| EXISTING       | - 13,693 SF. |
| CLEARING       |              |
| ALLOWED        | - 20,935 SF. |
| EXISTING       | - 43,636 SF. |



ATLANTIC ST.

BLUFF ROAD  
OPEN/PAVED