


SECOND FLOOR

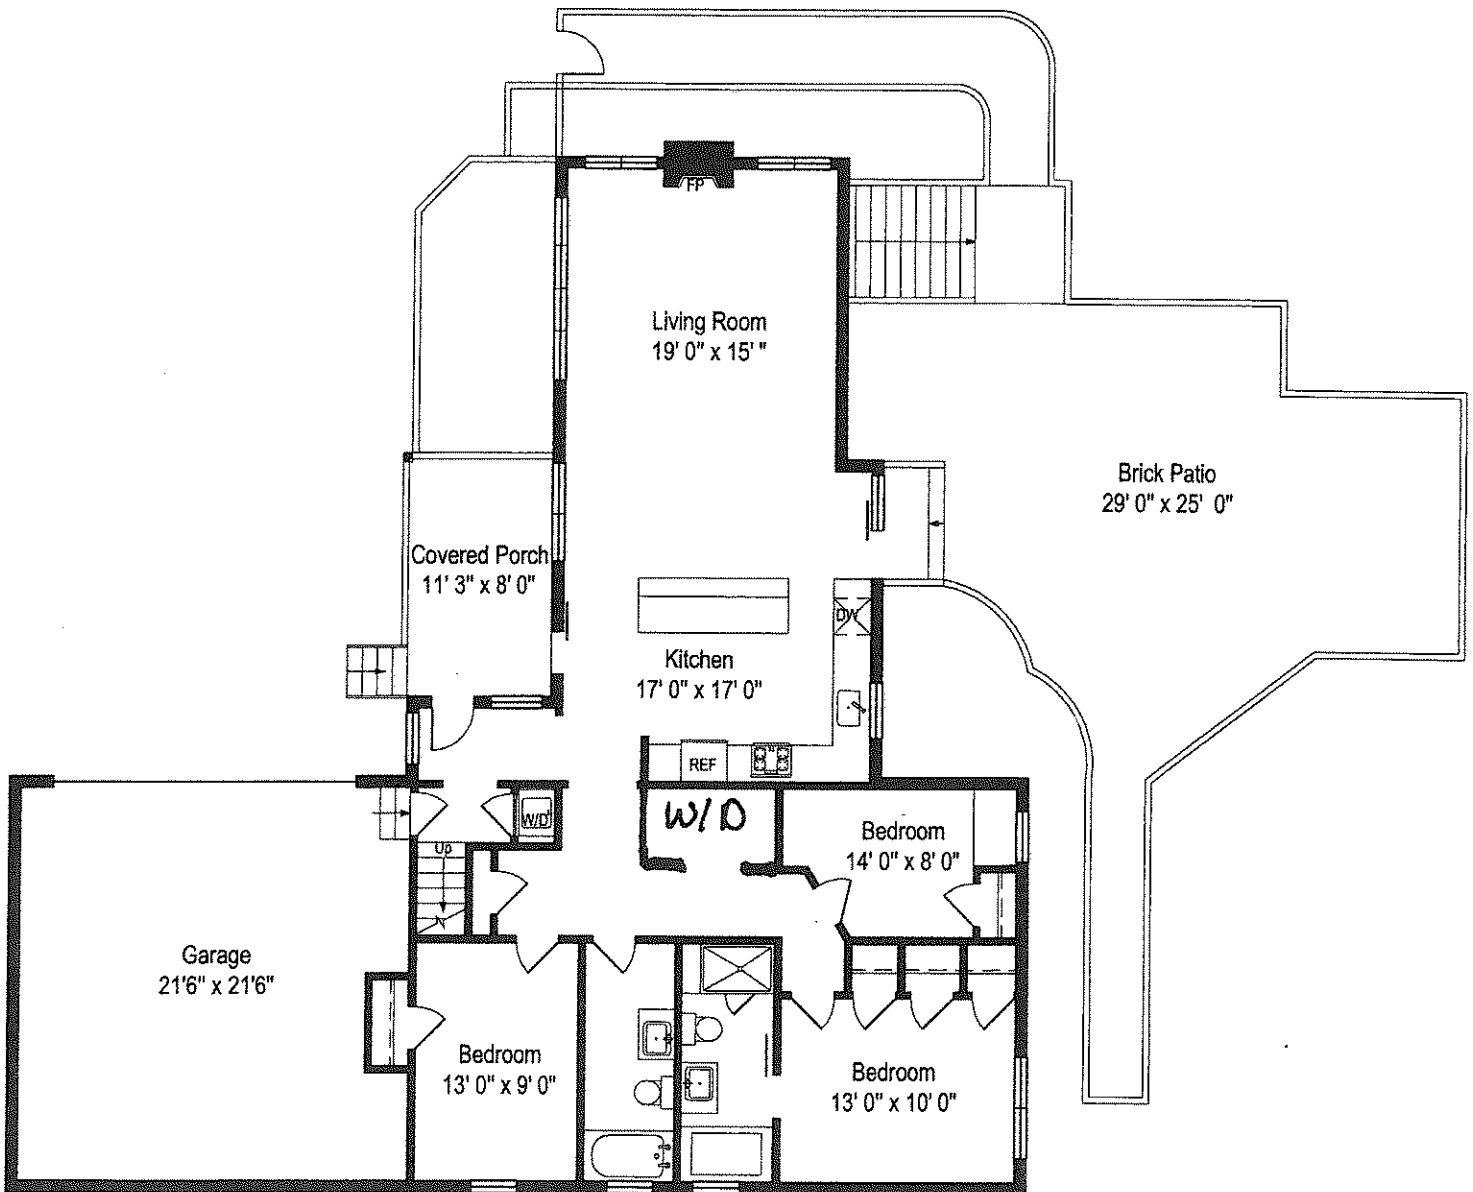

FIRST FLOOR