


WILLIAM SELIGSON

FILED: AUG. 10, 1954 MAP NO. 2244
TOWN OF EAST HAMPTON, SUFFOLK CO., N.Y.
SCALE: 1"=40'
AREA: 49,920 SQ. FT. OR 1.146 ACRES

CERTIFIED TO:
PIERRE PASTEUR

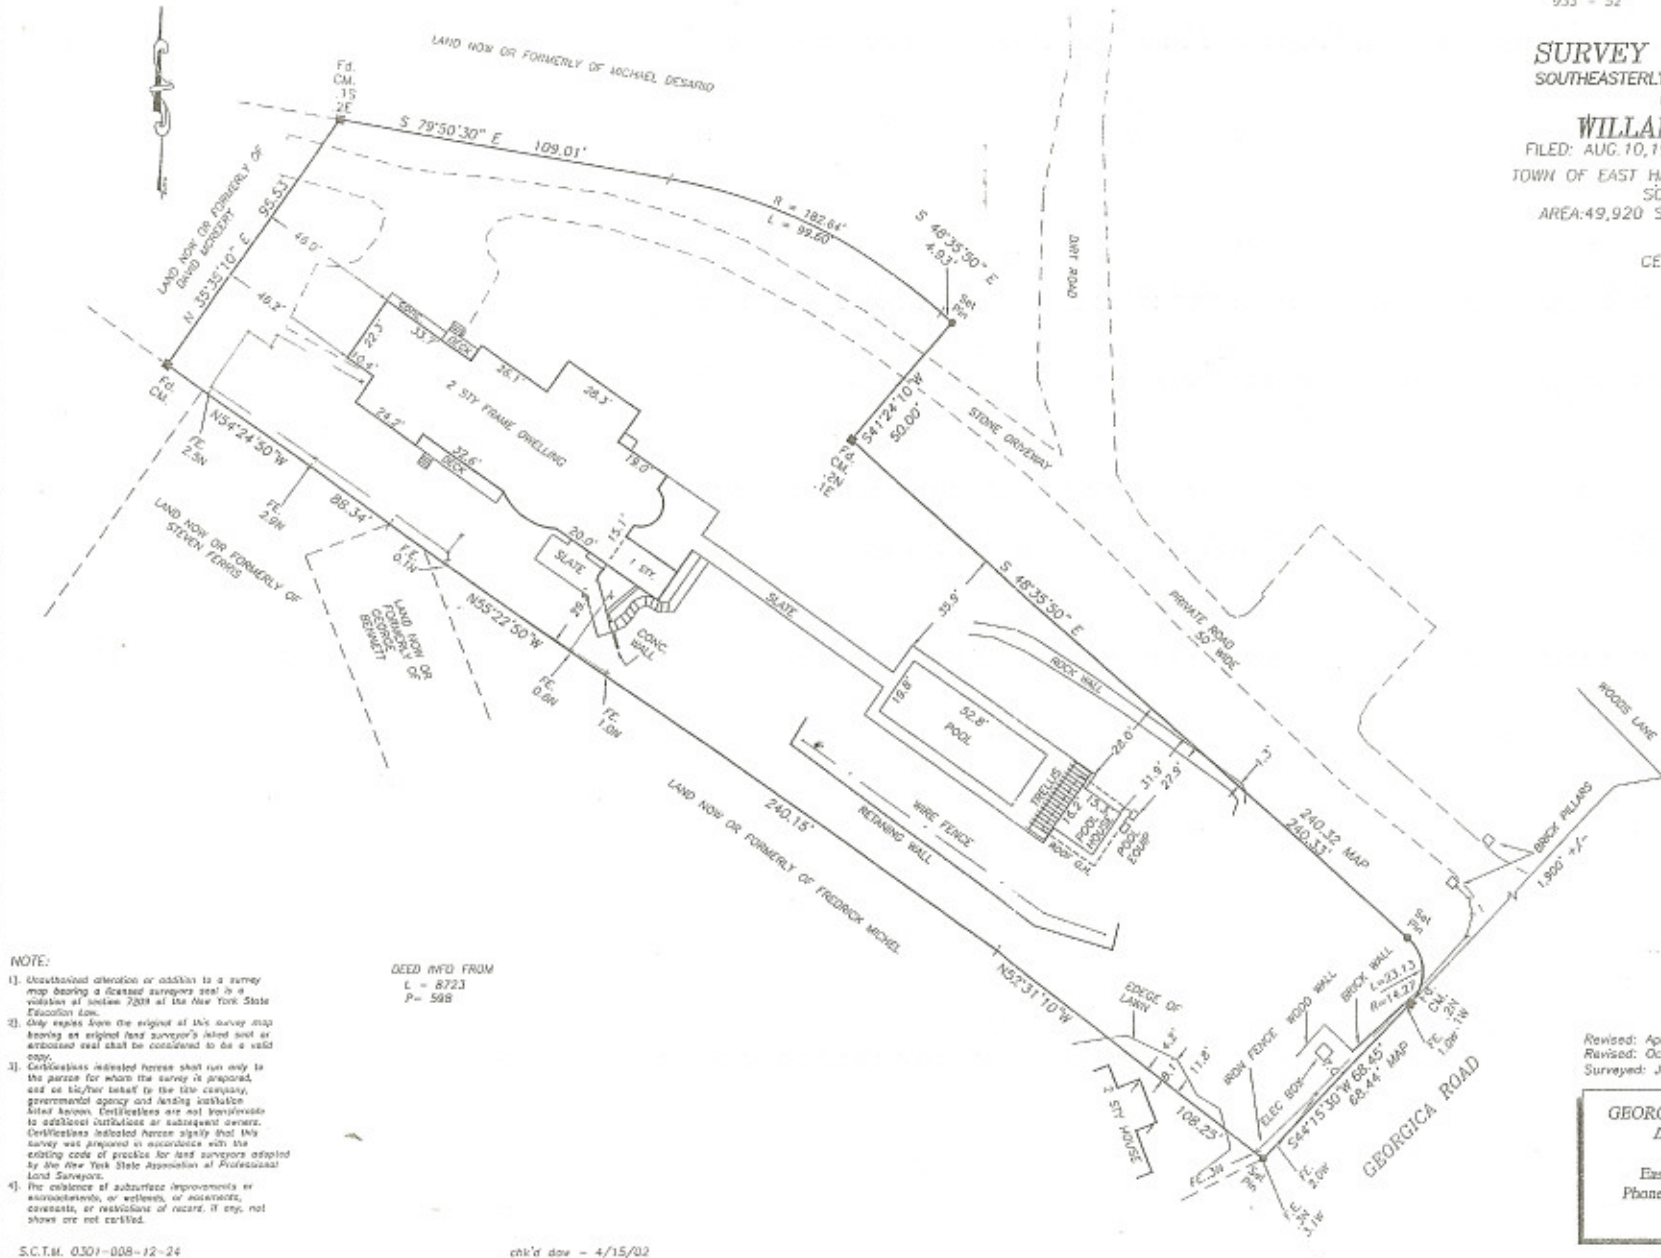

NOTE:



DEED INFO FROM
L = 8723
P = 508

S.C.T.M. 0307-008-12-24

chk'd date = 4/15/02

Revised: April 2, 2002 - Final
Revised: October 16, 2007 - Under Cons., Stk Pool
Surveyed: JULY 25, 2000

GEORGE WALBRIDGE SURVEYORS, P.C.
Land Surveyors & Land Planners
300 Pantigo Place - Suite 116
East Hampton, Long Island, N.Y. 11937
Phone: (631) 324-0412 Fax: (631) 324-9849
E-mail: ehsurveyor@aol.com

c:\land_projects-Greg\Pasteur\diag\survey

DC 7347