


JOB No. 02-06

TAX I.D. No. 1000-21-06-03

© D.GRAF ALL RIGHTS RESERVED

OPEN SPACE
FARMLANDRECEIVED
SUFFOLK COUNTY
2008 NOV 19 PM 3:32
SUFFOLK COUNTY CLERK'S OFFICE
OFFICE OF THE CLERK

N 76°54'10"E 150.00'

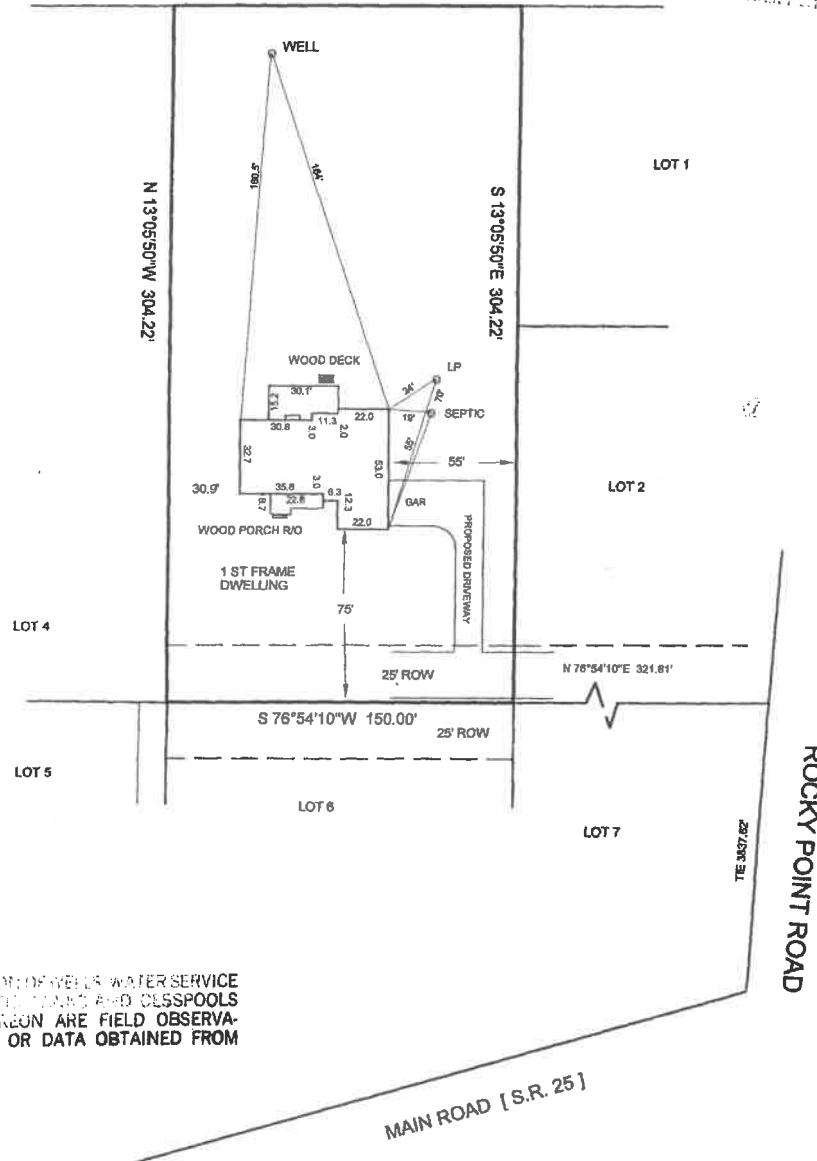

K 10-02-0037

THE LOCATION OF WELLS, WATER SERVICE
LINES, SEPTIC TANKS AND POOLS
SHOWN HEREON ARE FIELD OBSERVA-
TIONS AND OR DATA OBTAINED FROM
OTHERS.

FILE MAP No. 8759 6/7/89

Unauthorized alteration or addition to this document is a violation of Section 7208 of the New York State Education Law.
Certifications indicated hereon shall run only to the person for whom it is prepared and on his behalf to the Title Company, Governmental Agency and Lending Institutions listed hereon, and to the assignees of the Lending Institution or subsequent owners.
Copies of this document not bearing the professional's inked seal or embossed seal shall not be considered a valid true copy.
The objects [or dimensions] shown hereon from structures to the property lines are for a specific purpose and use and therefore are not intended to guide the erection of fences, retaining walls, pools, patios, planting areas, addition to buildings, or any other construction.
The evidence of right of ways and/or easements of record, if any, not shown are not guaranteed.

CERTIFIED ONLY TO:

LAWRENCE TREFCER AND DIANE TREFCER

FIRST AMERICAN TITLE INSURANCE COMPANY
OF NEW YORK

CHASE MORTGAGE CORPORATION

By DESTIN G. GRAF N.Y.S. LIC NO. 50087

SURVEY OF: LOT 3
MAP OF EAST MARION WOODS
EAST MARION, TOWN OF SOUTHOLD
SUFFOLK COUNTY, NEW YORK

SURVEY DATE: 08/27/02

SCALE: 1"=50'

DESTIN G. GRAF
LAND SURVEYORPO BOX 704
Rocky Point, New York, 11778
631-821-3442