


SCALE : 1" = 50'

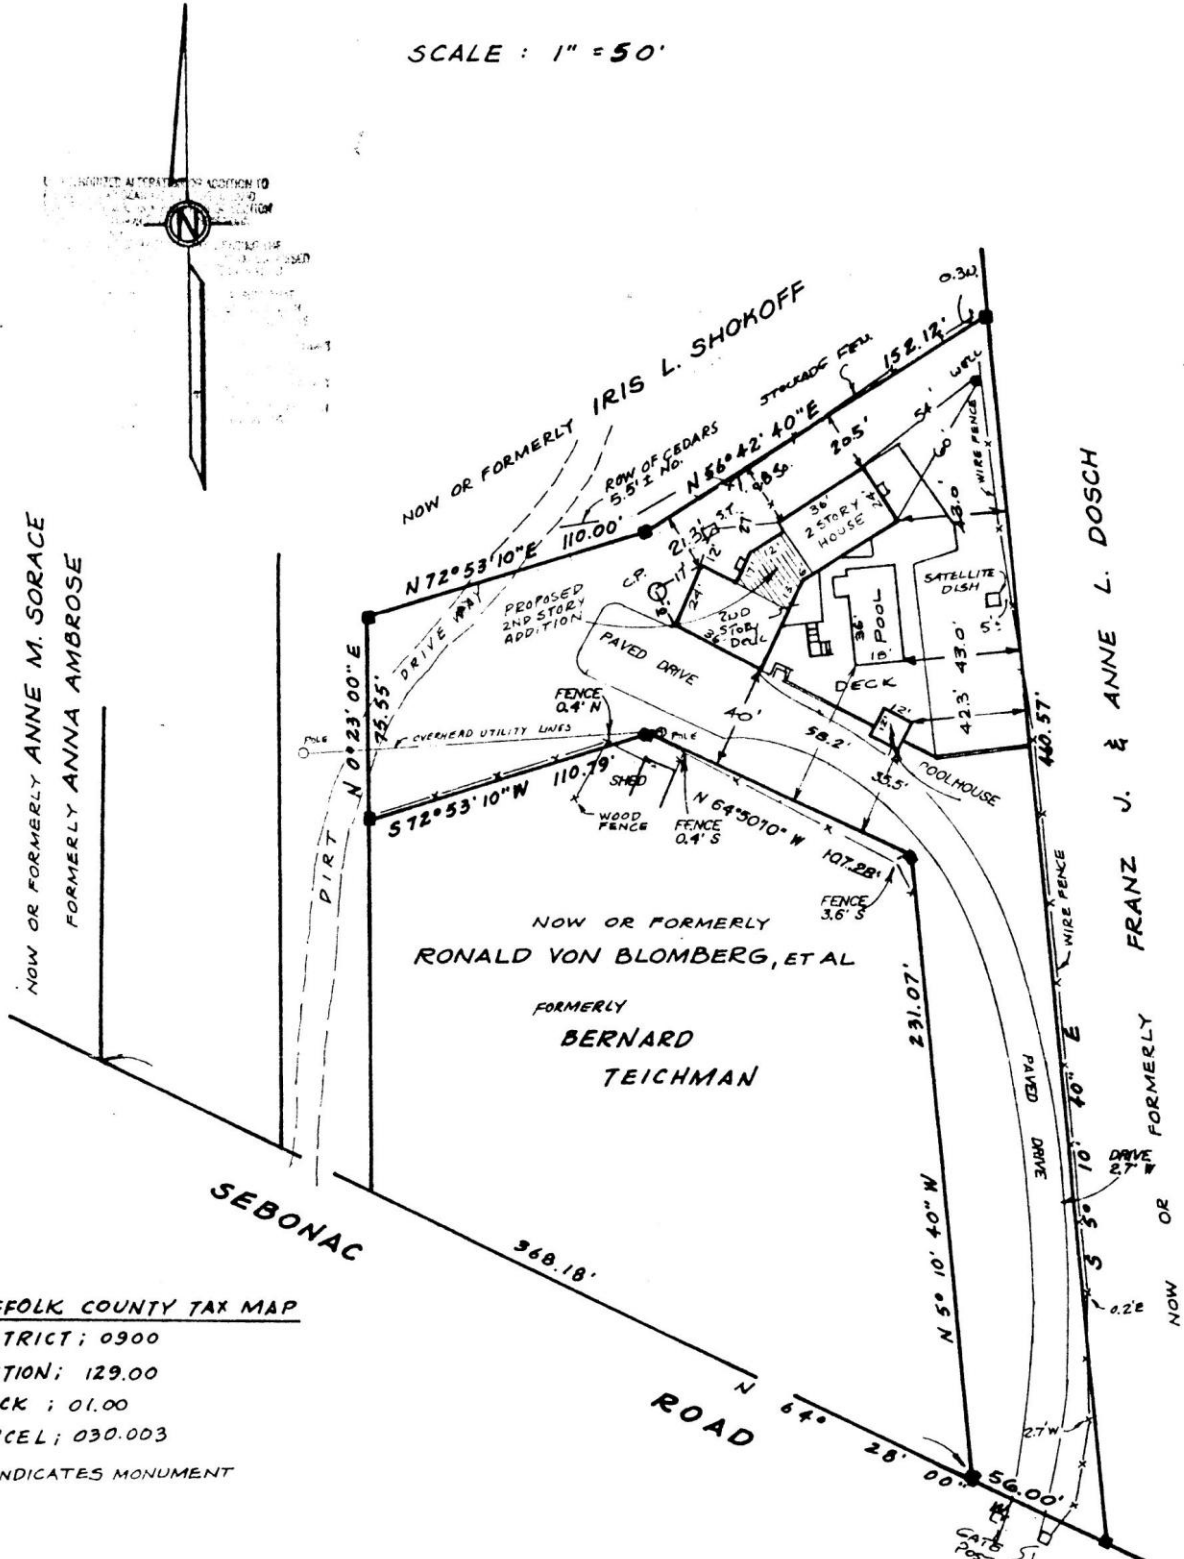

SUFFOLK COUNTY TAX MAP

DISTRICT; 0900

SECTION; 129.00

BLOCK; 01.00

PARCEL; 030.003

■ INDICATES MONUMENT

PLACEMENT OF PROPOSED STRUCTURES SHOWN HEREON MAY BE SUBJECT TO LIMITATIONS, ON-CAUSED BY ENVIRONMENTAL CONDITIONS, ON-SITE, AND OFF-SITE CONDITIONS, EASEMENTS, COVENANTS, AND RESTRICTIONS OF RECORD AND SUBJECT TO VERIFICATION BY GOVERNMENTAL AGENCIES HAVING JURISDICTION.

MAP OF PROPERTY
FOR
Dr. ALEXIS KIRK
SITUATE
TUCKAHOE
TOWN OF SOUTHAMPTON
SUFFOLK COUNTY, N.Y.

SURVEYED: JAN. 13, 1981
REVISED: SEPT. 13, 1982 (BLDG. V.C. POOL)
REVISED: JUNE 24, 1985 (FINAL)
REVISED: MAY 4, 1996 (PAV. DRIVE)
REVISED: DEC. 19, 2000 (UPDATE SURVEY MONUMENTS)
REVISED: JAN. 15, 2001 (PROPOSED WOOD FENCE)



Karl W. Weisenbacher
KARL W. WEISENBACHER, No. 30195
S.H.W. & S., LAND SURVEYORS, P.C.
SQUIRES, HOLDEN, WEISENBACHER & SMITH
LAND SURVEYORS ~ ENGINEERS
SOUTHAMPTON ~ NEW YORK

0.918 ACRE
40,009 SQ. FT.