

HAMPTON (MONTAUK HIGHWAY) ROAD

501

4/103
Robert

Approx Lot Size = 22.5

124 f. m. 2

30 47. 10458

307

11
2039
X 20


Acc Budget = 10 f4. set back
520 MAX

475.69 TO PRESENT SOUTH LINE HAMPTON ROAD
485.69 TO SOUTH LINE MONTAUK HIGHWAY
BY FILED MAP

ADVO

SNIV 7d

571117

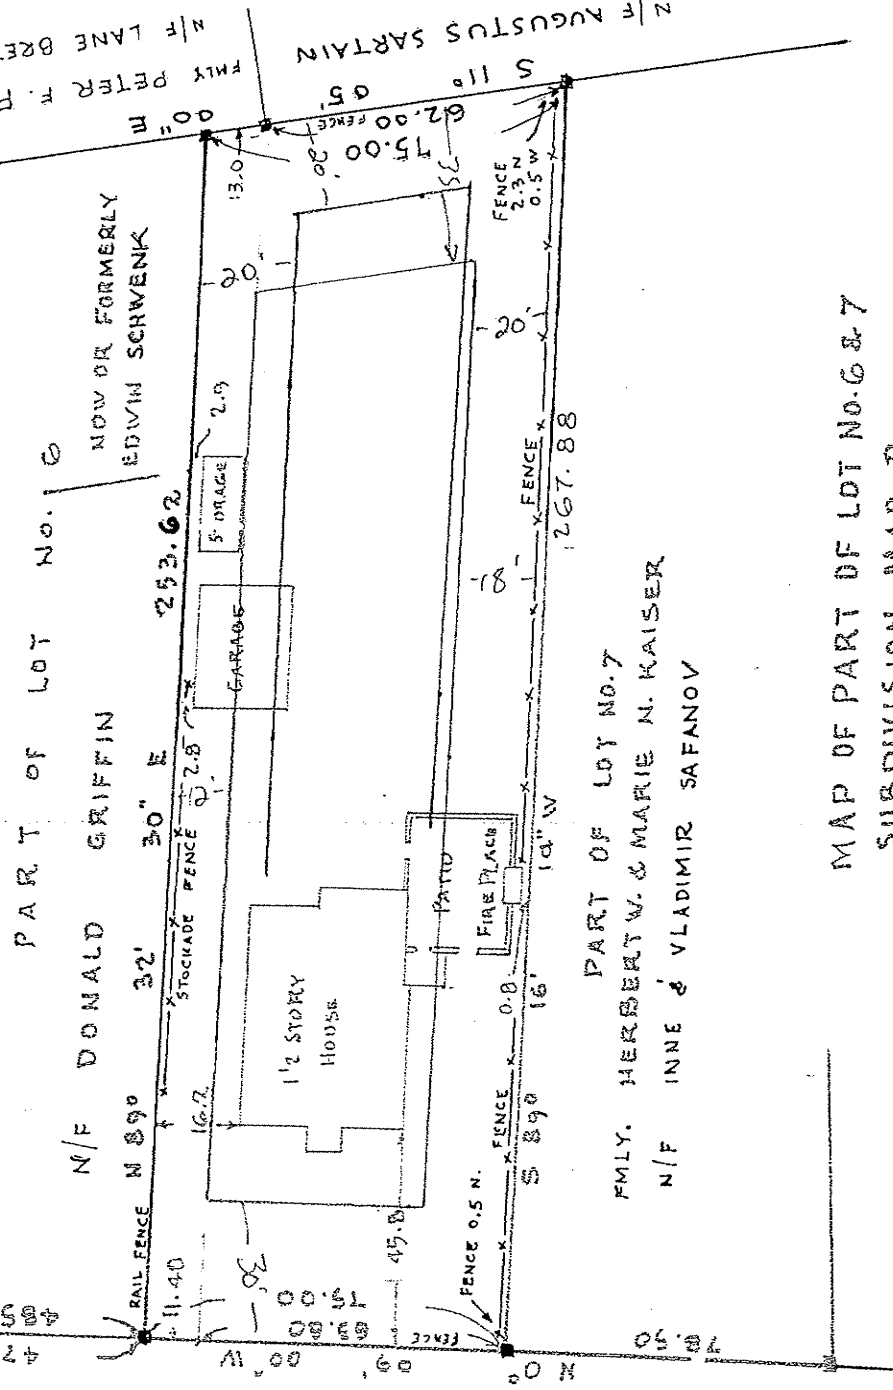

MAP OF PART OF LOT NO. 6 & 7
SUBDIVISION MAP B.
OF PROPERTY OWNED BY
HARRIET J. SAYRE ESTATE
MAP 698 FILED: JULY 30. 1927

SUFFOLK CO. TAX MAP

DISTRICT :	0904
SECTION :	007.00
BLOCK :	04.00
PARCEL :	007.000

CERTIFIED TO:
BANK OF THE HAMPTONS
CHICAGO TITLE INSURANCE COMPANY
IN ACCORDANCE WITH THE MINIMUM STANDARDS
FOR TITLE SURVEYS OF THE N.Y. STATE ASSOC-
OF PROFESSIONAL LAND SURVEYORS

SURVEYED OCT. 13, 1967; REDATED NOV. 25, 1986

Robert P. Smith

ROBERT A. SMITH, N.Y.S. LIC. L.S. NO. 49239
SQUIRES, HOLDEN, WEISENBACHER & SMITH
SURVEYORS - ENGINEERS
SOUTHAMPTON, N.Y.

INC. VILLAGE OF SOUTHAMPTON
TOWN OF SOUTHAMPTON
SUFFOLK COUNTY, N.Y.

SCALE: 1" = 40'
DENOTES MON.

BOOK NO. 268 508
PAGE NO. 13 53.54
CHECKED *J. O. M.*