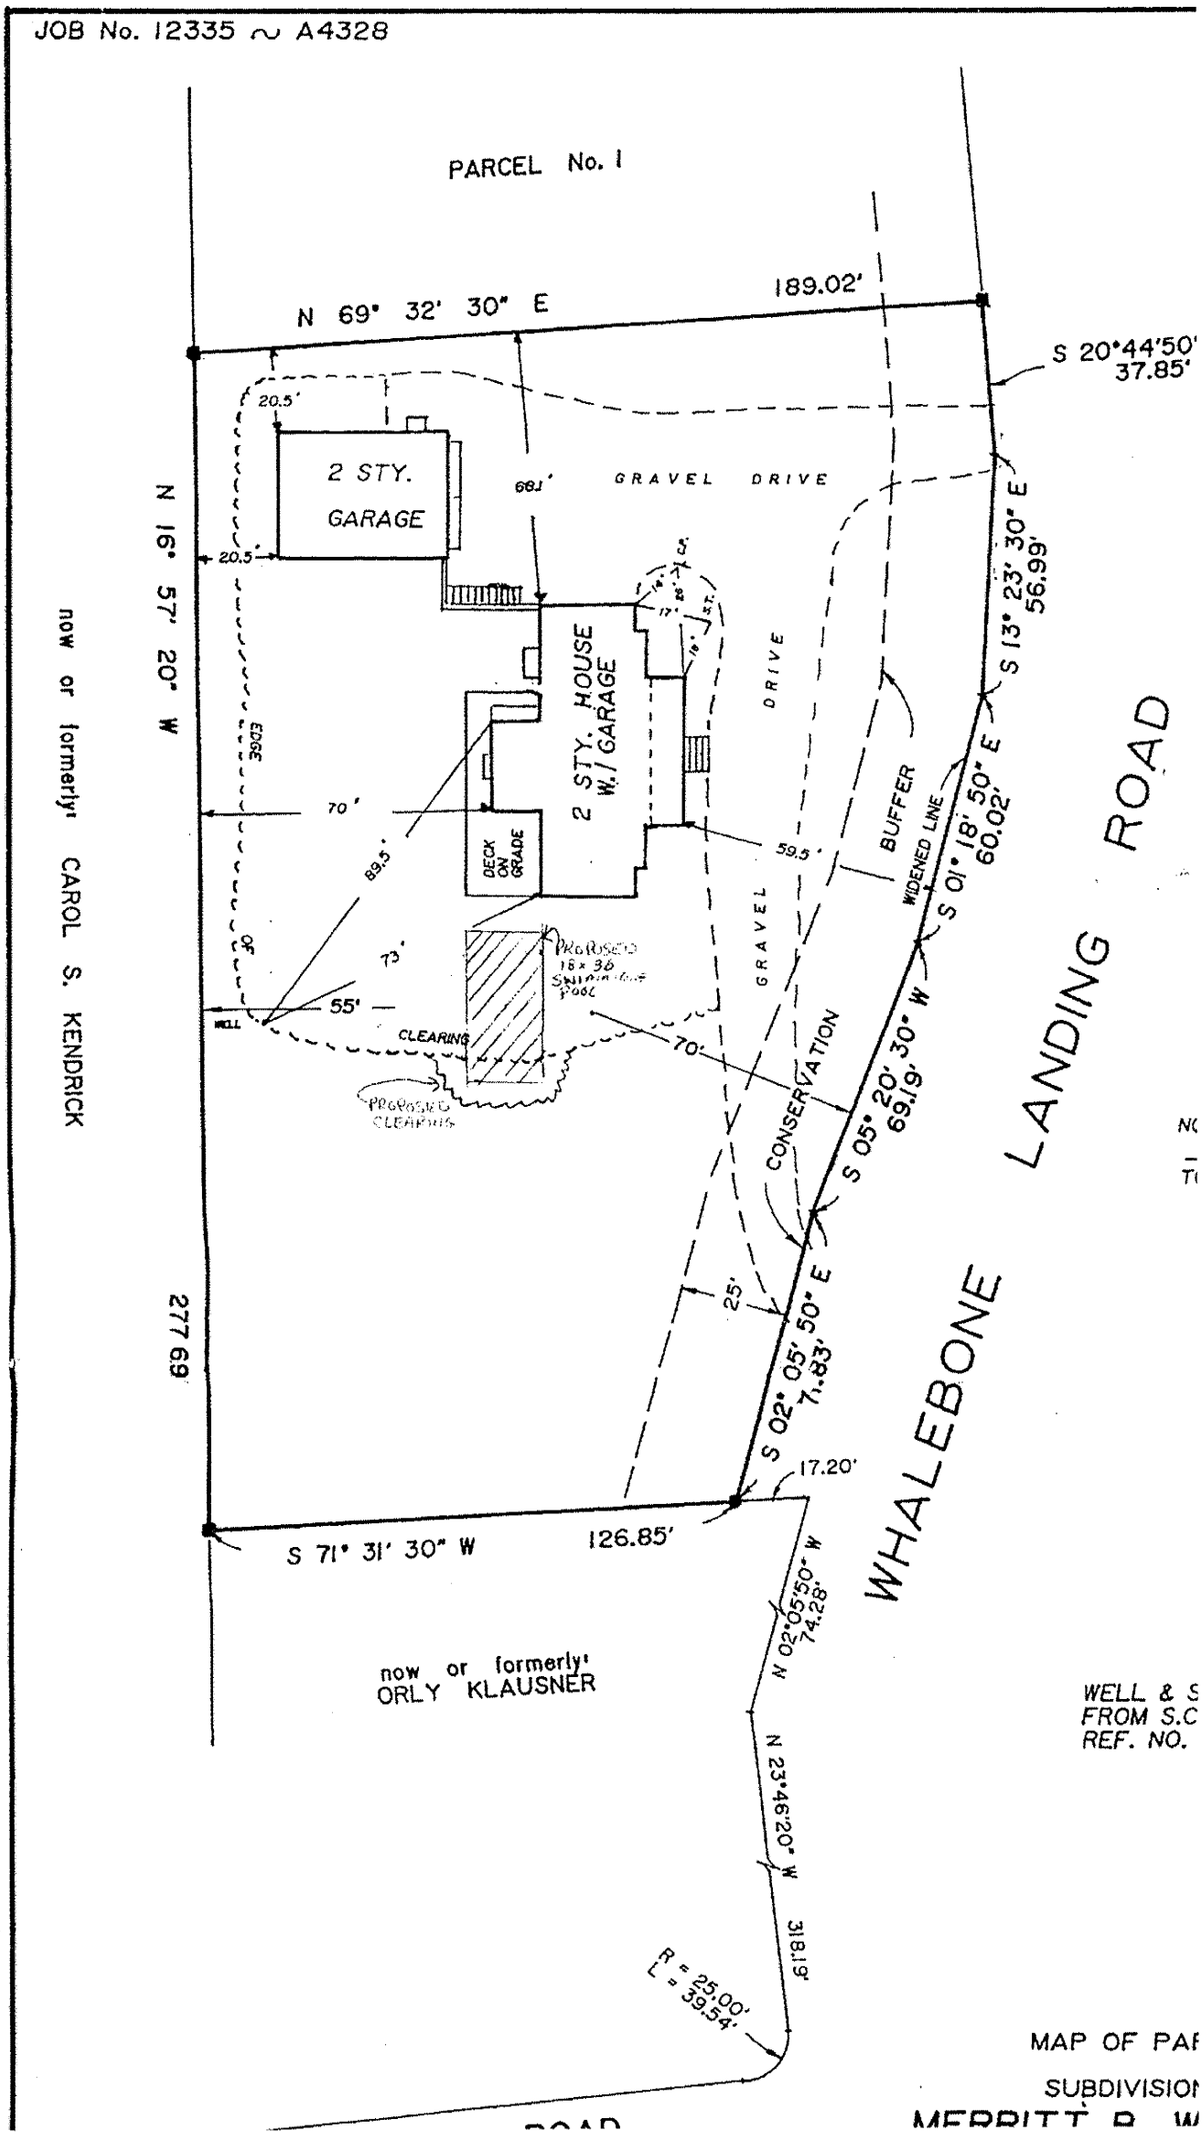
JOB No. 12335 ~ A4328
PARCEL No. 1
N 69° 32' 30" E
189.02'
S 20°44'50"
37.85'
2 STY. GARAGE
20.5'
20.5'
68.1'
GRAVEL DRIVE
N 16° 57' 20" W
now or formerly CAROL S. KENDRICK
2 STY. HOUSE W./ GARAGE
DECK ON GRADE
70'
89.5'
73'
55'
CLEARING
PROPOSED 18x36 SWIMMING POOL
PROPOSED CLEARING
59.5'
GRAVEL DRIVE
BUFFER
WIDENED LINE
S 13° 23' 30" E
56.99'
S 01° 18' 50" E
60.02'
S 05° 20' 30" W
69.19'
CONSERVATION
70'
25'
S 02° 05' 50" E
71.83'
17.20'
WHALEBONE LANDING ROAD
277.69
S 71° 31' 30" W
126.85'
N 02°05'50" W
74.28'
N 23°46'20" W
318.19'
R = 25.00'
L = 39.54'
now or formerly ORLY KLAUSNER
WELL & S
FROM S.C
REF. NO.
MAP OF PAR
SUBDIVISION