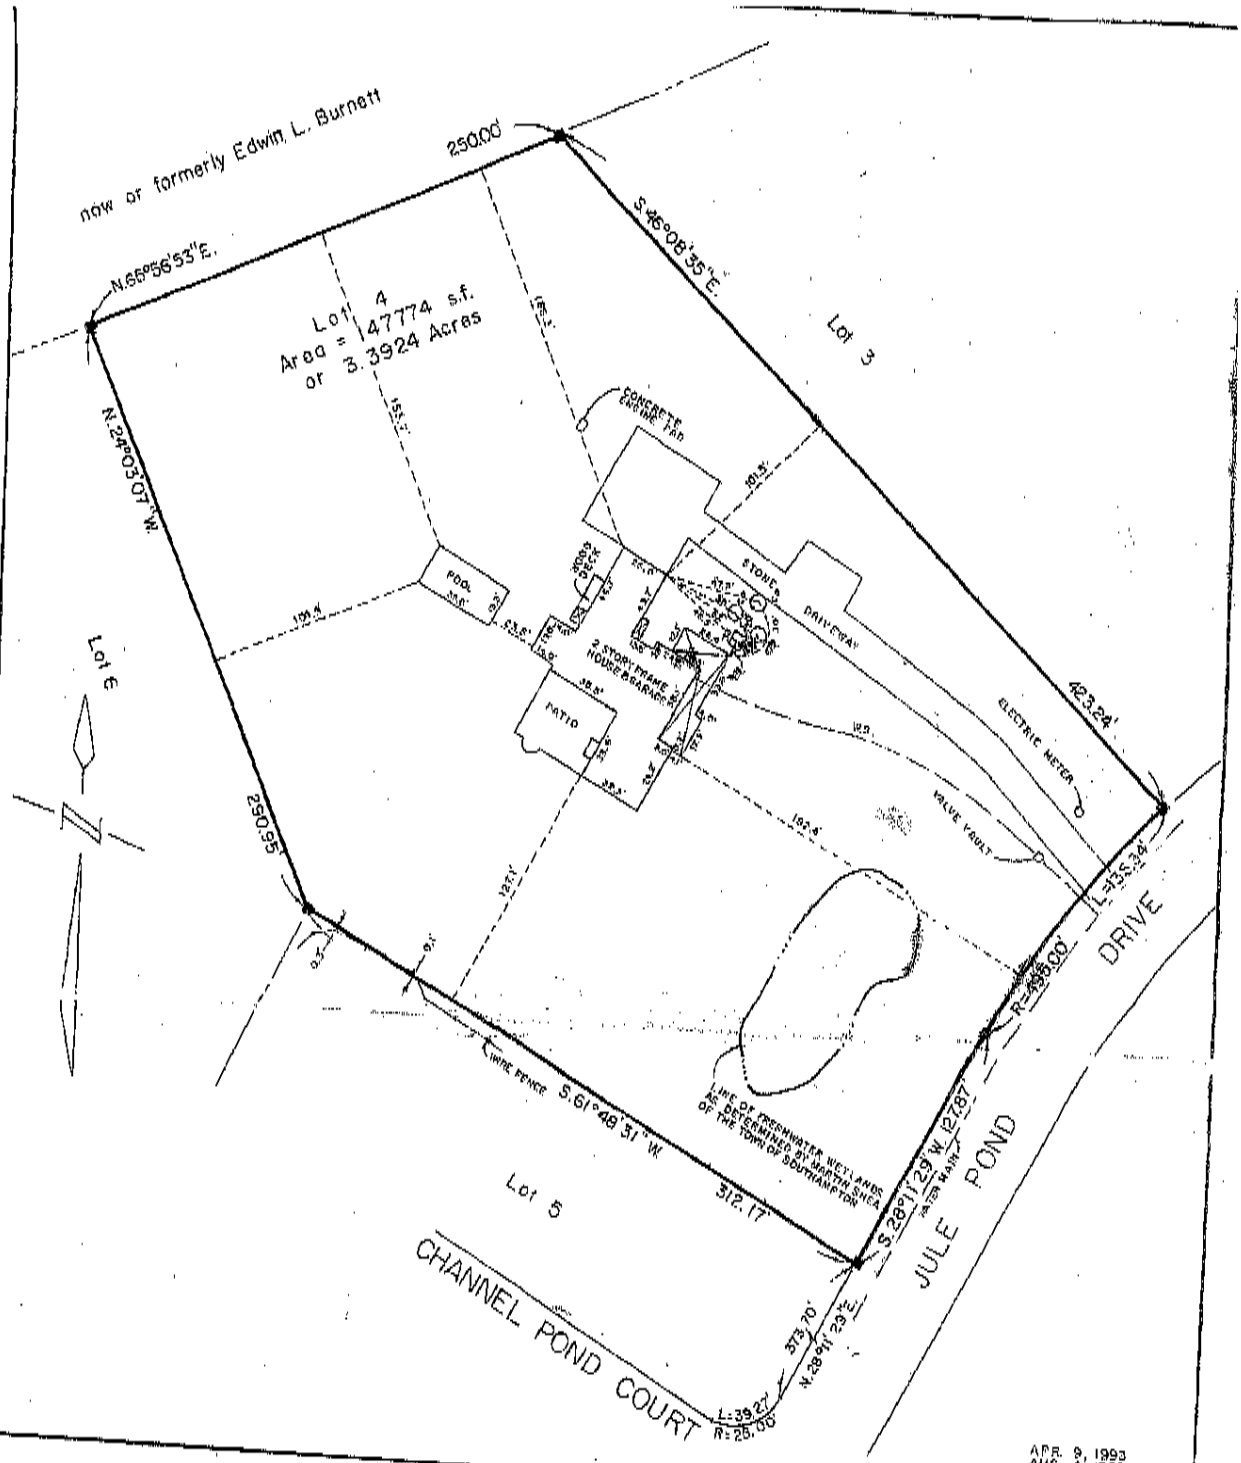

APR. 9, 1993
AUG. 4, 1992
JUL. 28, 1992
JUL. 15, 1992
MAY 19, 1992
DEC. 27, 1991
OCT. 2, 1991
SEPT. 6, 1991
JUL. 10, 1991
APR. 1, 1991
MAY 9, 1990

SURVEY FOR
CHARLES A. NOONAN & OLIVIA R. NOONAN
LOT NO. 4 "FORDUNE"
AT FLYING POINT
TOWN OF SOUTHAMPTON
SUFFOLK COUNTY, NEW YORK

DATE:
SCALE: 1" = 60'
NO. 90-0315

* UNAUTHORIZED ALTERATION OR ADDITION TO THIS SURVEY IS A VIOLATION OF SECTION 7209 OF THE NEW YORK STATE EDUCATION LAW
* COPIES OF THIS SURVEY NOT BEARING THE LAND SURVEYOR'S INKED SEAL OR EMBOSSED SEAL SHALL NOT BE CONSIDERED TO BE A VALID TRUE COPY
* GUARANTEES INDICATED HEREON SHALL RUN ONLY TO THE PERSON FOR WHOM THE SURVEY IS PREPARED AND OR HIS BEHALF TO THE TITLE COMPANY, GOVERNMENTAL AGENCY AND LENDING INSTITUTION LISTED HEREON, AND TO THE ASSIGNEES OF THE LENDING INSTITUTION. GUARANTEES ARE NOT TRANSFERABLE TO ADDITIONAL INSTITUTIONS OR SUBSEQUENT OWNERS
* DISTANCES SHOWN HEREON FROM PROPERTY LINES TO EXISTING STRUCTURES ARE FOR A SPECIFIC PURPOSE AND ARE NOT TO BE USED TO ESTABLISH PROPERTY LINES OR FOR THE ERECTION OF FENCES

GUARANTEED TO:
CHARLES A. NOONAN &
OLIVIA R. NOONAN
TICOR TI[illegible] GUARANTEE COMPANY
(T-12[illegible])

STATE OF NEW YORK
HOWARD W. YOUNG
45893
LICENSED LAND SURVEYOR

HEALTH DEPARTMENT - DATA FOR APPROVAL TO CONSTRUCT
* NEAREST WATER MAIN ___ MI. ± * SOURCE OF WATER: PRIVATE ___ PUBLIC ___
* RUFF CO. TAX MAP DIST. 0900 SECTION 170 BLOCK 01 LOT 016.001
* THERE ARE NO DWELLINGS WITHIN 100 FEET OF THIS PROPERTY OTHER THAN THOSE SHOWN HEREON.
* THE WATER SUPPLY AND SEWAGE DISPOSAL SYSTEM FOR THIS RESIDENCE WILL CONFORM TO THE STANDARDS OF THE SUFFOLK COUNTY DEPARTMENT OF HEALTH SERVICES.
APPLICANT:
ADDRESS
TEL.

NOTE: △ = STAKE ■ = MONUMENT
SUBDIVISION MAP FILED IN THE OFFICE OF THE CLERK OF SUFFOLK COUNTY ON APR. 21, 1981 AS FILE NO. 6975.

* THE LOCATION OF WELL(W), SEPTIC TANK(ST) & CESSPOOL(CP) SHOWN HEREON ARE FROM FIELD OBSERVATIONS AND OR DATA OBTAINED FROM OTHERS

BRANDIS & SONS INC. 1048

YOUNG & YOUNG
ALDEN W. YOUNG, PROFESSIONAL ENGINEER AND LAND SURVEYOR N.Y.S. LICENSE NO. 12845
HOWARD W. YOUNG, LAND SURVEYOR N.Y.S. LICENSE NO. 45893
400 OSTRANDER AVENUE
RIVERHEAD, NEW YORK