

91.989 sq. ft.
es
ACCESS EASEMENT): 84.004 sq. ft.
es

tle Insurance
k, Inc.
a national banking association.
/or assigns

IC SYSTEM



C	D
22'	19.5'
35.5'	34'

ble monument.
crete monument.
n pin.
ole.
er.
er.
cover.

a survey map bearing a licensed land
on 7209, sub-division 2 of the N.Y.
survey marked with an original of the
d seal shall be considered to be valid

that this survey was prepared in
Practice for Land Surveys adopted by the
Land Surveyors. Said certifications
in the survey is prepared, and on his behalf
agency and Lending institution listed hereon.
Institution. Certifications are not trans-
subsequent owners.

ments, if any, are not shown hereon.

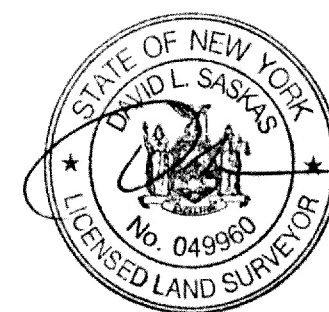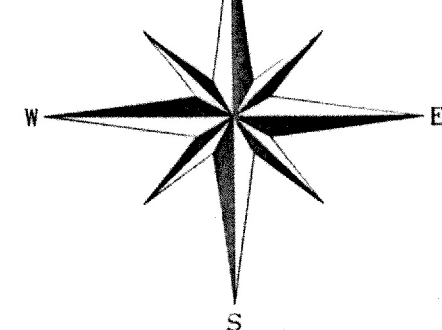

June 5, 2012: Update (porch)
April 5, 2012: Final
November 29, 2011: Revise proposed sanitary
November 12, 2011: Stake addition
November 2, 2011: Gross floor area & cover
October 5, 2011: Proposed addition, Health
October 3, 2011: Proposed exercise studio
June 27, 2011: Proposed additions, garage,
June 24, 2011: Test Hole
June 21, 2011: Plot proposed
June 18, 2011: Stake Pool Envelope
May 24, 2011: Update & recertify
July 21, 2009: Update & recertify

Surveyed: June 16, 2011
David L. Saskas
N.Y.S. Lic. No. 049960