


OF PROPERTY  
 RTY LOCATED AT WAINSCOTT  
 No. 92 & 93  
 OF WEST WOOD; SECTION 2  
 ED: JANUARY 9, 1963; FILE No. 3704  
 OWN OF EAST HAMPTON  
 SUFFOLK COUNTY, NEW YORK  
 S.C.T.M. # 300-197-03-44  
 AREA = 39,463 SF. = 0.9060 ACRES  
 SCALE: 1"=40'

NOTE: THE EXISTENCE OF RIGHT OF WAYS,  
 WETLANDS AND/OR EASEMENTS OF RECORD  
 IF ANY NOT SHOWN ARE NOT GUARANTEED.

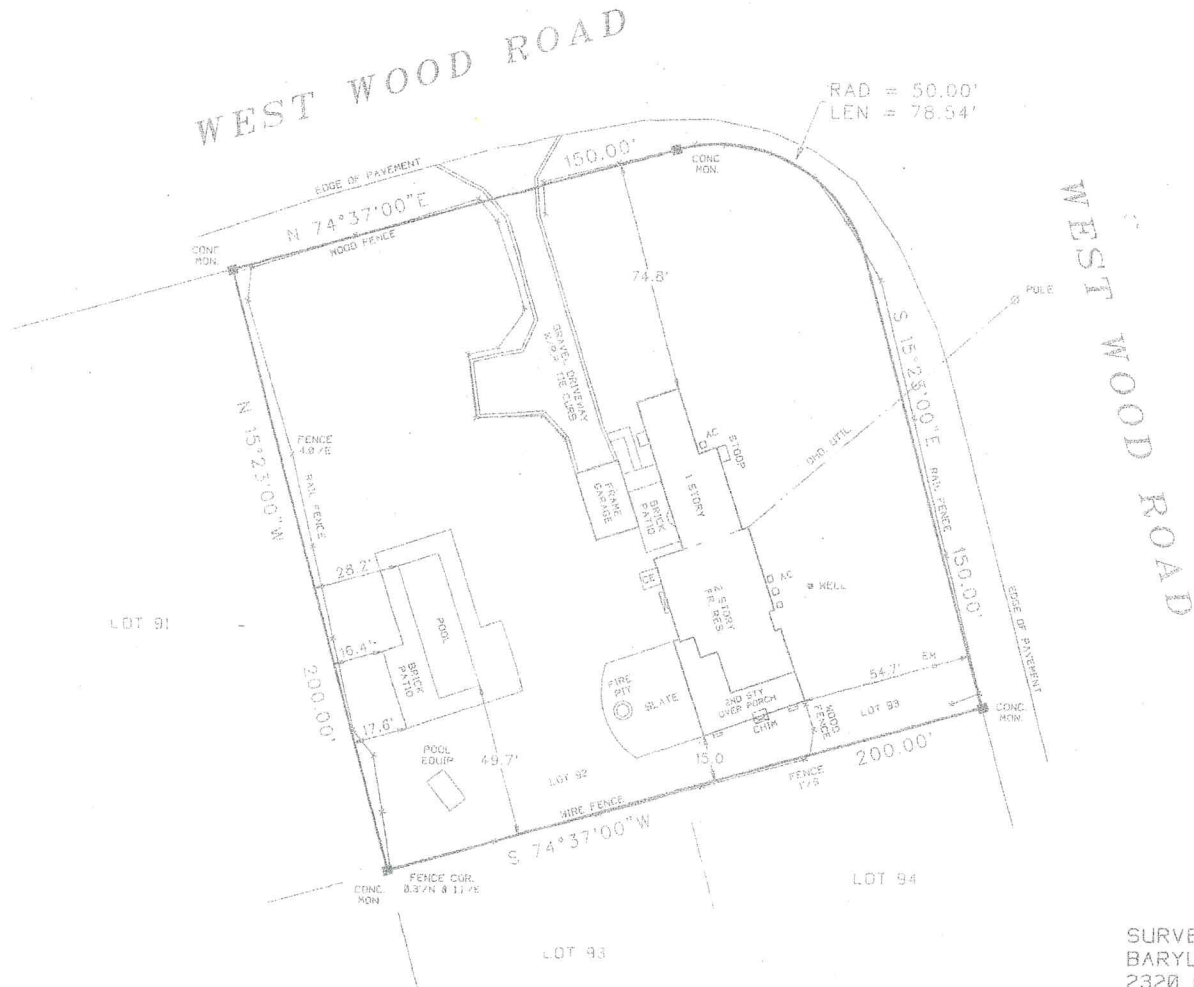

UNAUTHORIZED ALTERATION OR ADDITION TO THIS SURVEY IS A VIOLATION  
 OF SECTION 2000 OF THE NEW YORK STATE EDUCATION LAW

COPIES OF THIS SURVEY MAY NOT BEARING THE LAND SURVEYORS INKED  
 OR PHOTOGRAPHICALLY SHALL NOT BE CONSIDERED TO BE A VALID TRUE COPY.

GUARANTEES OR CERTIFICATIONS INDICATED HEREON SHALL RUN ONLY TO  
 THE PERSON FOR WHOM THE SURVEY IS PREPARED AND ON HIS BEHALF TO  
 THE TITLE COMPANY, GOVERNMENTAL AGENCY AND LENDING INSTITUTION  
 LISTED HEREON AND TO THE ASSIGNEE OF THE LENDING INSTITUTION.  
 GUARANTEES OR CERTIFICATIONS ARE NOT TRANSFERABLE TO ADDITIONAL  
 INSTITUTIONS OR SUBSEQUENT OWNERS.

CERTIFIED TO:  
 MICHAEL FLOOD  
 SHELLI BREIDENBACH

*John Barylski*

SURVEYED BY:  
 BARYLSKI LAND SURVEYING  
 2320 MAIN ST. P.O. BOX 1302  
 NEWMAN VILLAGE CONDO.  
 BRIDGEHAMPTON, NEW YORK  
 631-537-7944  
 JULY 17, 2000

8-2-2000: CERTIFICATIONS  
 2-24-2010: UPDATE SURVEY

18830 3439 08840 11