


LAND NOW OR FORMERLY OF
RUSSELL WEISS AND WAYNE WEISS

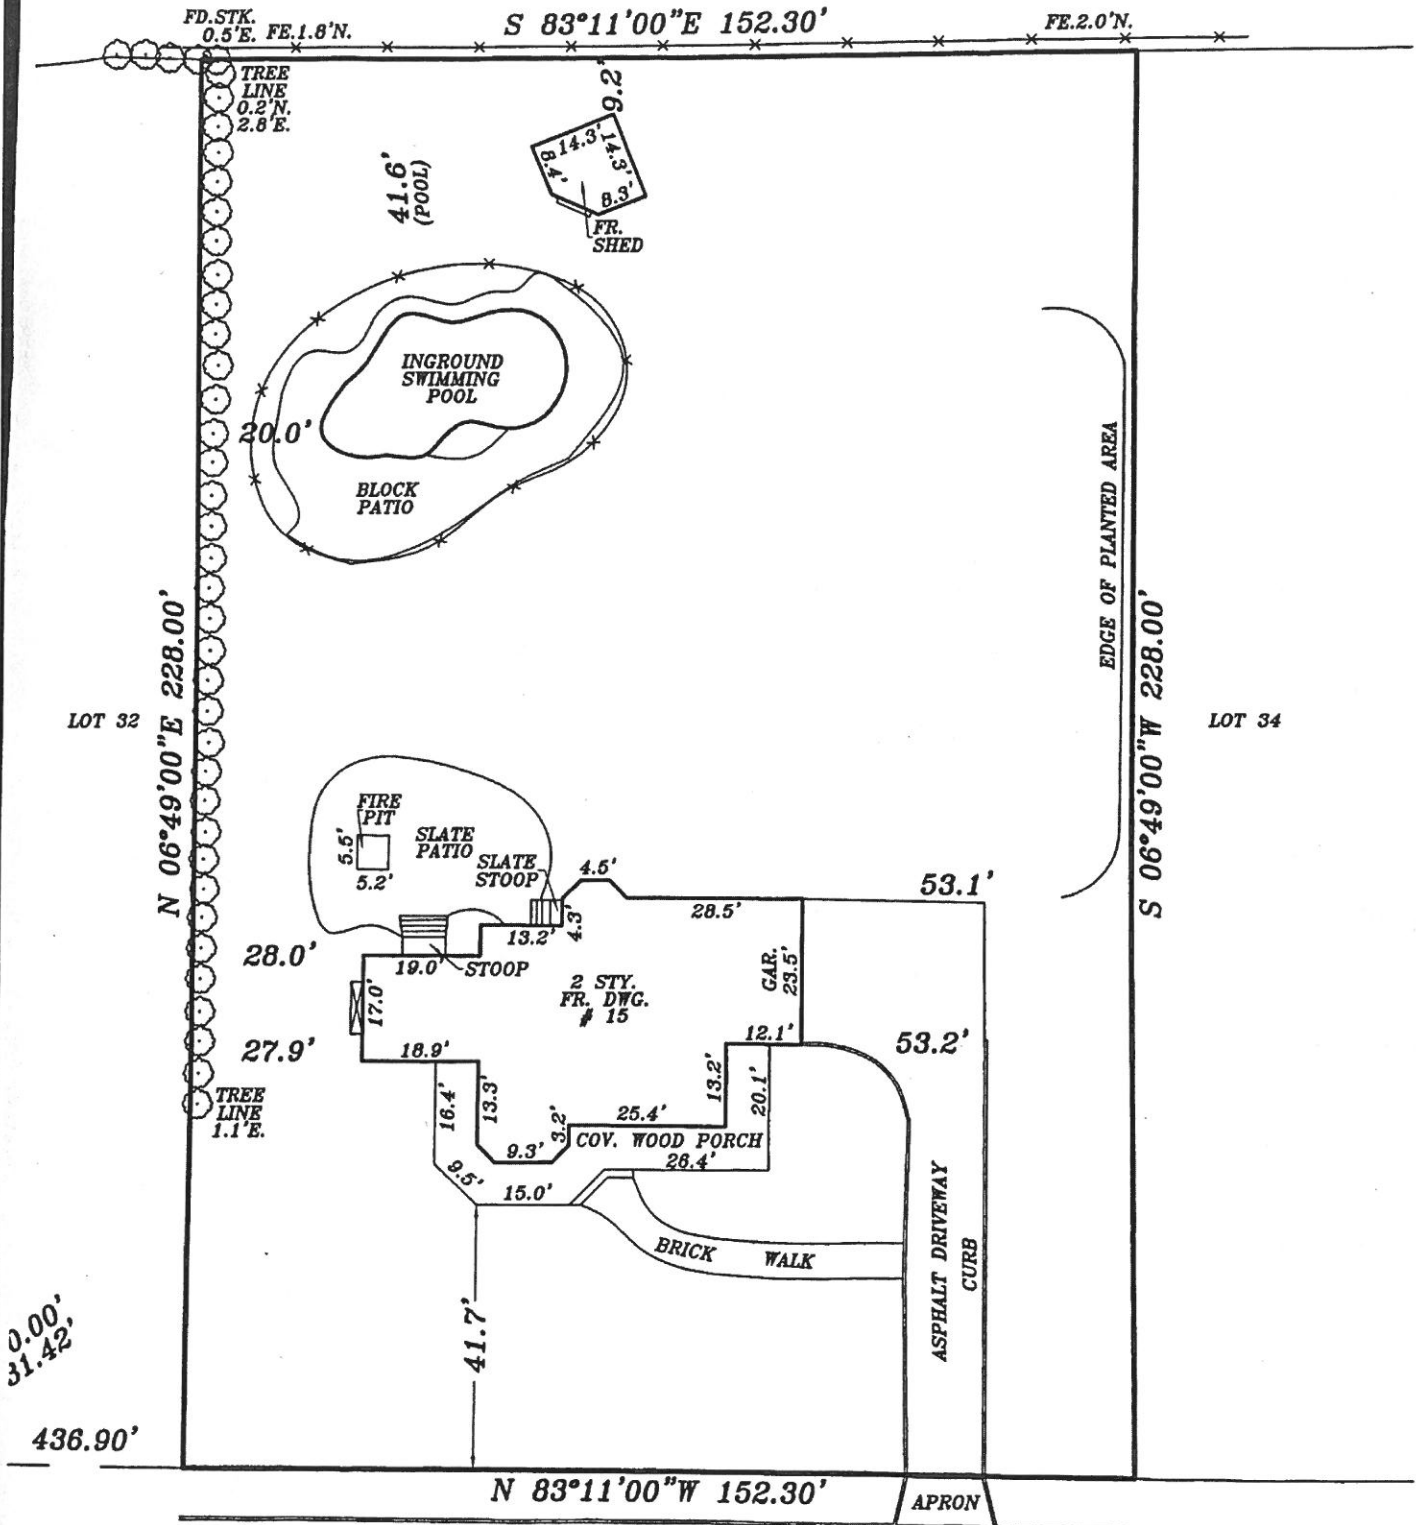

DOGWOOD LANE
(50' WIDE)

RESTRICTIONS (UNDER 1000 DASH LINE)

Δ L.P.