


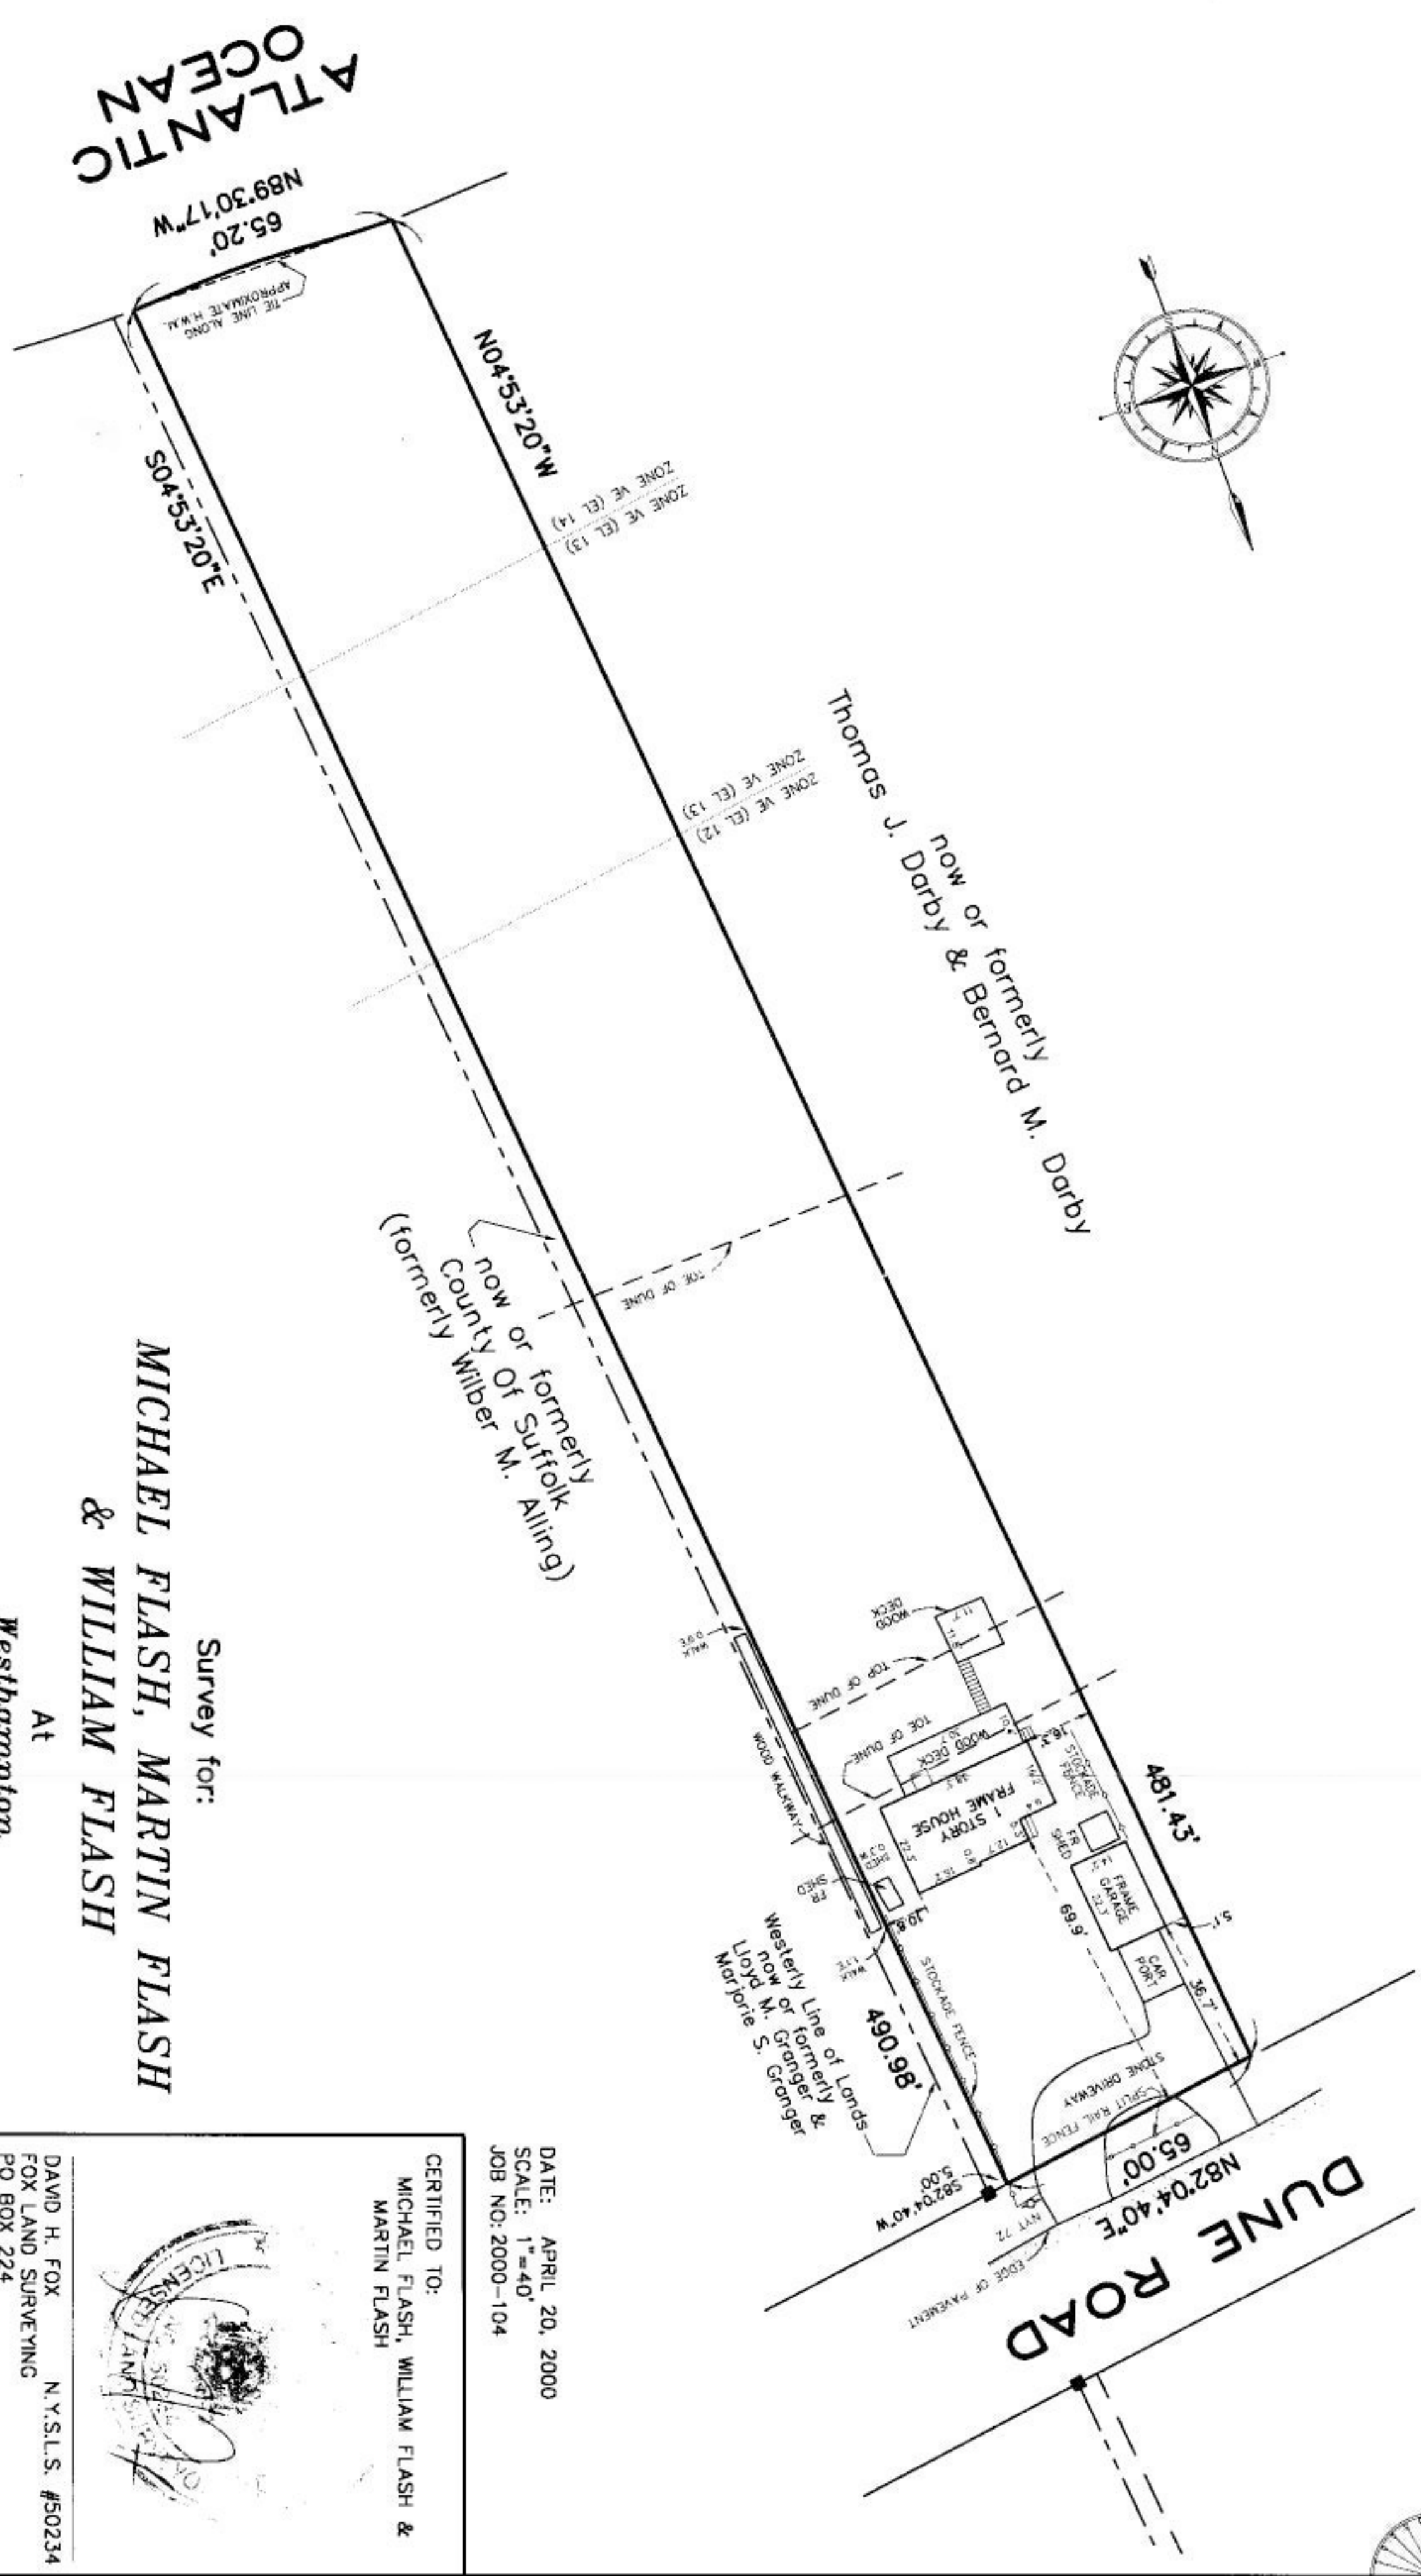

NOTES:

- 1. AREA = 31,559 S.F.
- 2. ■ = MONUMENT FOUND, ▲ = STAKE FOUND.
- 3. REFERENCE DEED L. 11883 CP. 458
- 4. FIRM BOUNDARY LINES SHOWN HEREON ARE FROM FLOOD INSURANCE RATE MAP NO. 36103C0762 & 36103C0764 LAST DATED MAY 04, 1998.

Survey for:
**MICHAEL FLASH, MARTIN FLASH
& WILLIAM FLASH**

At
Westhampton
Town of
Southampton
Suffolk County, New York

S.C.T.M.: 0900-391.00-02.00-035.001

DATE: APRIL 20, 2000
SCALE: 1"=40'
JOB NO: 2000-104

CERTIFIED TO:
MICHAEL FLASH, WILLIAM FLASH &
MARTIN FLASH



DAVID H. FOX N.Y.S.L.S. #50234
FOX LAND SURVEYING
PO BOX 224
SPEONK, N.Y. 11972
(516) 325-2902

UNAUTHORIZED ALTERATION OR ADDITION TO THIS SURVEY IS A VIOLATION OF SECTION 7208 OF THE NEW YORK STATE EDUCATION LAW. COPIES OF THIS SURVEY MAP NOT BEARING THE LAND SURVEYOR'S EMBOSSED SEAL OR EMBOSSED SEAL SHALL NOT BE CONSIDERED TO BE A VALID TRUE COPY.

CERTIFICATION INDICATED HEREON SHALL RUN ONLY TO THE SURVEYOR'S SIGNATURE AND NOT TO THE TITLE COMPANY, CALCULATED TO THE TITLE COMPANY, CALCULATED TO THE TITLE COMPANY, AND LENDING INSTITUTION LISTED HEREON, AND TO THE ASSIGNEES OF THE LENDING INSTITUTION, CERTIFICATIONS ARE NOT TRANSFERABLE TO ADDITIONAL INSTITUTIONS OR SUBSEQUENT OWNERS.