

RECEIVED
DEC - 8 2015



GUARANTEES OR CERTIFICATIONS INDICATED HEREON SHALL RUN ONLY TO THE PERSON FOR WHOM THE SURVEY IS PREPARED AND ON HIS BEHALF TO THE TITLE COMPANY, GOVERNMENTAL AGENCY AND LENDING INSTITUTION LISTED HEREON AND TO THE ASSIGNEES OF THE LENDING INSTITUTION. GUARANTEES OR CERTIFICATIONS ARE NOT TRANSFERABLE TO ADDITIONAL INSTITUTIONS OR SUBSEQUENT OWNERS.

TOTAL ALLOWABLE CLEARING = 14,963 SF = 45%
TOTAL EXISTING CLEARING = 21,500 SF = 64.7%

EXIST LOT COVERAGE =
3620 SF = 10.9%
RES /PORCH = 2450 SF
POOL 623 SF
GARAGE = 547 SF

PROP LOT COVERAGE
4220 SF = 12.7%
INCL TERRACE

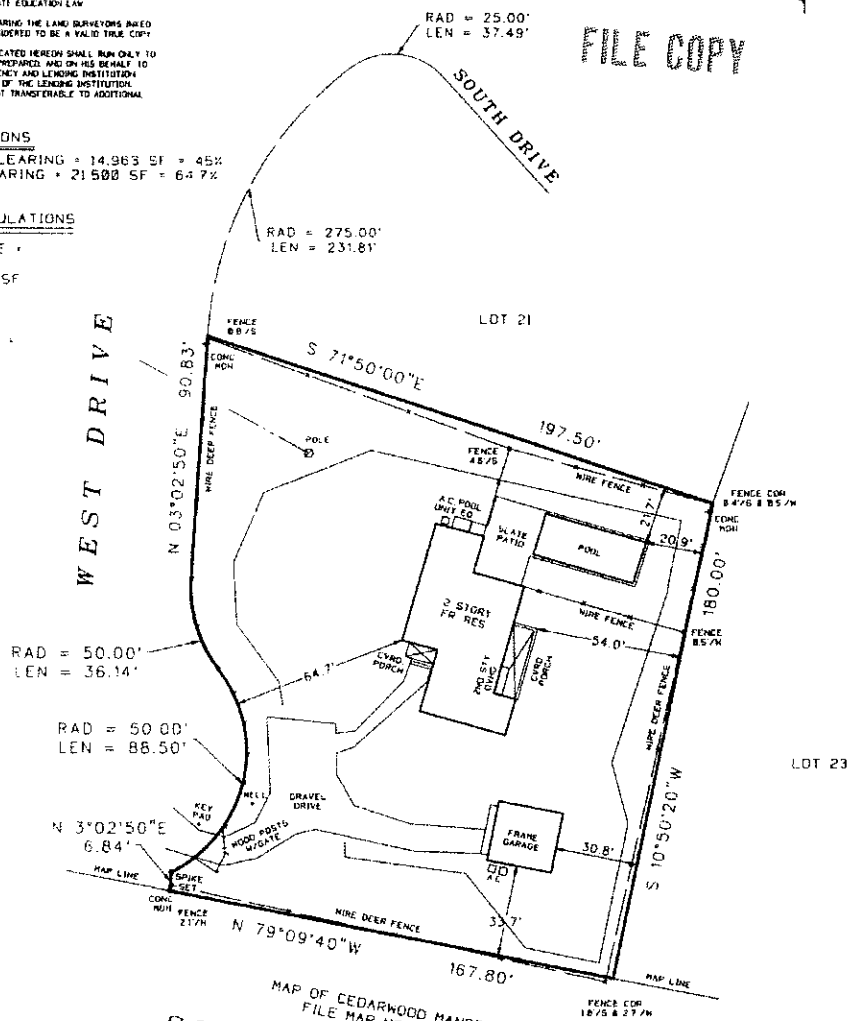

MAP OF CEDARWOOD MANOR
FILE MAP NO 5195

STOCK FARM LANE

CERTIFIED TO

John Bayne

22845-6191 122845-1A1

**SURVEYED BY:
BARYLSKI LAND SURVEYING
2320 MAIN ST. P.O. BOX 1302
NEWMAN VILLAGE CONDO.
BRIDGEHAMPTON, NEW YORK
(631-537-7944)
DECEMBER 4, 2013
6-23-2014: STAKEOUT
10-7-2014: UPDATE SURVEY**

