


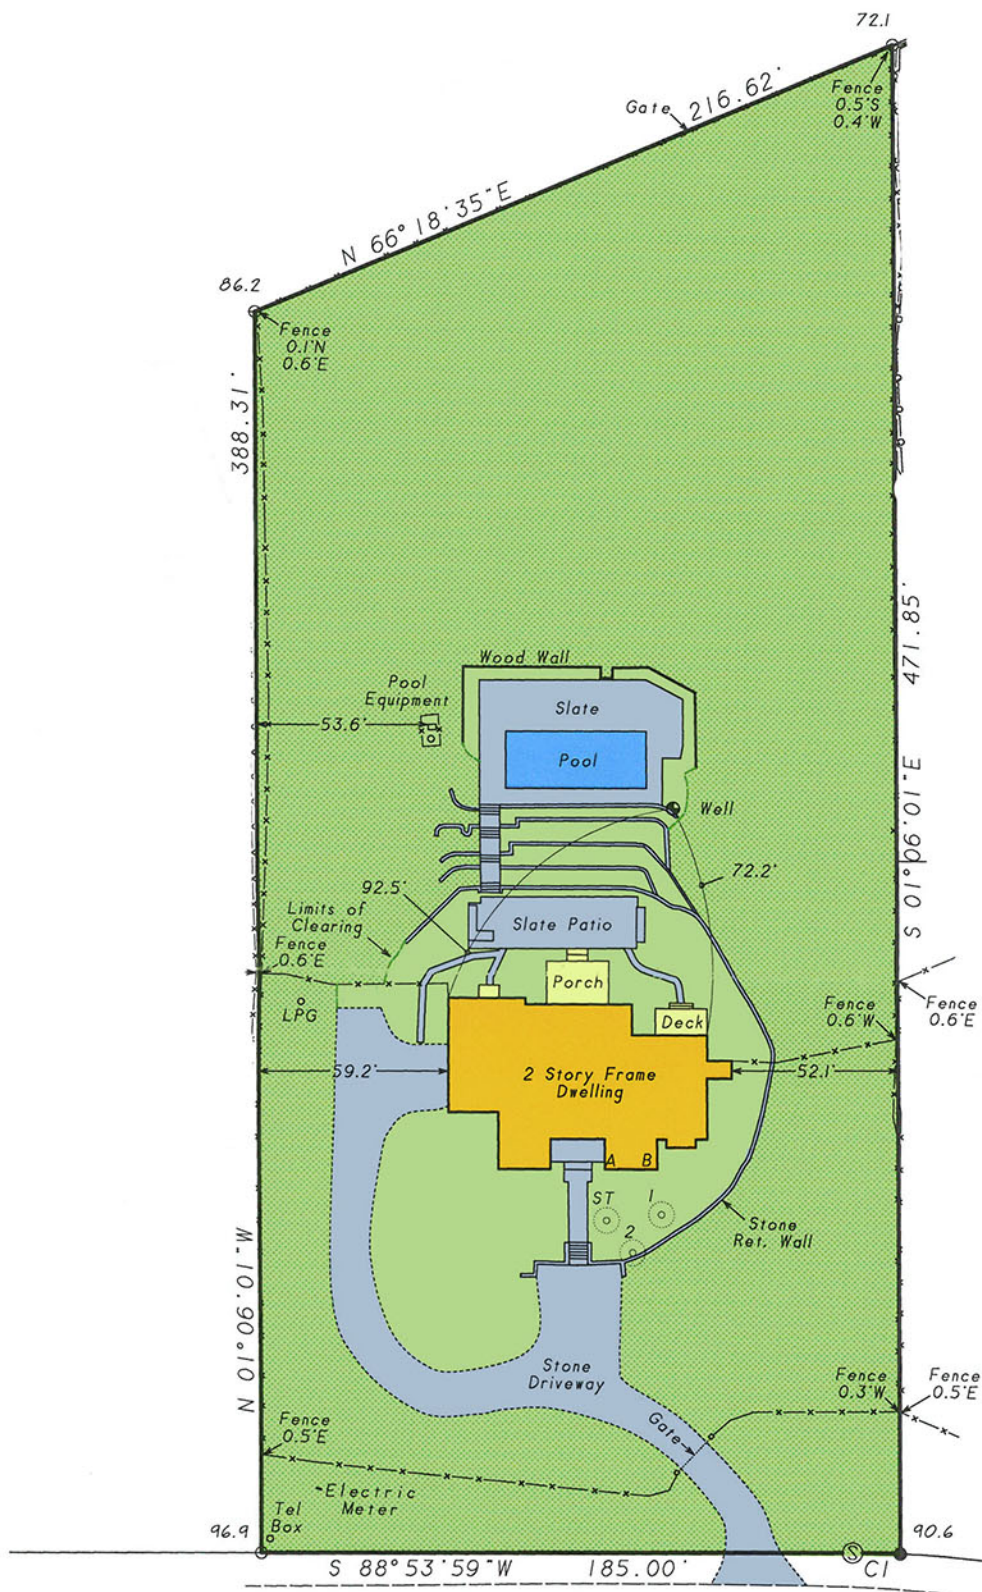

ARBOR PATH