


Map of Property

Situate
Wainscott, Town of East Hampton
Suffolk County, N.Y.

Scale: 1" = 50' (Notes)

Lot Area = 28,441 S.F. or 0.653 acres

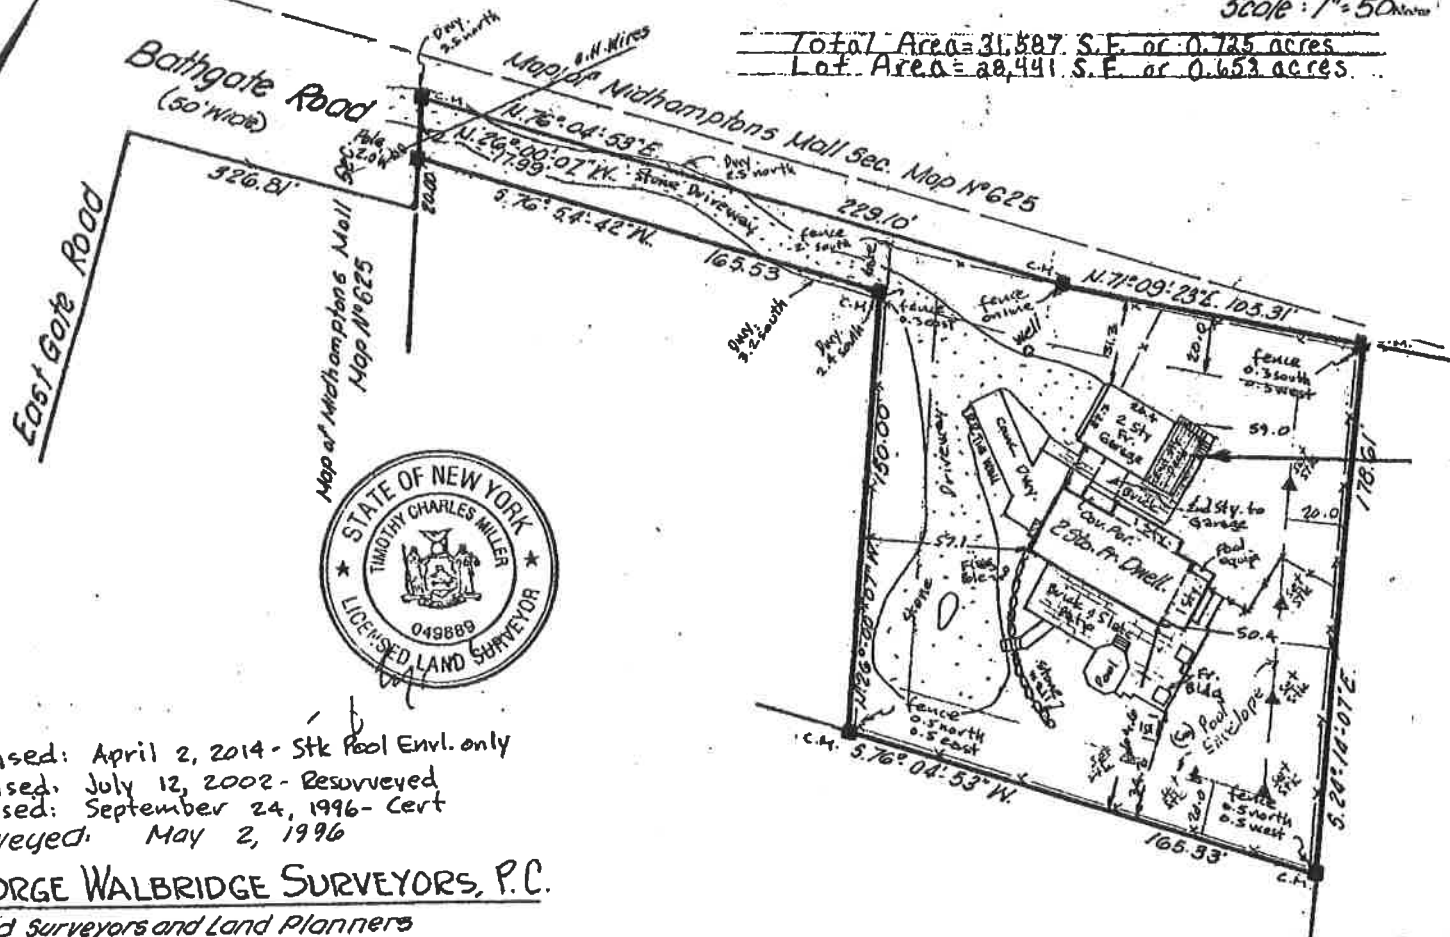

336 ft. Deck
under 2nd floor
Deck (KV)



Revised: April 2, 2014 - Stk Pool Envl. only
Revised: July 12, 2002 - Resurveyed
Revised: September 24, 1996 - Cert
Surveyed: May 2, 1996

GEORGE WALBRIDGE SURVEYORS, P.C.
Land Surveyors and Land Planners