



SHINNECOCK ROAD

QUOQUE ST.

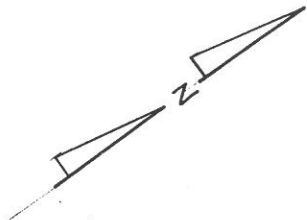

JOHN L. & MARILYN F. CASEY

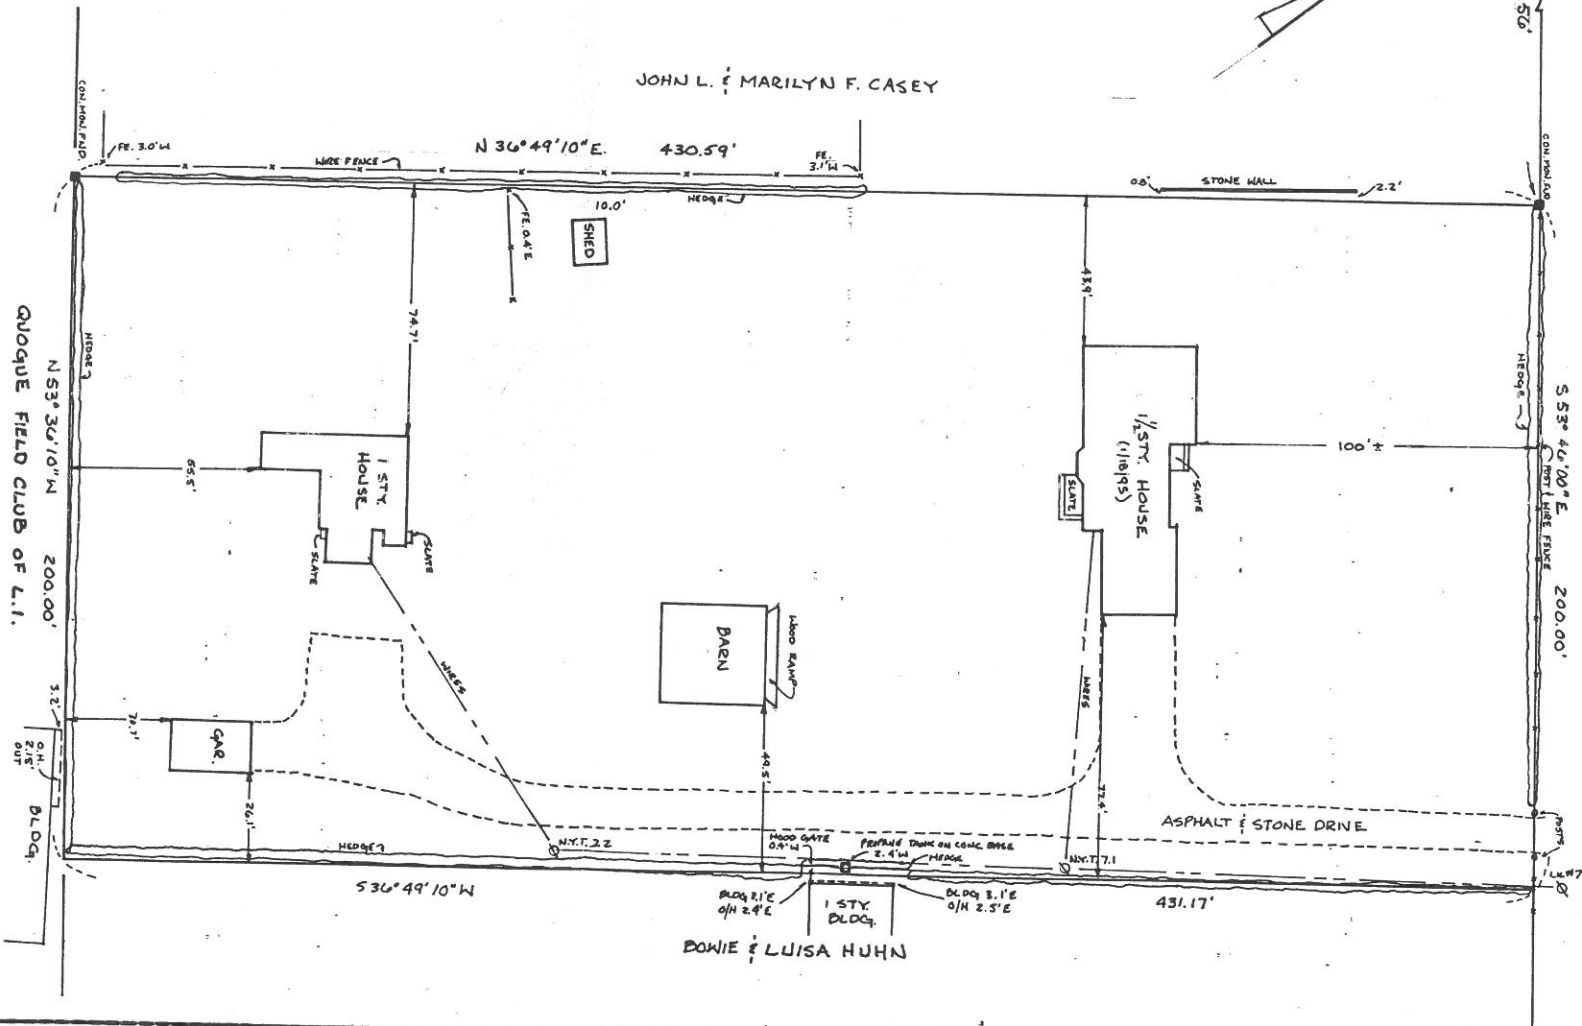

TAX MAP	
DISTRICT	0902
SECTION	010
BLOCK	02
LOT	17

UNAUTHORIZED ATTENTION OR ADDITION TO THIS SURVEY IS A VIOLATION OF SECTION 2709 OF THE NEW YORK STATE EDUCATION LAW.

COPIES OF THIS SURVEY MAP NOT BEARING THE LAND SURVEYOR'S INKED SEAL OR EMBOSSED SEAL SHALL NOT BE CONSIDERED TO BE A VALID TRUE COPY.

GUARANTEES INDICATED HEREON SHALL RUN ONLY TO THE PERSON FOR WHOM THE SURVEY IS PREPARED AND ON HIS BEHALF TO THE TITLE COMPANY, LENDING AGENCY AND TO THE ASSIGNEES OF THE SURVEY. GUARANTEES ARE NOT TRANSFERABLE TO ADDITIONAL INSTITUTIONS OR SUBSEQUENT OWNERS.

RECEIVED

JUN 20 1995

INC. VILLAGE OF QUOQUE, N.Y.

MAP OF PROPERTY
JUDITH MCLEAN BARRERO, MARY MCLEAN BULLY
& MALCOLM WALLACE MCLEAN
SITUATE
QUOQUE

TOWN OF SOUTHAMPTON - SUFFOLK COUNTY, N.Y.

SURVEYED OCT. 18, 1994 - SCALE: 1" = 40'

