


6782

P-12.5

MILDRED GULDI

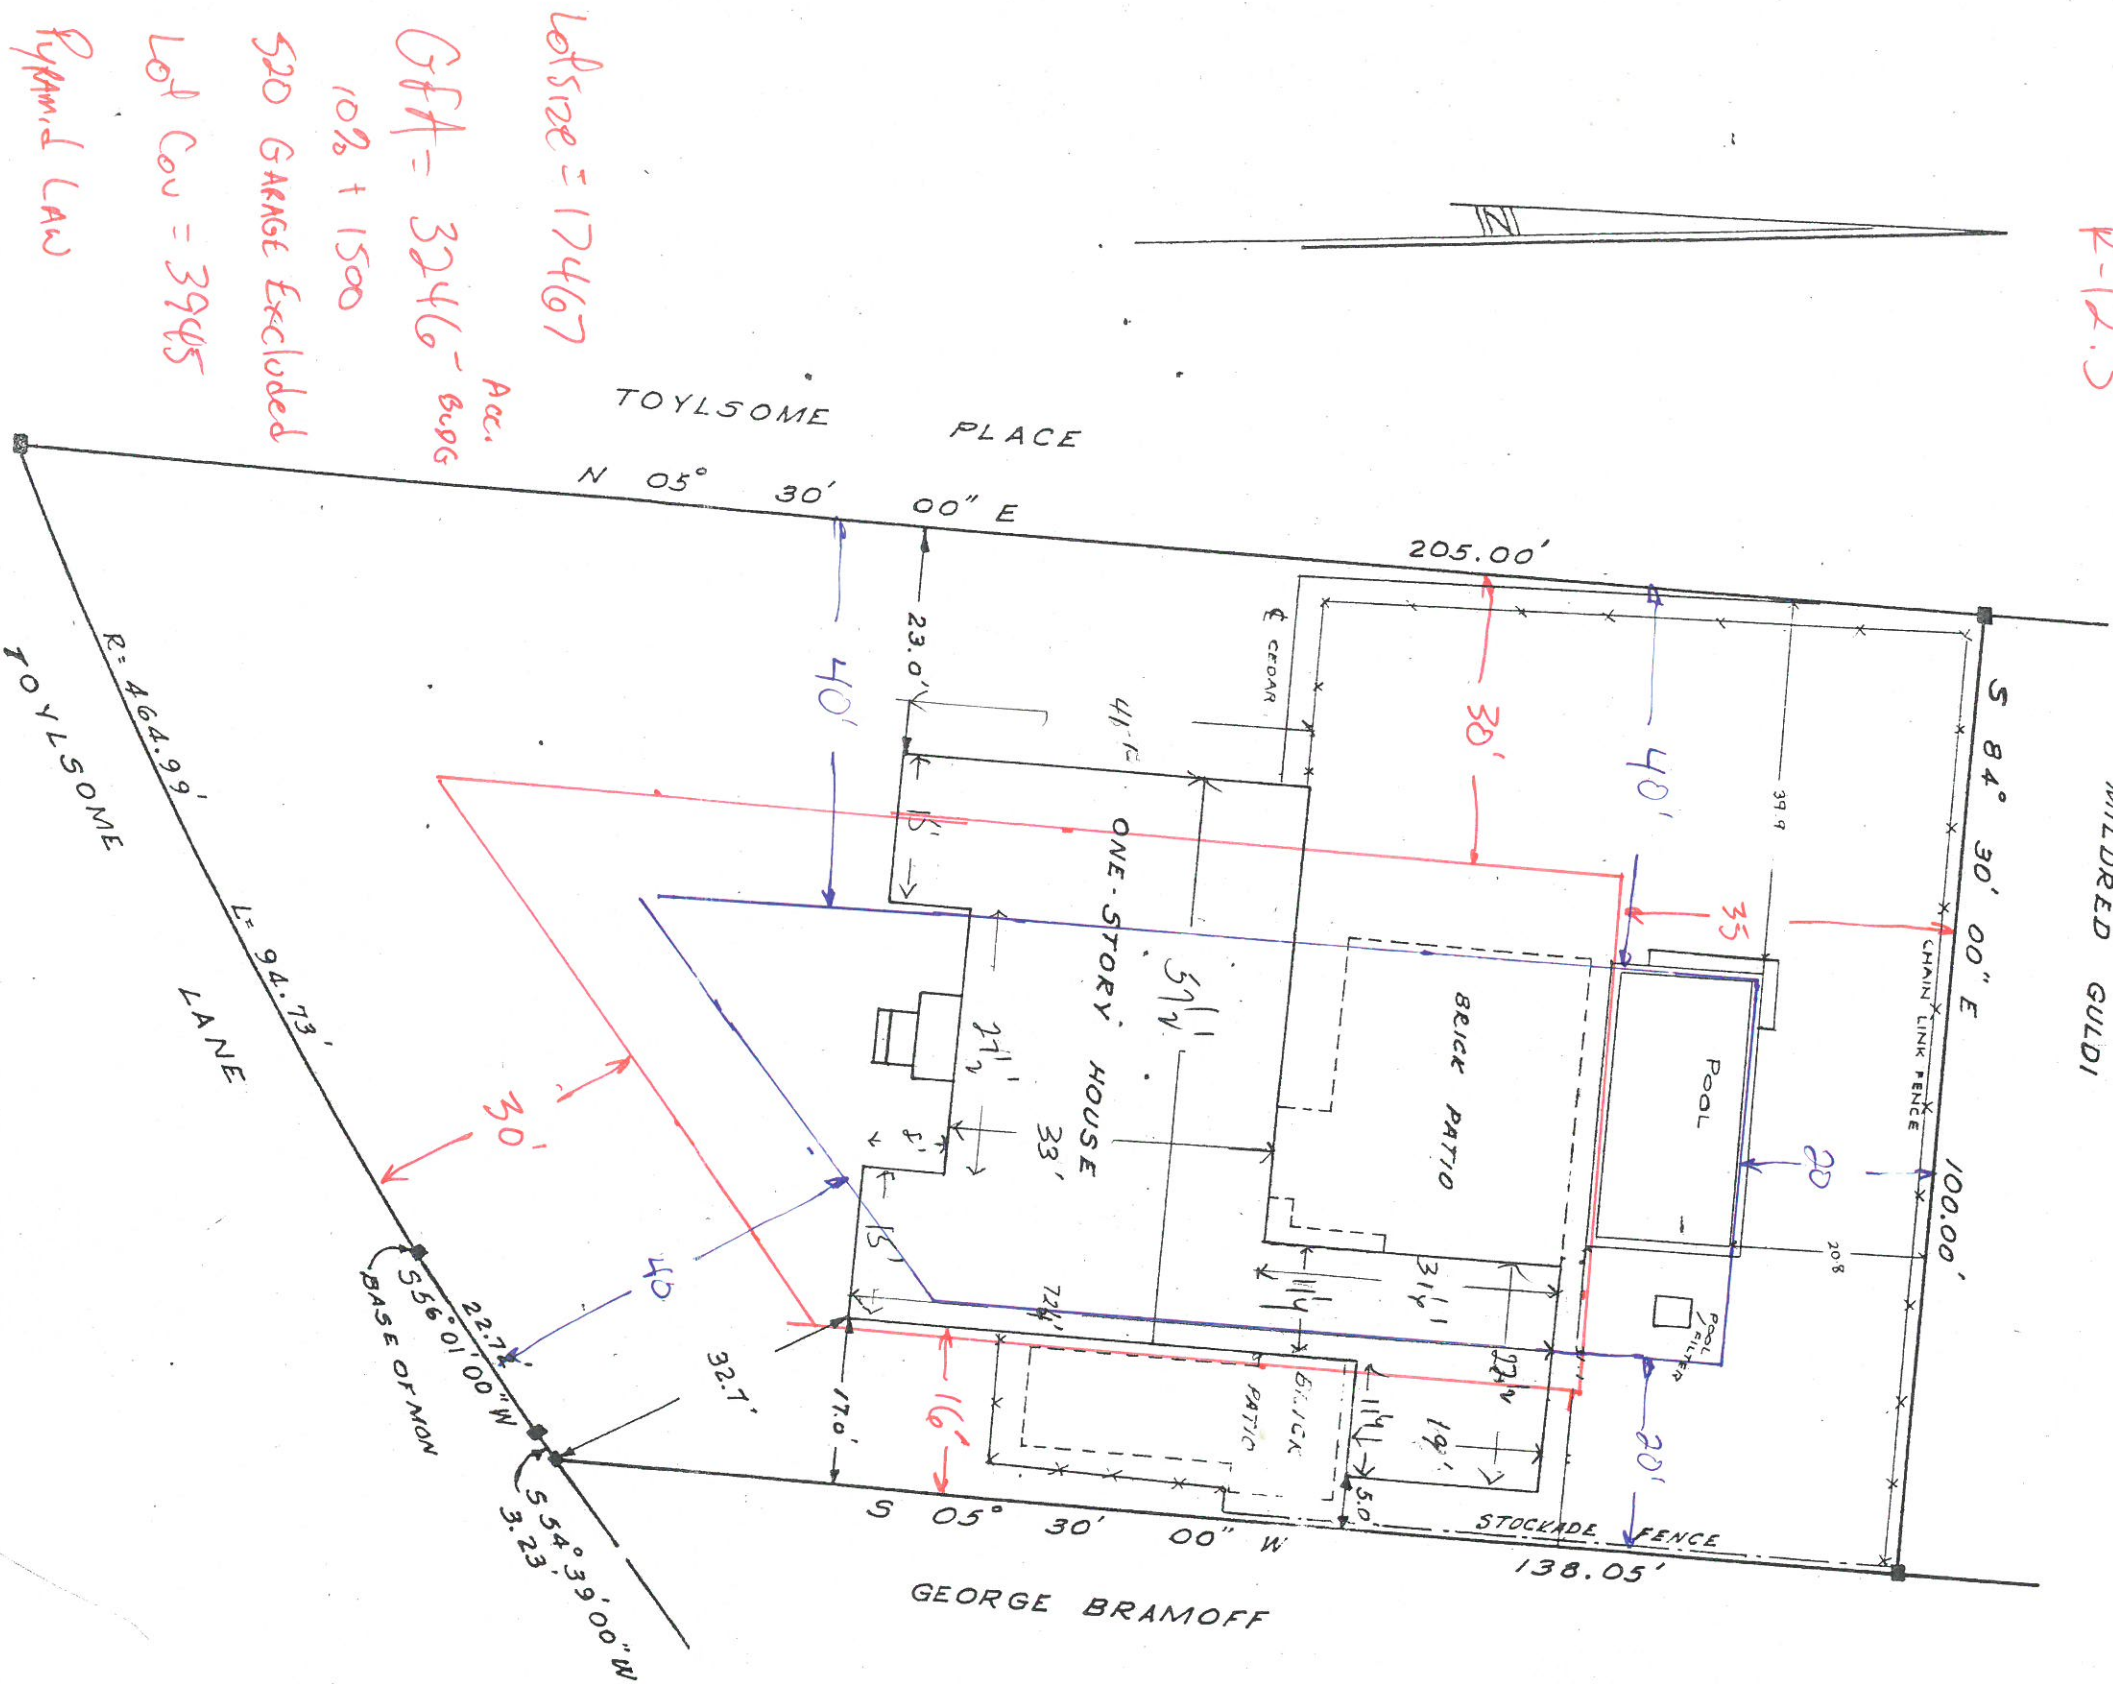

MAP OF PROPERTY
FOR

ROY PLUM

SITUATE

SURVEYED: JULY 8, 1981
(FINAL LOC ON POOL)

INC. VILLAGE OF SOUTHAMPTON
TOWN OF SOUTHAMPTON
SUFFOLK COUNTY, N.Y.

AREA = 0.401 ACRES

SCALE: 1" = 20'
MONUMENT

SQUIRES, HOLDEN, WEISENBACHER & SMITH
LAND SURVEYORS - ENGINEERS
SOUTHAMPTON, N.Y.

BK 487/6

BOOK PAGE
156 104
352 57

22
8/20

60'