


Karl W. Weisenbacher
Professional Land Surveyor
No. 36195
SQUIRES, LAND SURVEYORS & ENGINEERS
SOUTHAMPTON ~ NEW YORK



CERTIFIED TO:
FIRST AMERICAN TITLE INSURANCE COMPANY OF NEW YORK
NOTE: SANITARY SYSTEM LOCATIONS AS PER S.C.H.D. # 88-SH-792.

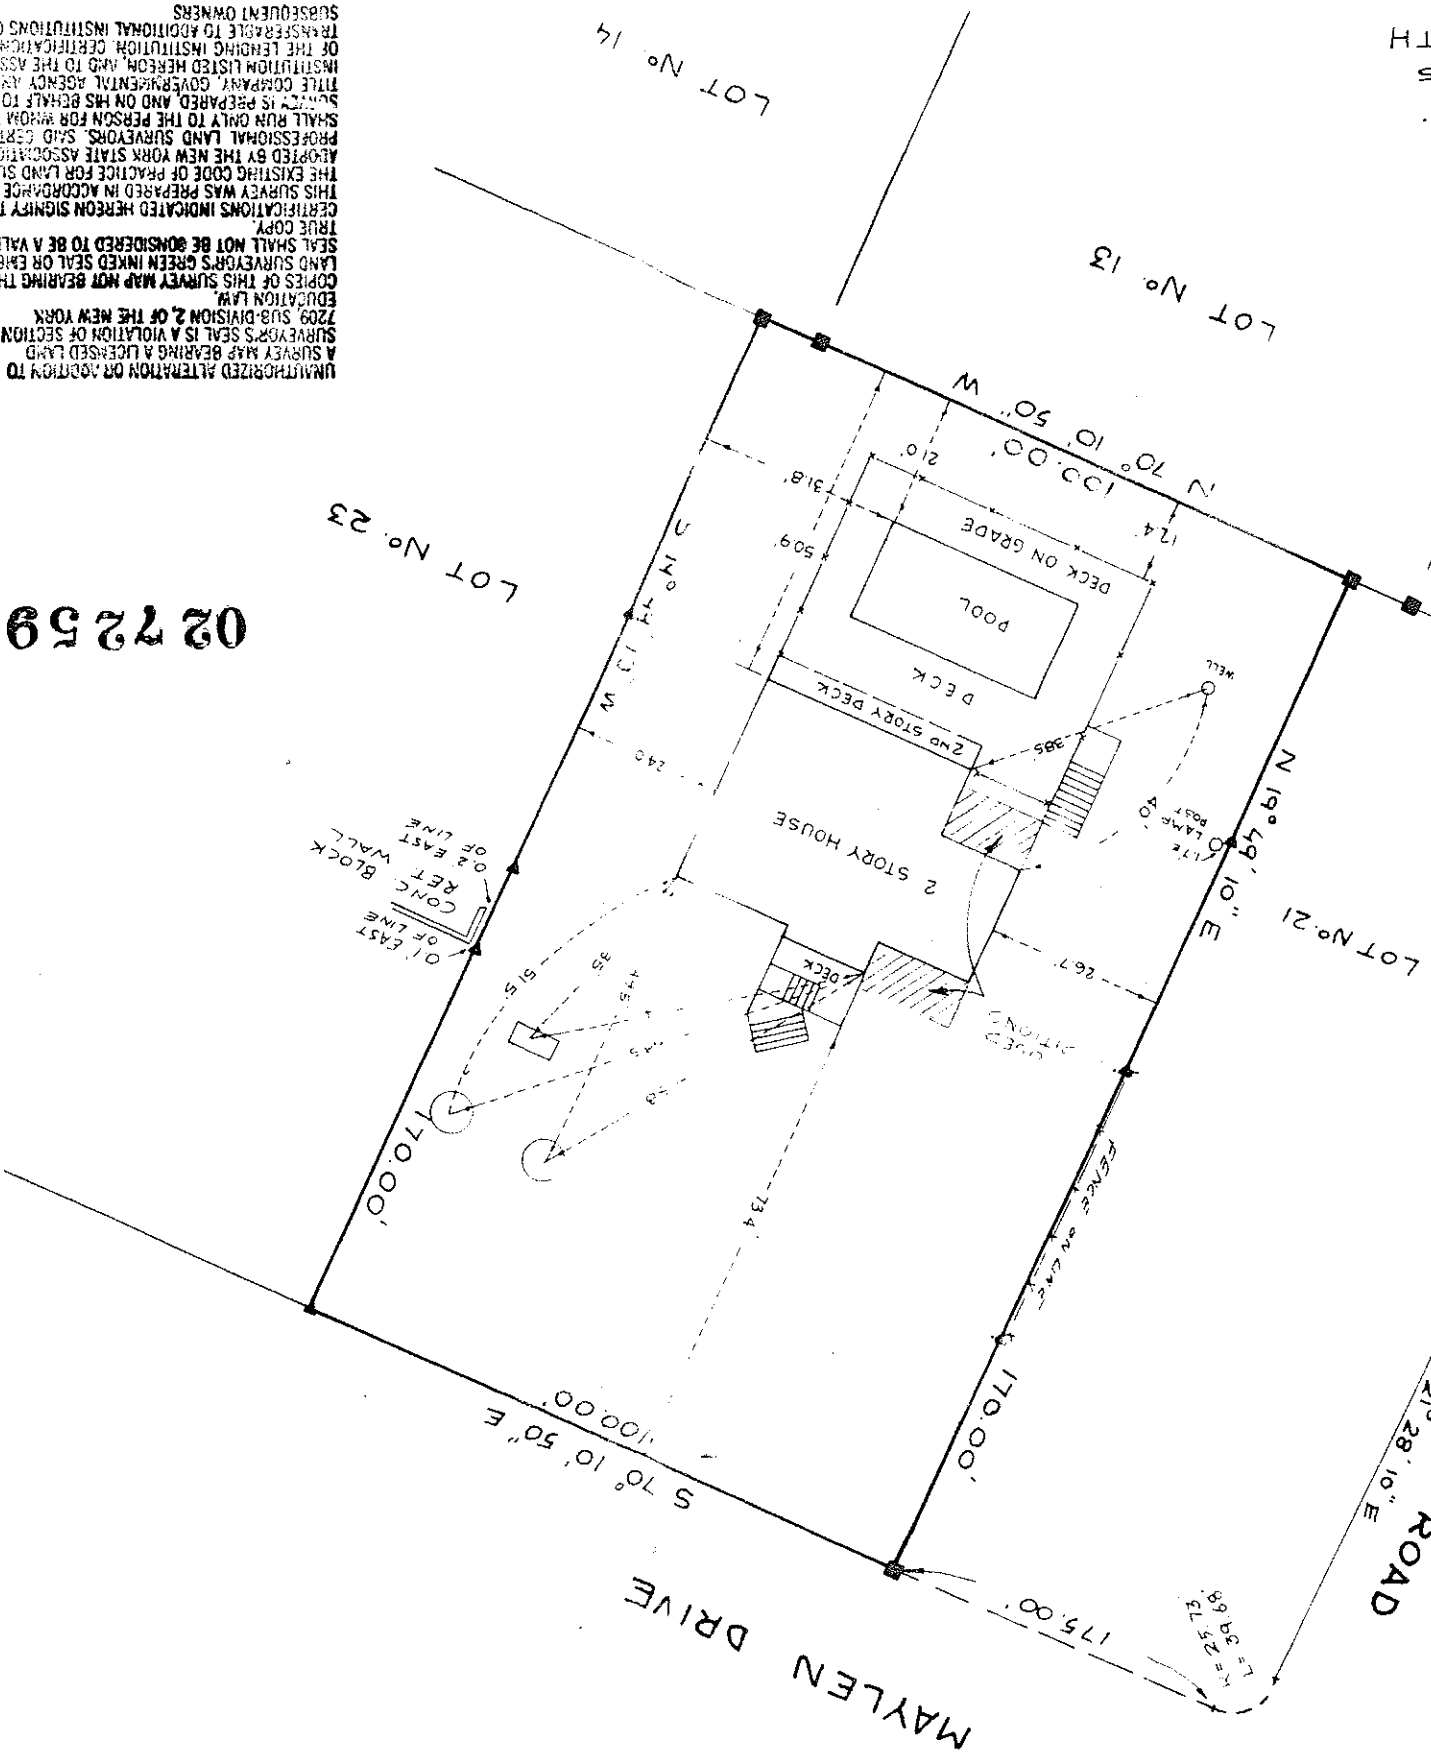

UNAUTHORIZED ALTERATION OR ADDITION TO A SURVEY MAP BEARING A LICENSED LAND SURVEYOR'S SEAL IS A VIOLATION OF SECTION 2209, SUB-DIVISION 2, OF THE NEW YORK EDUCATION LAW.
COPIES OF THIS SURVEY MAP NOT BEARING THE LAND SURVEYOR'S GREEN INKED SEAL OR EMBOSSED SEAL SHALL NOT BE CONSIDERED TO BE A VALID TRUE COPY.
CERTIFICATIONS INDICATED HEREON SIGNIFY THAT THIS SURVEY WAS PREPARED IN ACCORDANCE WITH THE EXISTING CODE OF PRACTICE FOR LAND SURVEYS ADOPTED BY THE NEW YORK STATE ASSOCIATION OF PROFESSIONAL LAND SURVEYORS, SAID CERTIFICATIONS SHALL RUN ONLY TO THE PERSON FOR WHOM THE SURVEY IS PREPARED, AND ON HIS BEHALF TO THE TITLE COMPANY, GOVERNMENT AGENCY AND LENDING INSTITUTION LISTED HEREON, AND TO THE ASSIGNEES OF THE LENDING INSTITUTION. CERTIFICATIONS ARE NOT TRANSFERABLE TO ADDITIONAL INSTITUTIONS OR SUBSEQUENT OWNERS.

SHINNECOCK HILLS
TOWN OF SOUTHAMPTON
SUFFOLK COUNTY, N.Y.
AREA = 17,000 SQ. FT.
0.390 ACRES
SCALE 1" = 30'

MAP OF LOT No. 22
SUBDIVISION MAP OF
ENGLISH MANOR KNOLLS
FOR
GUNTHER H. RICHTER
RICARDO & ALVAREZ
SITUATE

SUFFOLK COUNTY TAX MAP
DISTRICT 0900
SECTION 232.000
BLOCK 03000
PARCEL 014002