



BEARING SCHEDULE		
LTR	BEARINGS	DISTANCES
A	N 09°17'10" E	7.58'
B	N 82°32'39" W	48.05'
C	N 81°18'28" W	54.06'
D	S 70°59'39" W	15.09'
E	N 56°18'32" W	13.74'
F	N 84°37'00" W	13.15'
G	N 82°44'33" W	28.18'
H	S 80°34'20" W	50.37'

LOT COVERAGE AS OF 6/26/14


LOT AREA= 61,267 SQ.FT.

HOUSE, GARAGE, POOL, POOL HSE.,
SPA, PORCH, PATIO, A/C UNITS,
PERGOLA, TRELLIS, CONC. SLAB,
STEPS, CAR PORT, GENERATOR,
ROOF OVERHANGS & STONE WALK
= 13,475 SQ.FT.

$$= \frac{3,475 \text{ SQ.FT.}}{61,267 \text{ SQ.FT.}} \times 100 = 22.0\%$$

NOTE:

WETLANDS ON PROPERTY
IF ANY NOT LOCATED.

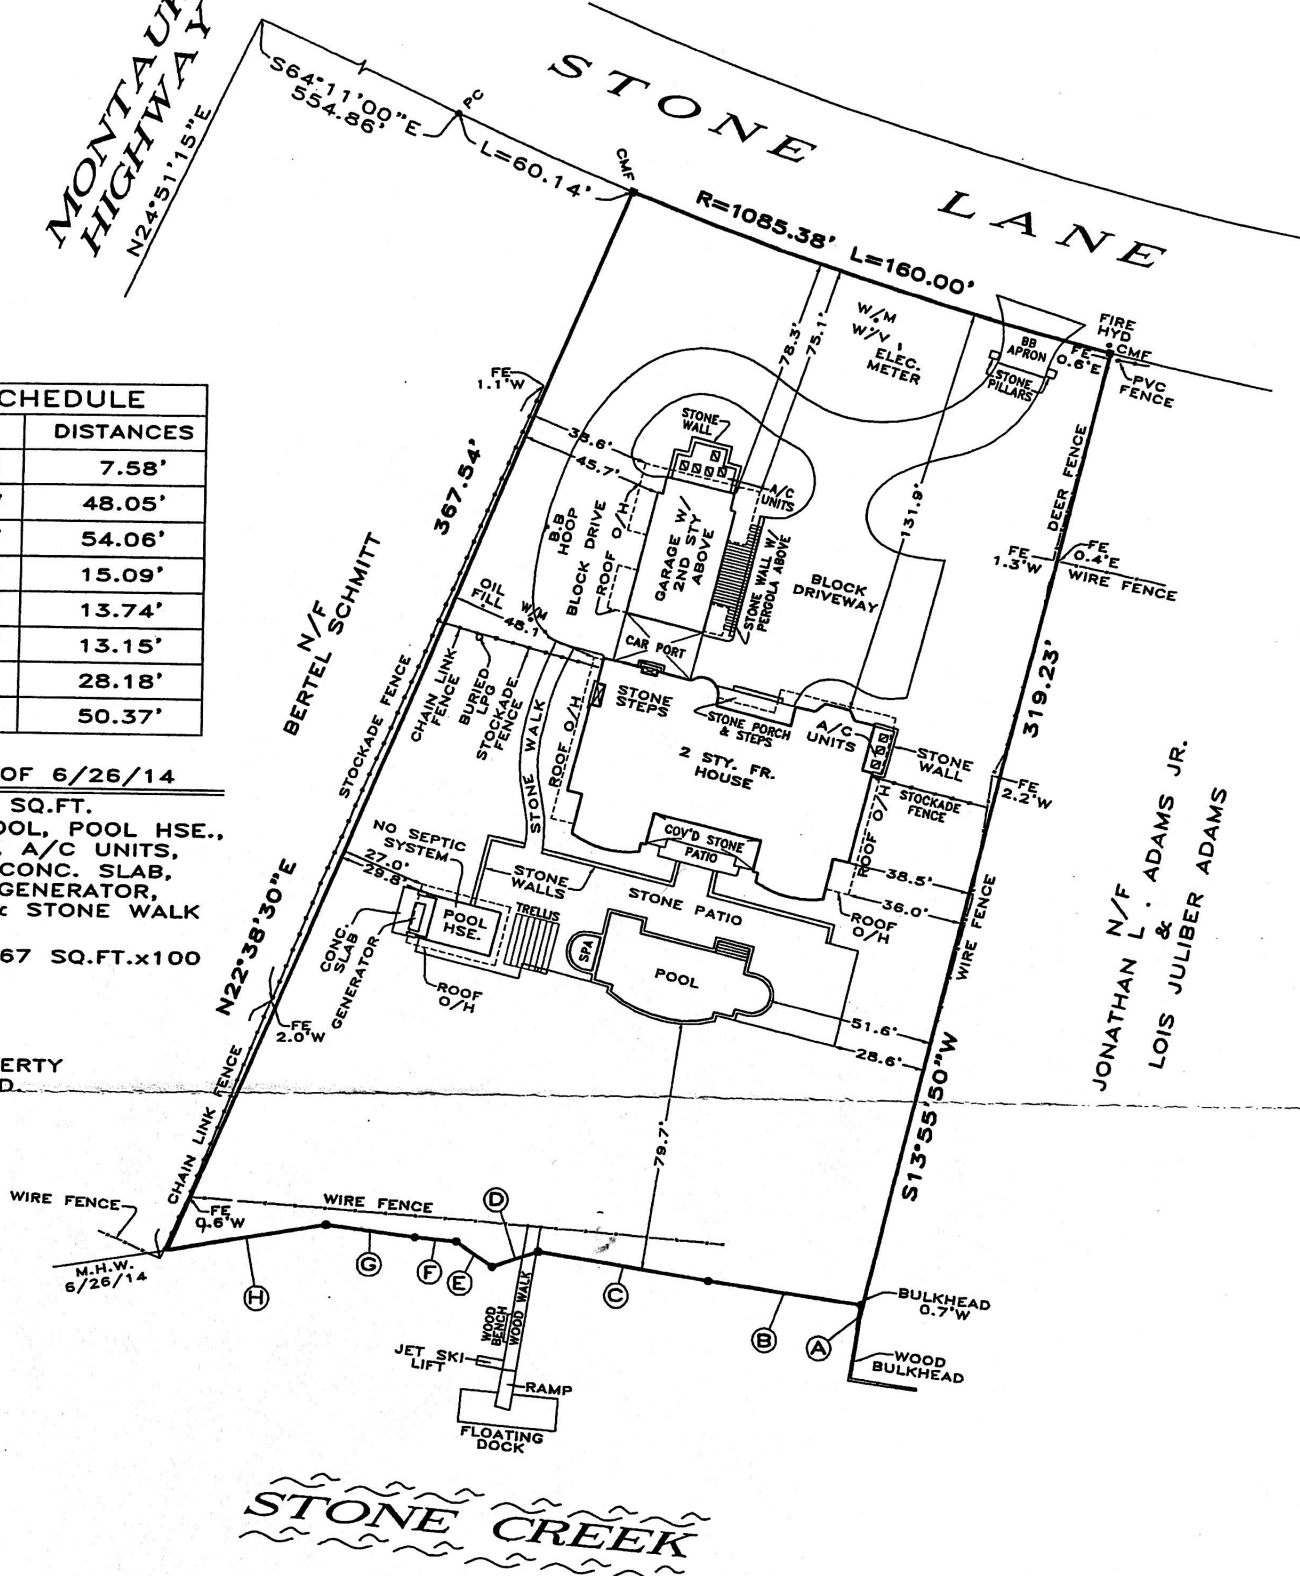

JONATHAN N/F
L. ADAMS JR.
&
LOIS JULIBER ADAMS

D36-E-16

TAX MAP

MAP OF PROPERTY